


Transfer Page 88 LANDS

SW 1/4 SEC. 20-77-2
SCALE: 1" = 200'

21.50 CH = 1417
21.73 CH = 1434.58

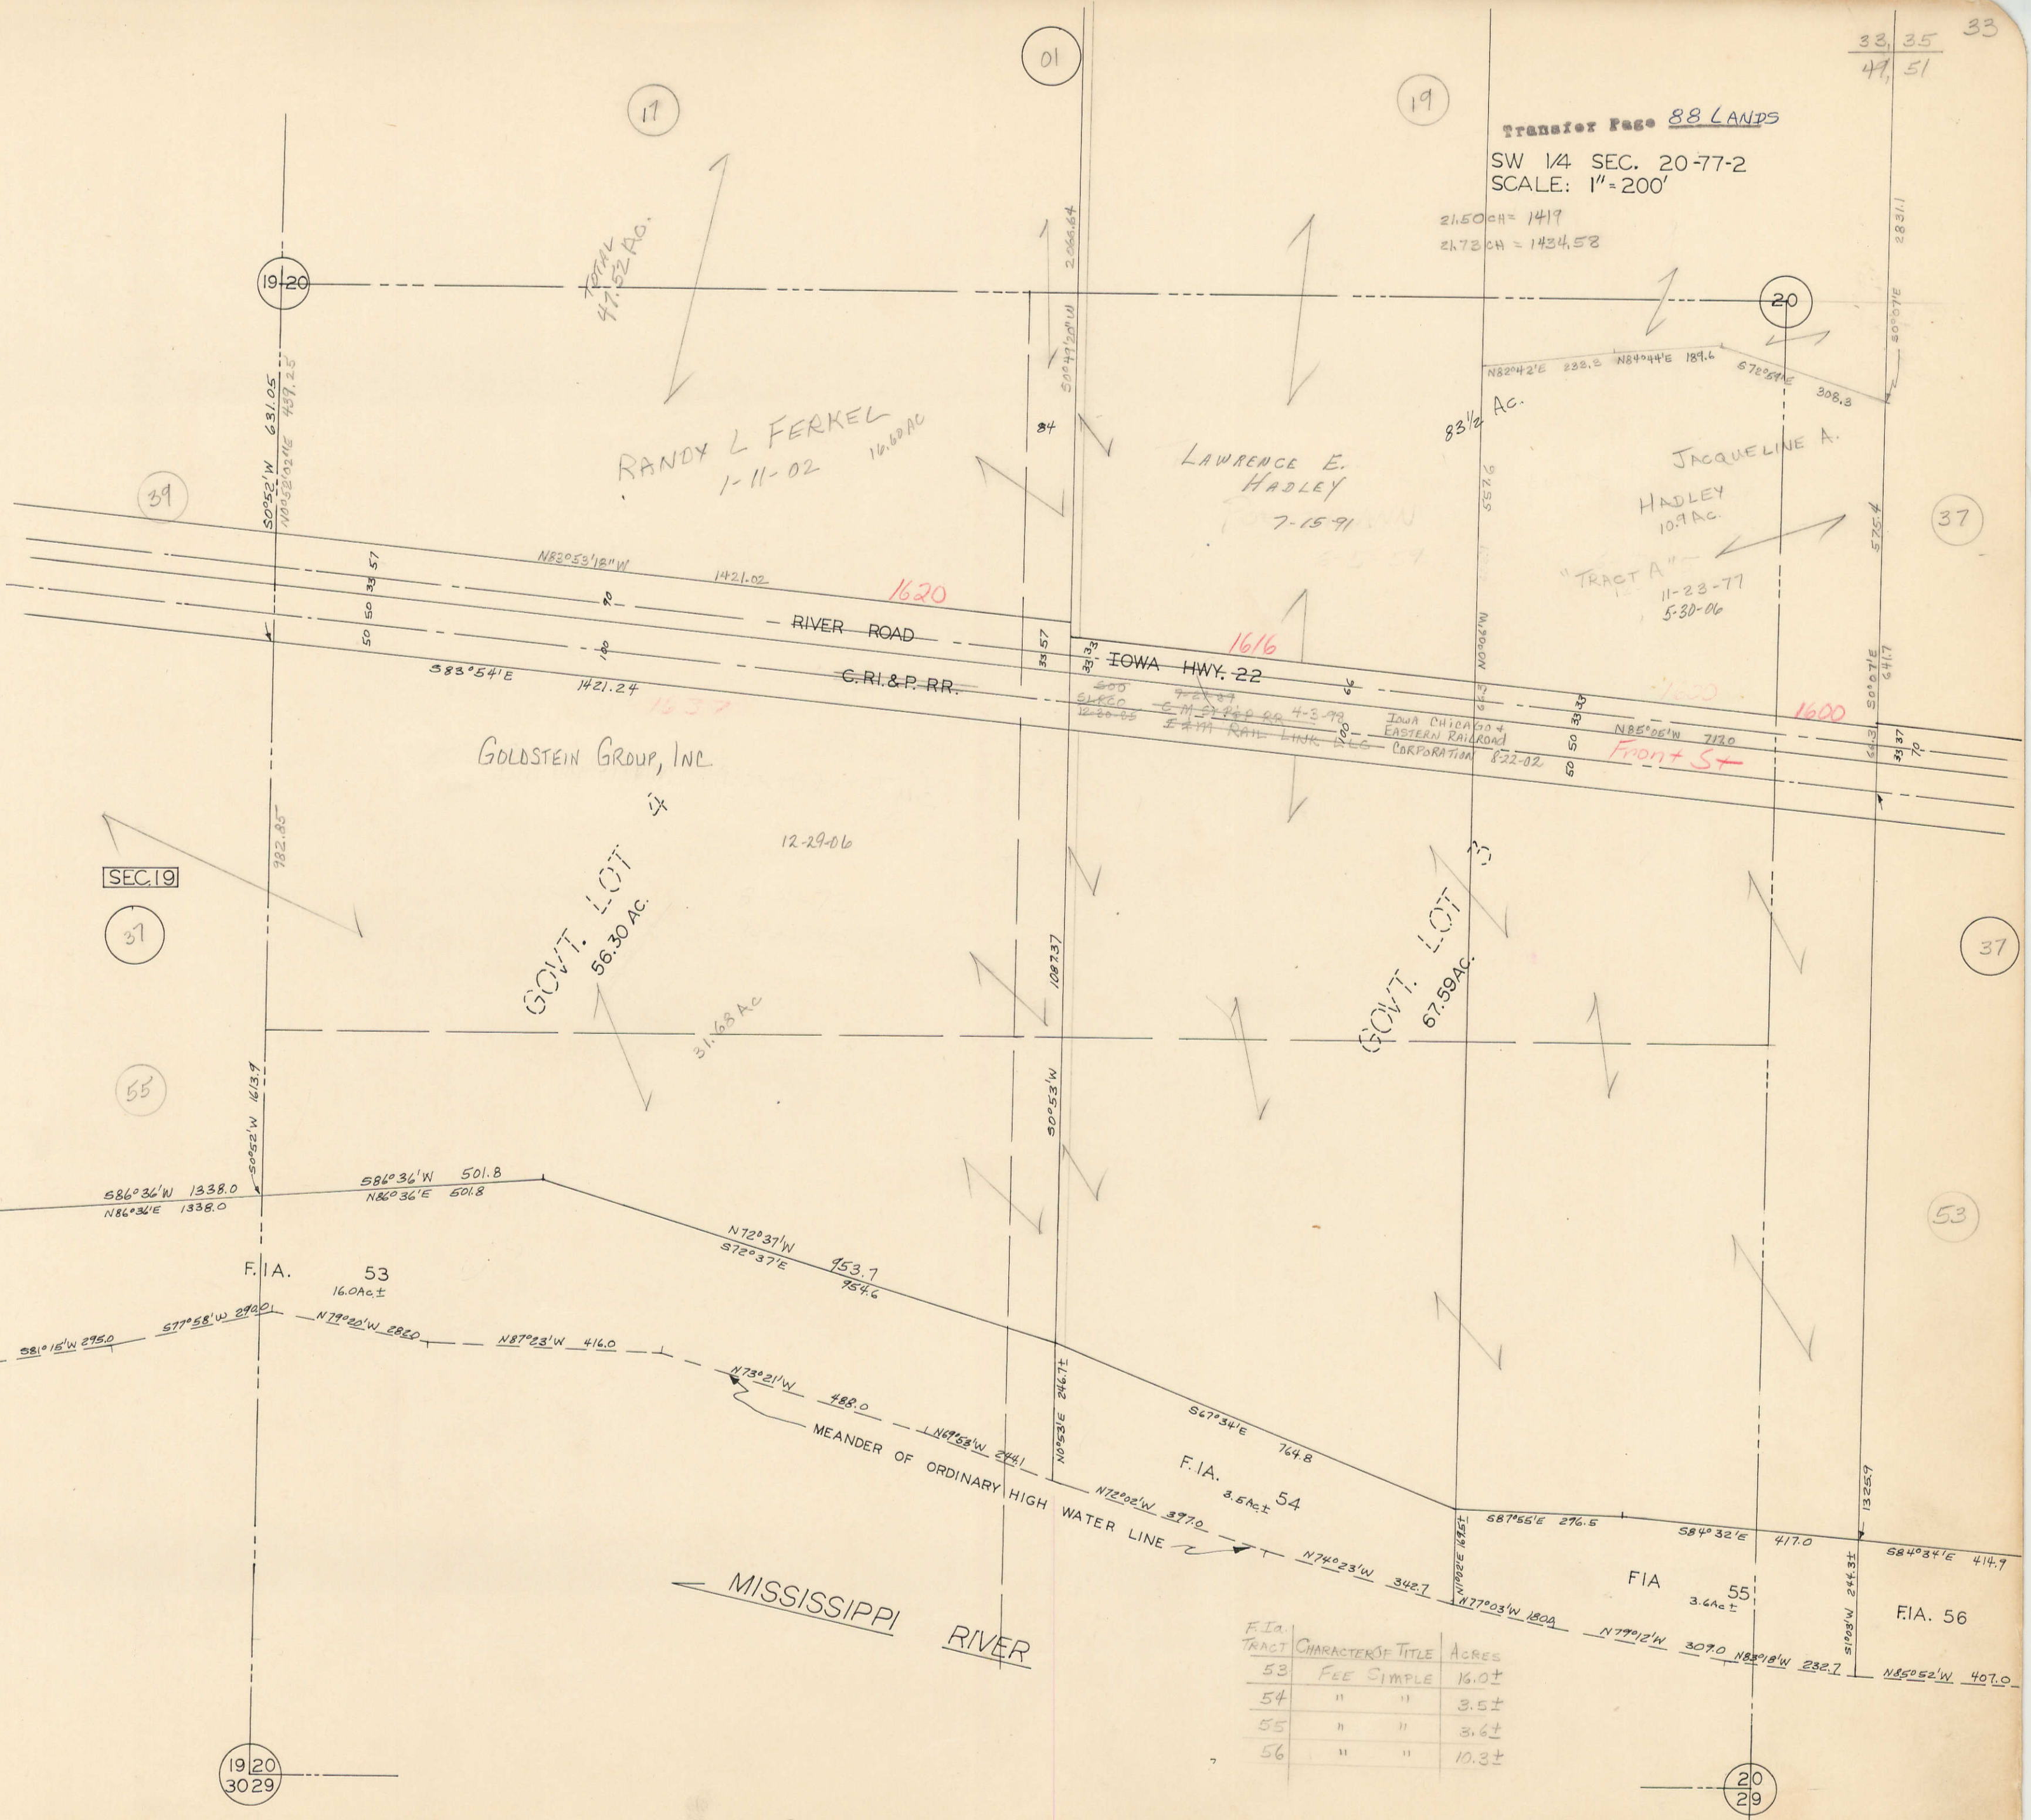

TOTAL 47.52 AC.
RANDY L FERKEL
1-11-02 16.60 AC

LAWRENCE E. HADLEY
7-15-91

JACQUELINE A. HADLEY
10.9 AC.
"TRACT A"
11-23-77
5-30-06

GOLDSTEIN GROUP, INC.
ix
12-29-06

GOVT. LOT
56.30 AC

GOVT. LOT
67.59 AC

SEC. 19

37

55

37

53

19 20
30 29

20
29

F.I.A.	TRACT	CHARACTER OF TITLE	ACRES
53		FEE SIMPLE	16.0±
54		" "	3.5±
55		" "	3.6±
56		" "	10.3±

MISSISSIPPI RIVER

MEANDER OF ORDINARY HIGH WATER LINE

586°36'W 1338.0
N86°34'E 1338.0

586°36'W 501.8
N86°36'E 501.8

N72°37'W 453.7
S72°37'E 754.6

F.I.A. 53
16.0 AC ±

F.I.A. 54
3.5 AC ±

F.I.A. 55
3.6 AC ±

F.I.A. 56