


(23)

(1615)

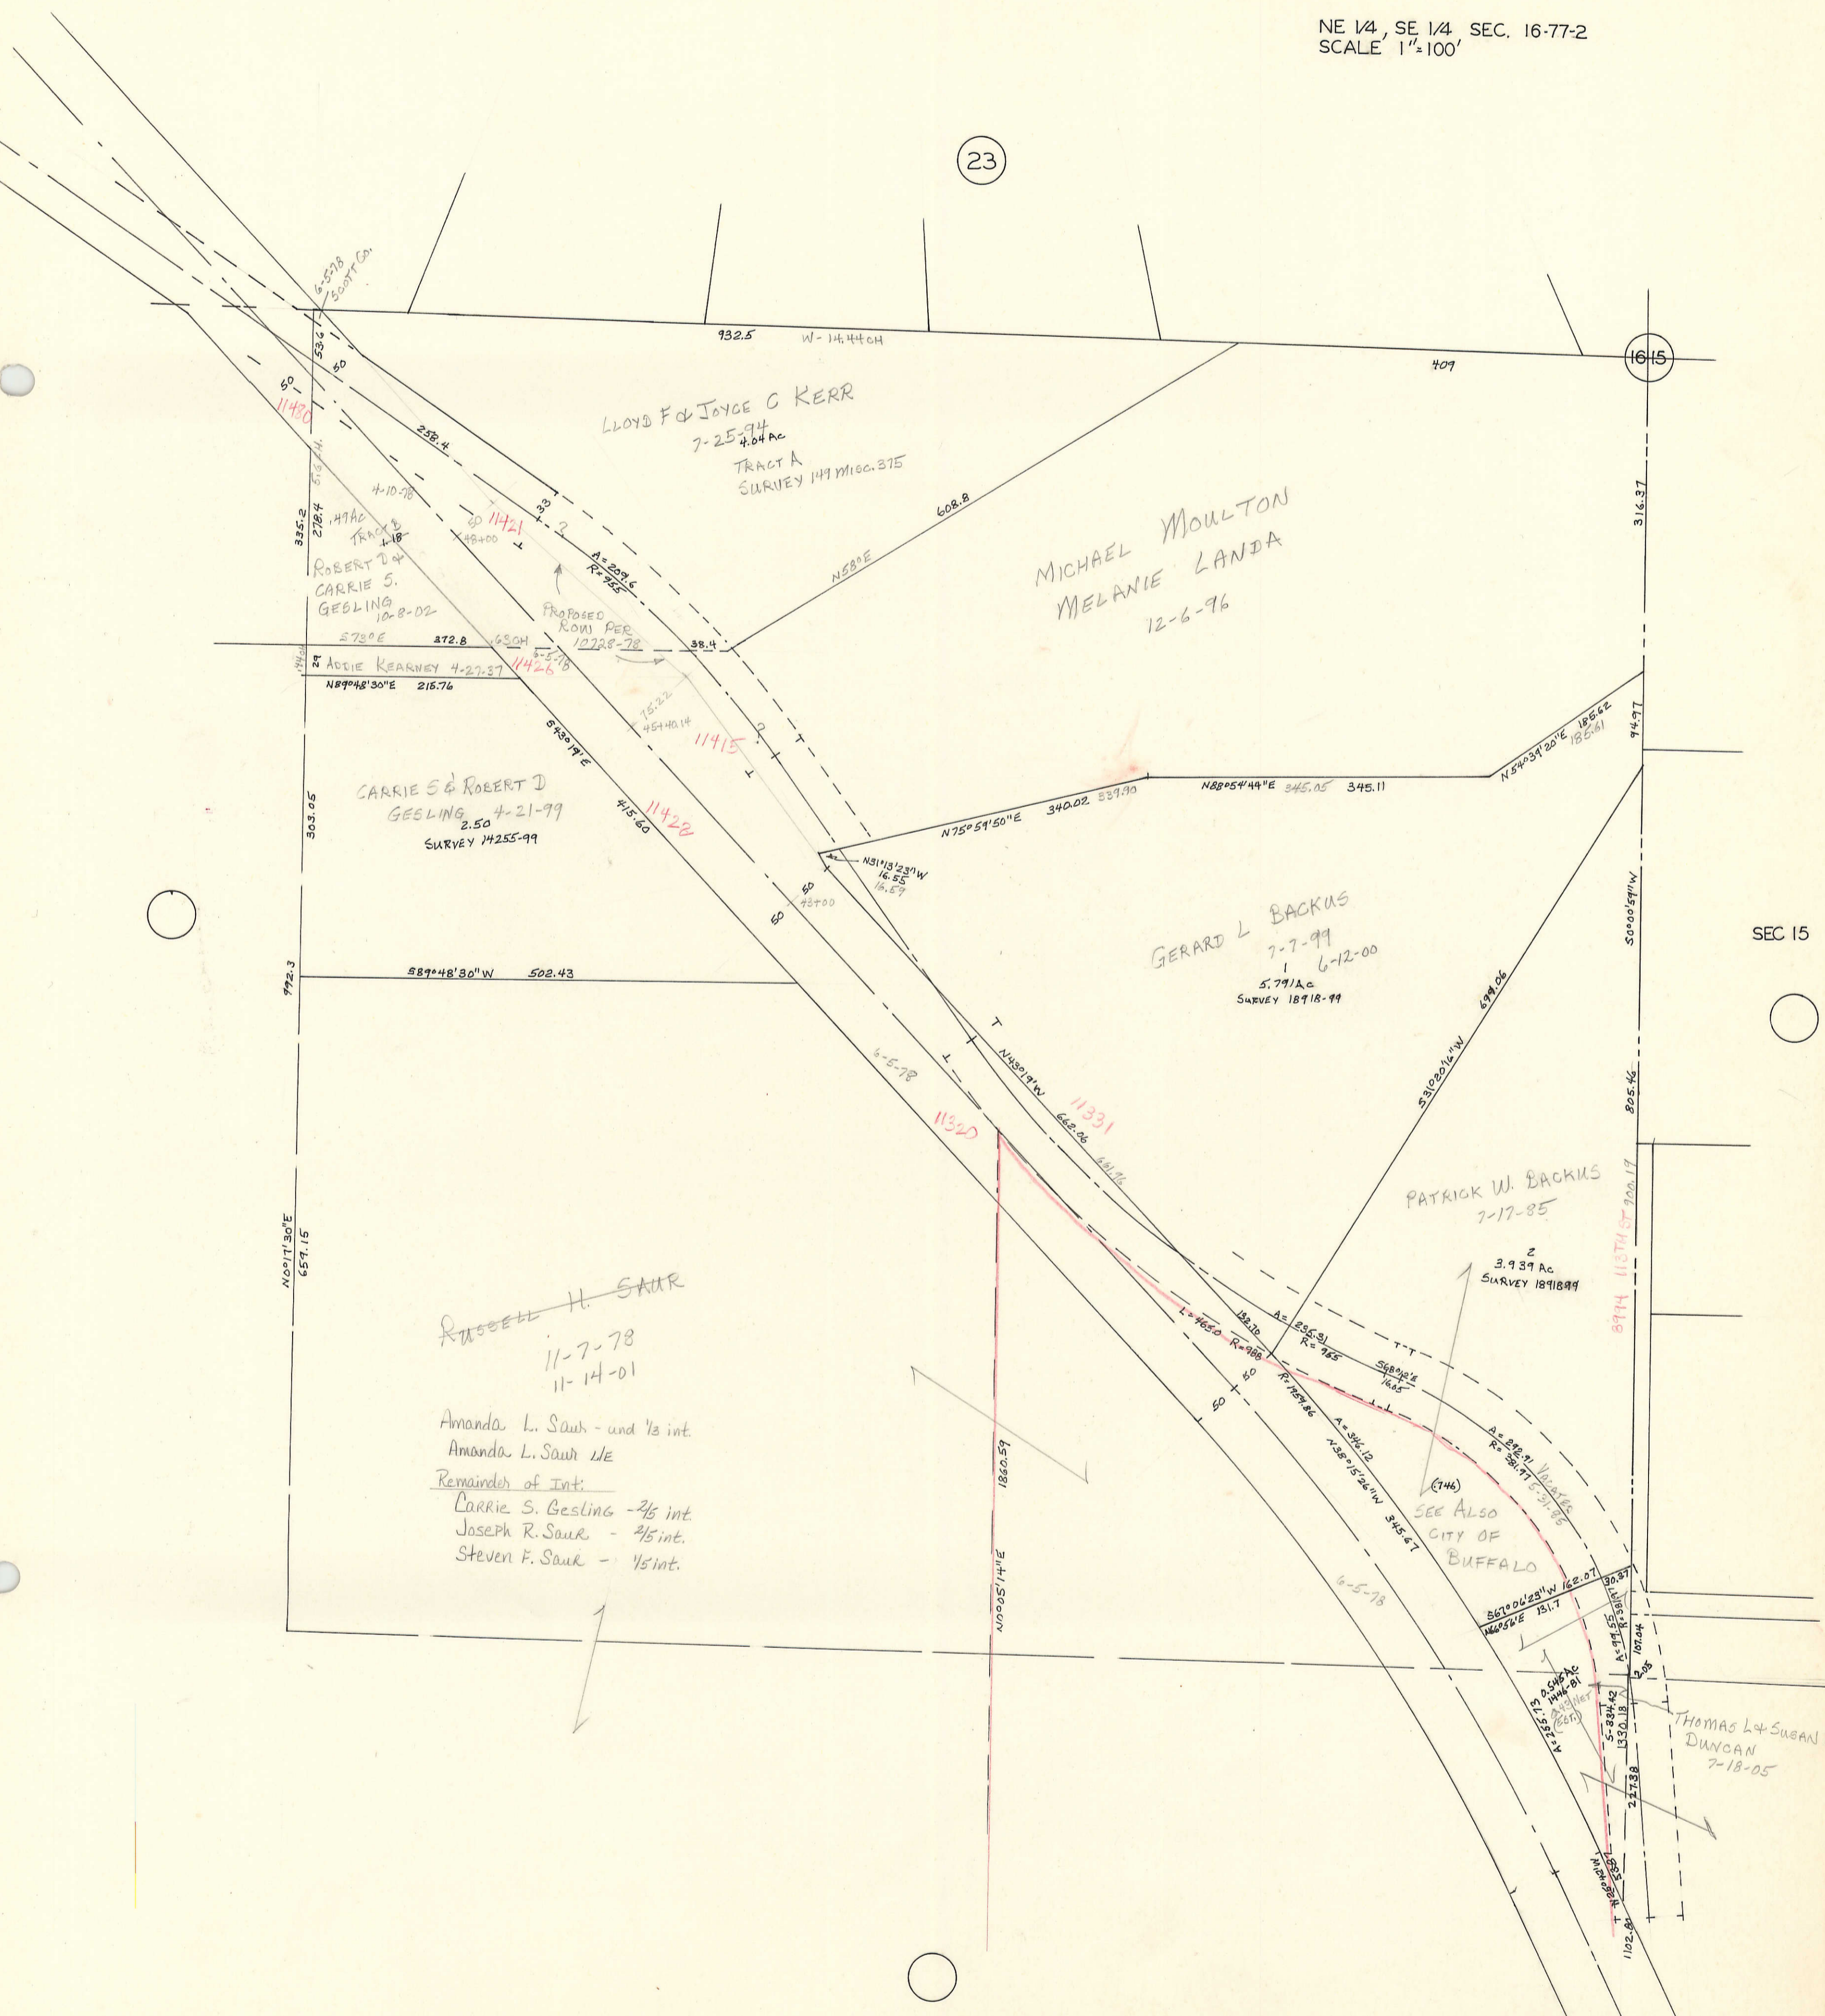

LLOYD F & JOYCE C KERR  
7-25-94  
4.04 Ac  
TRACT A  
SURVEY 149116cc.375

MICHAEL MOULTON  
MELANIE LANDA  
12-6-96

ROBERT D &  
CARRIE S. GESLING  
10-8-02

ADDIE KEARNEY 4-27-37  
N89°48'30"E 216.76

CARRIE S & ROBERT D  
GESLING 4-21-99  
2.50  
SURVEY 14255-99

GERARD L BACKUS  
7-7-99  
6-12-00  
5.791 Ac  
SURVEY 18718-99

PATRICK W. BACKUS  
7-17-85  
3.939 Ac  
SURVEY 1891899

~~RUSSELL H. SAUR~~  
11-7-78  
11-14-01

Amanda L. Saur - and 1/3 int.  
Amanda L. Saur 1/4  
Remainder of Int.  
Carrie S. Gesling - 2/5 int.  
Joseph R. Saur - 2/5 int.  
Steven F. Saur - 1/5 int.

SEE ALSO  
CITY OF  
BUFFALO

THOMAS L & SUEAN R  
DUNCAN  
7-18-05

SEC 15