


NW 1/4 NW 1/4 SECTION 16

SCALE: 1" = 100'

Transfer Page 84 LANDS

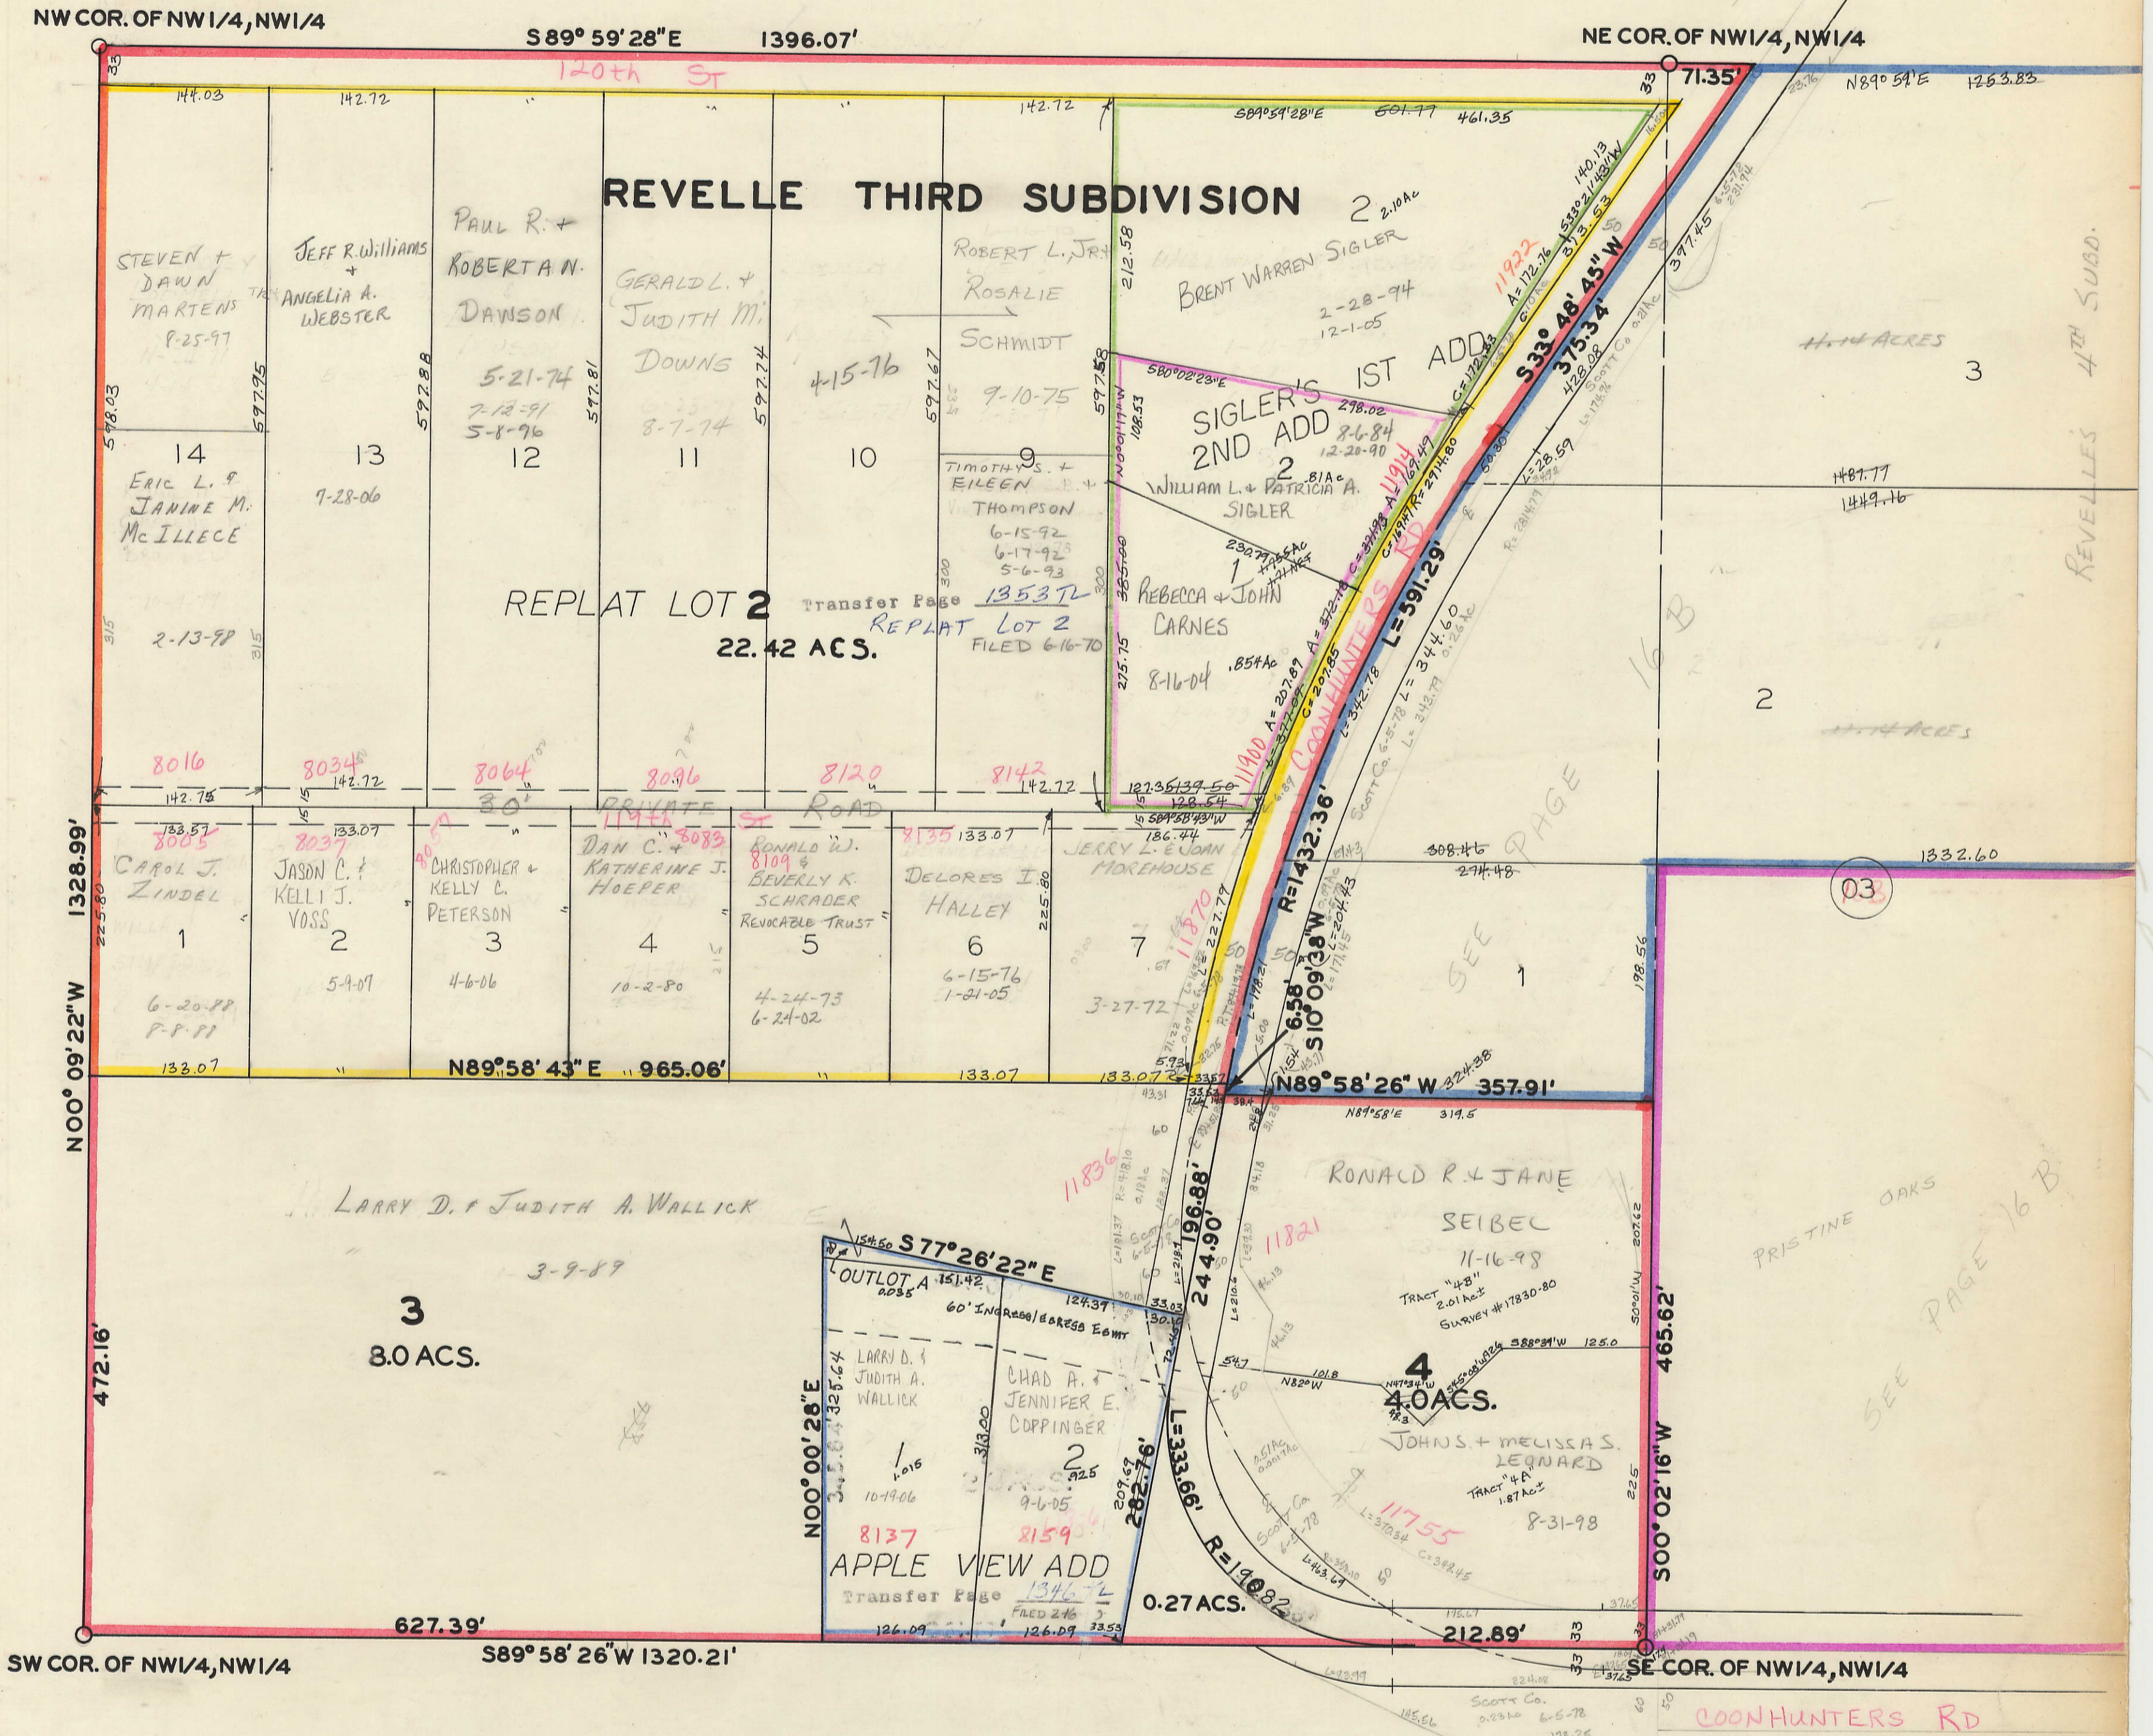

REVELLE THIRD SUBDIVISION

REPLAT LOT 2
22.42 ACS.

Transfer Page 1353 TL
REPLAT LOT 2
FILED 6-16-70

SIGLER'S 1ST ADD
2.10 AC

SIGLER'S 2ND ADD

LARRY D. & JUDITH A. WALLICK
3

APPLE VIEW ADD
0.27 ACS.

RONALD R. & JANE SEIBEL
4
4.0 ACS.

PRISTINE OAKS
SEE PAGE 16 B

COONHUNTERS RD

REVELLES 4TH SUBD.

SEE PAGE

03

SEE PAGE 16 B