


SEC. 4

NW 1/4 SEC. 9-77-2
SCALE: 1" = 200'

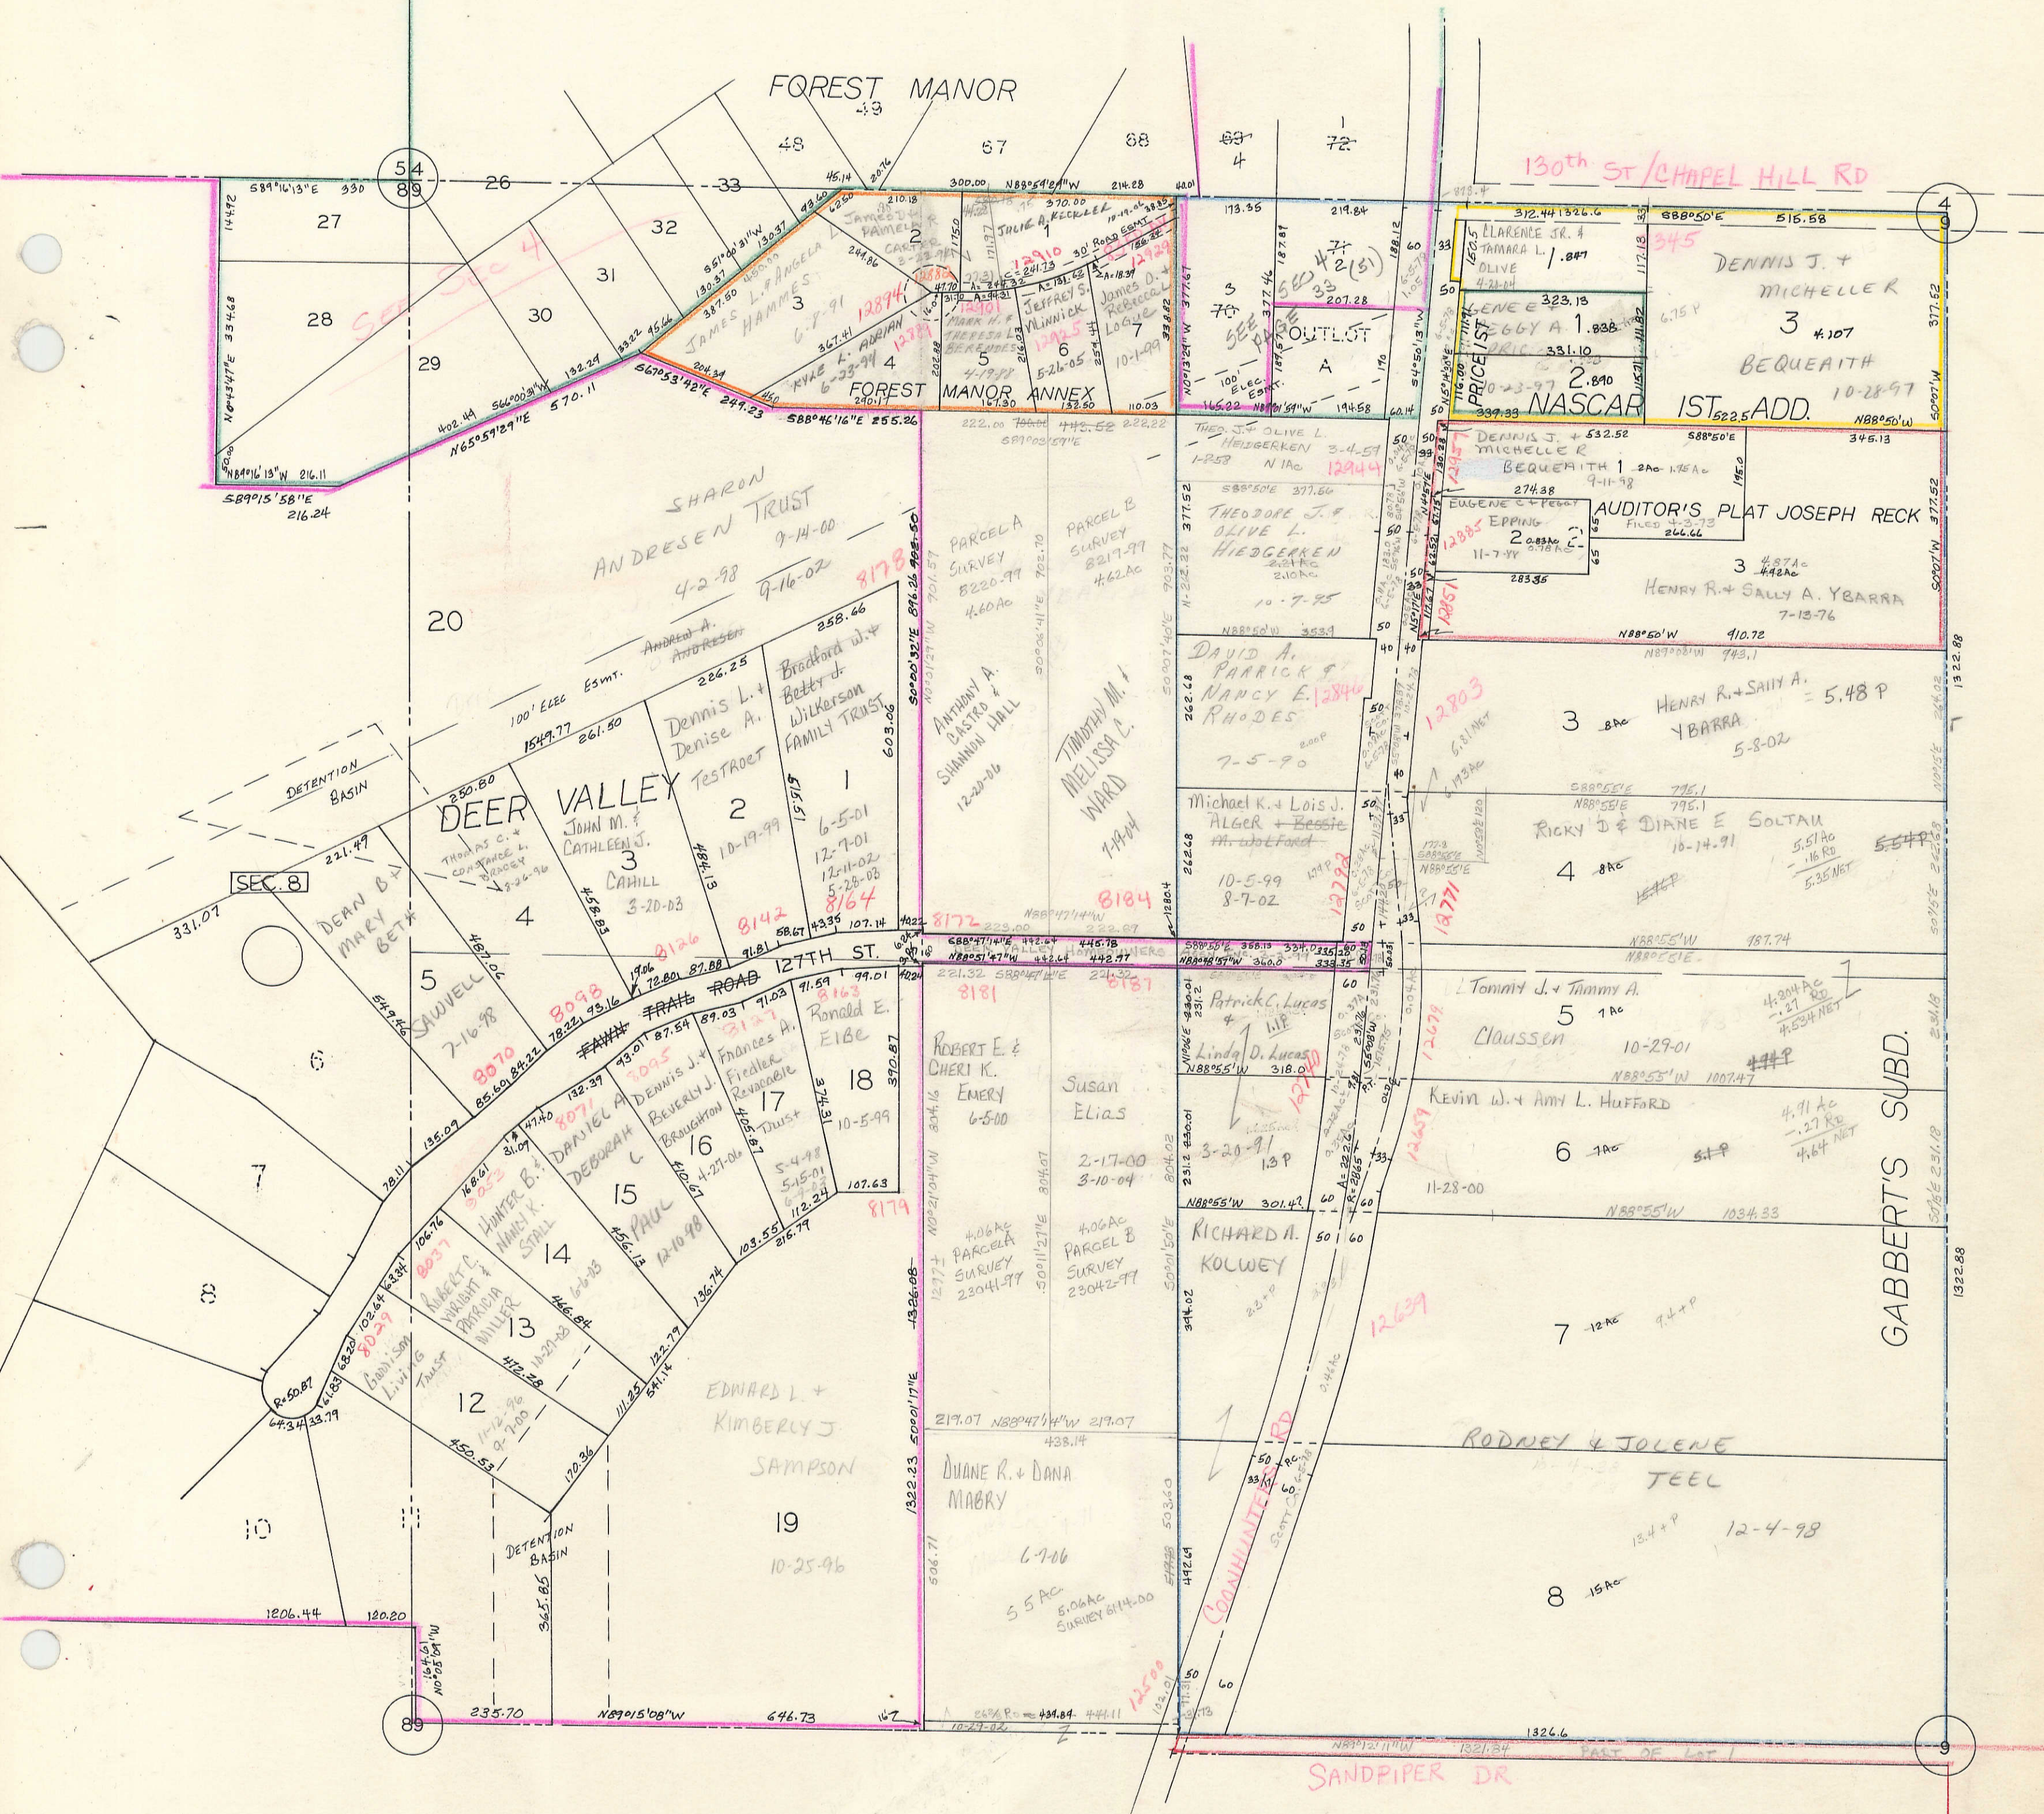

GABBERT'S SUBD.

SEC. 8

FOREST MANOR

DEER VALLEY

130th ST/CHAPEL HILL RD

SANDPIPER DR


DETENTION BASIN

DEAN B. + MARY B. BETX

SHARON ANDERSEN TRUST
9-14-00
4-2-98
9-16-02

Dennis J. + Michelle K. Bequeith
3 4.107
BEQUEITH
10-28-97
1ST ADD. 522.5

3-20-03

SAWYER
5 7-16-98

DEBORAH
6 4-27-00

EDWARD L. + KIMBERLY J. SAMPSON
19 10-25-96

Duane R. + Dana Mabry
6.706
5.5 AC
5.06 AC SURVEY 814.00

RODNEY + JOLENE TEEL
8 15 AC
12-4-98

Richard A. Kolwey
7 12 AC
7.4 + P

Kevin W. + Ann L. Hufford
6 1 AC
5.1 P

Tommy J. + Tammy A. Claussen
5 1 AC
10-29-01

Michael R. + Lois J. Alger + Beate
4 8 AC
10-5-99
8-7-02

DAVID A. PARRICK + NANCY E. RHODES
3 8 AC
7-5-90

THEODORE J. + OLIVE L. HEDGEREN
2 2.0 AC
10-7-85

THEODORE J. + OLIVE L. HEDGEREN
1 2.0 AC
1-25-83

PARCELA A SURVEY
8220.97
4.60 AC

PARCELA B SURVEY
8217.97
4.62 AC

ANTHONY A. CASTRO + SHANNON HALL
12-20-06

TIMOTHY M. + MELISSA L. WARD
11-04-04

ROBERT E. + CHERI K. EMERY
6-5-00

Susan Elias
2-17-00
3-10-04











































DETENTION BASIN

DETENTION BASIN

