


SW 1/4 SEC. 14-77-2  
SCALE: 1"=200'

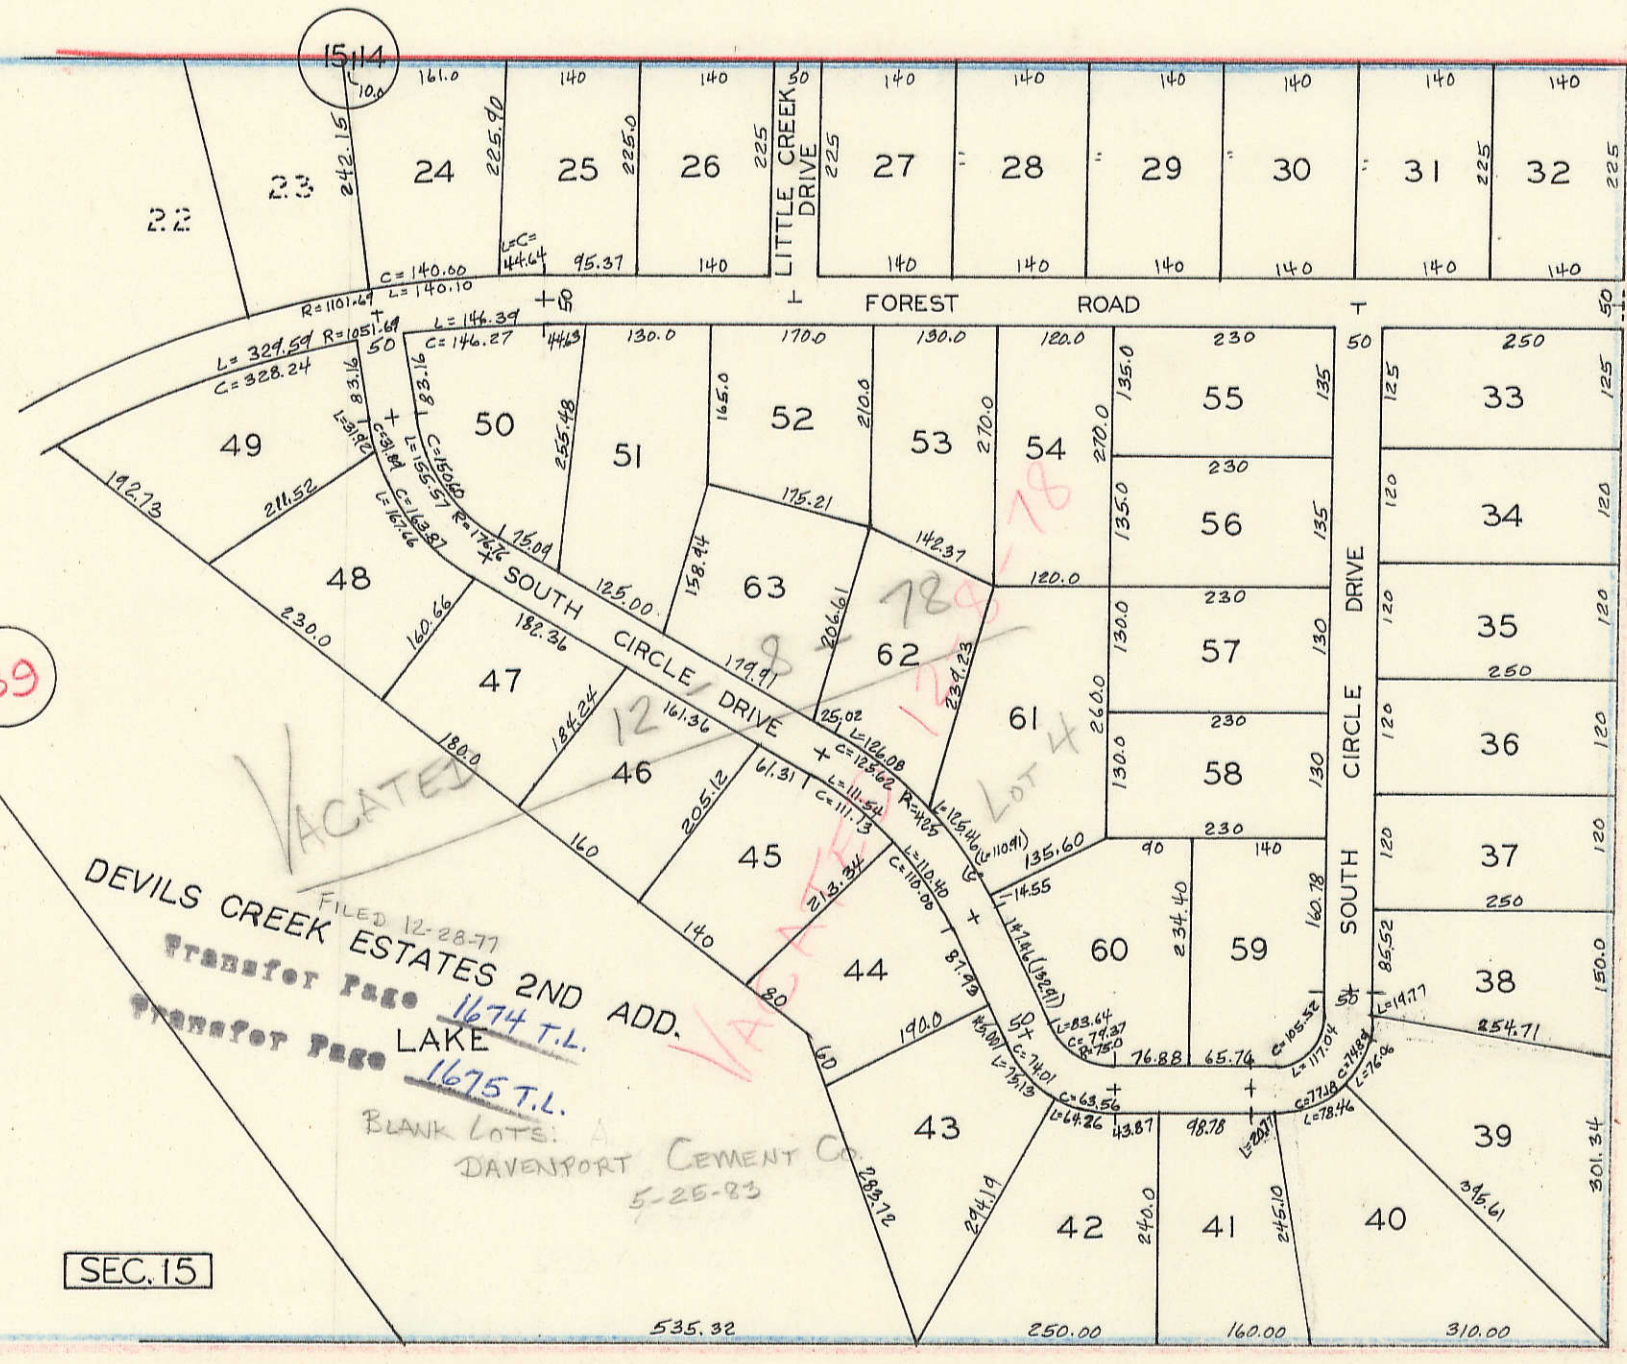

SEE TOWN OF BUFFALO  
SECTION 14 PAGE 35

PT Lot 1 DODGE  
SEE TOWN OF BUFFALO  
SECTION 14 PAGE 49

SEE TOWN OF BUFFALO  
SECTION 14 PAGE 51

SEC. 23

1514  
2223

14  
23

01

03

39

37

55

53