



SECTION 24  
TOWNSHIP 77 NORTH, RANGE 2 EAST  
5<sup>TH</sup> PRINCIPAL MERIDIAN  
BUFFALO TOWNSHIP  
SCOTT COUNTY, IOWA

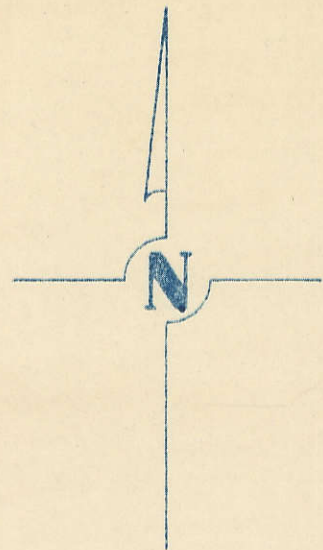

SCALE: 1 INCH = 330 FEET

ALL IN CITY  
ANNEX 3-15-96  
6422-96  
TRANSFER PAGE 92

SECTION 13 PAGE 13

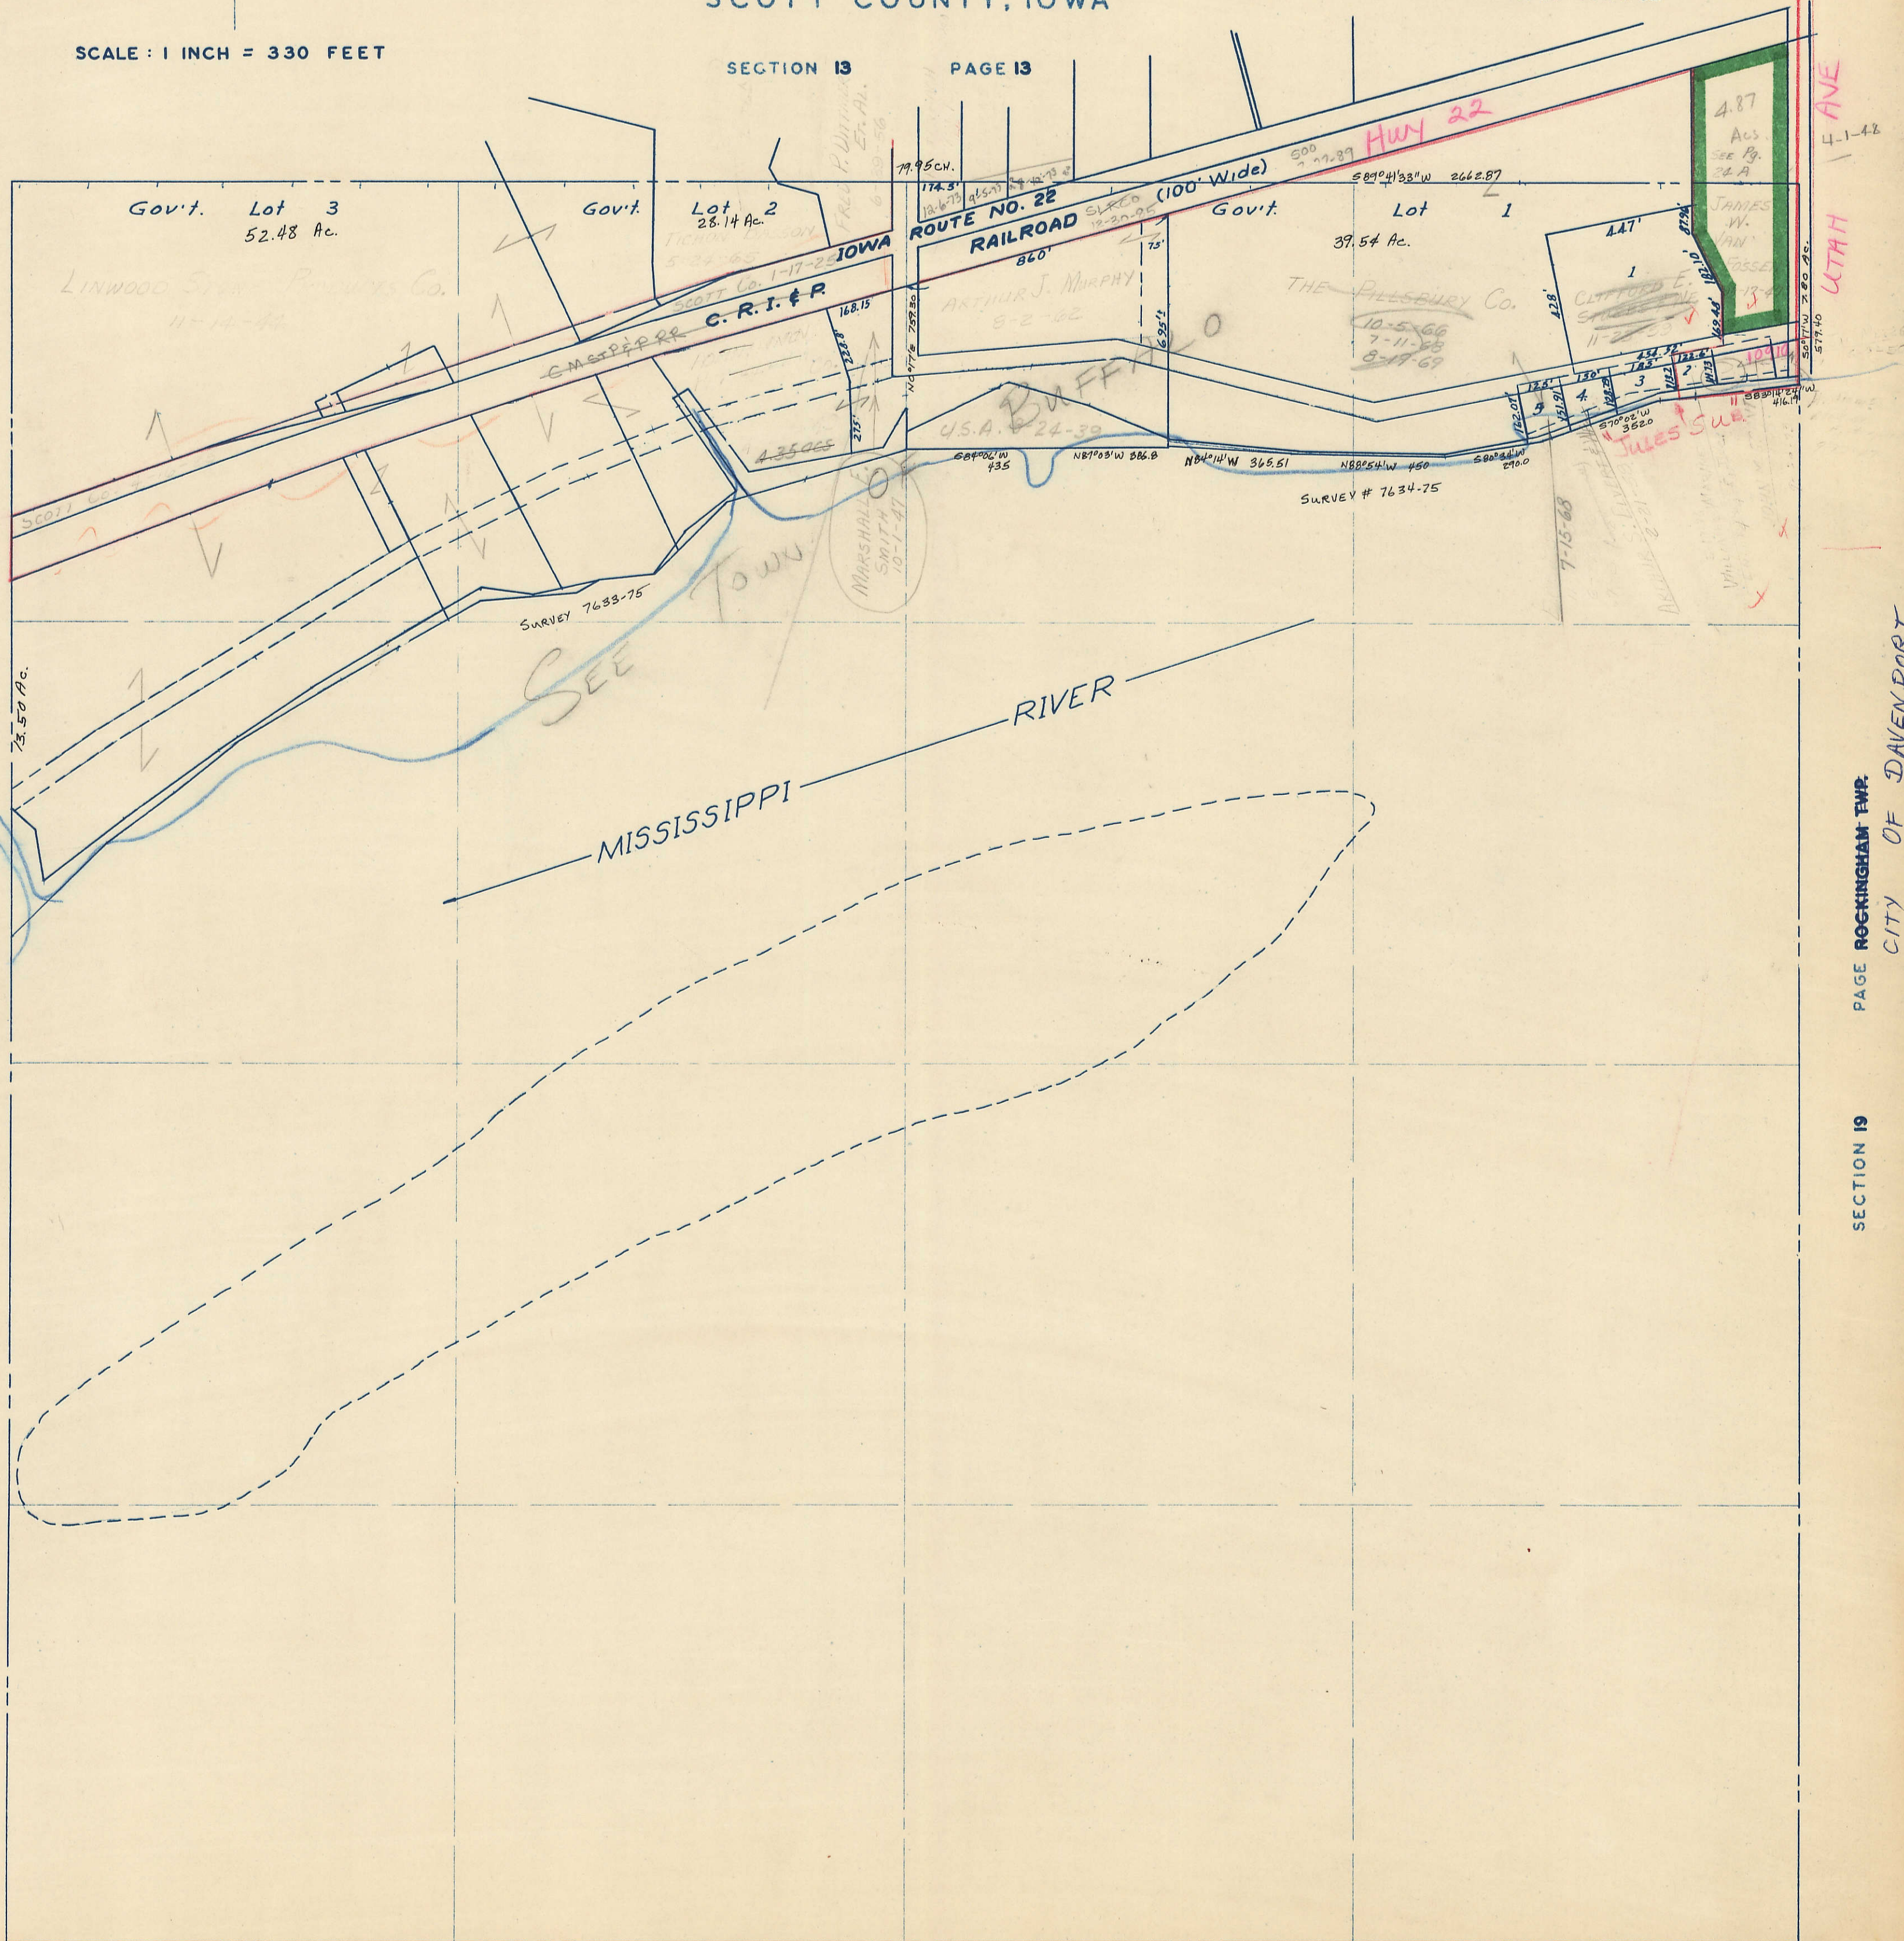

PAGE 23

SECTION 23


PAGE ROCKINGHAM TWP.

SECTION 19

CITY OF DAVENPORT


JAMES W VAN FOSSEN SUBD.  
PART SECTIONS 13 & 24-77-2

Transfer Page 857

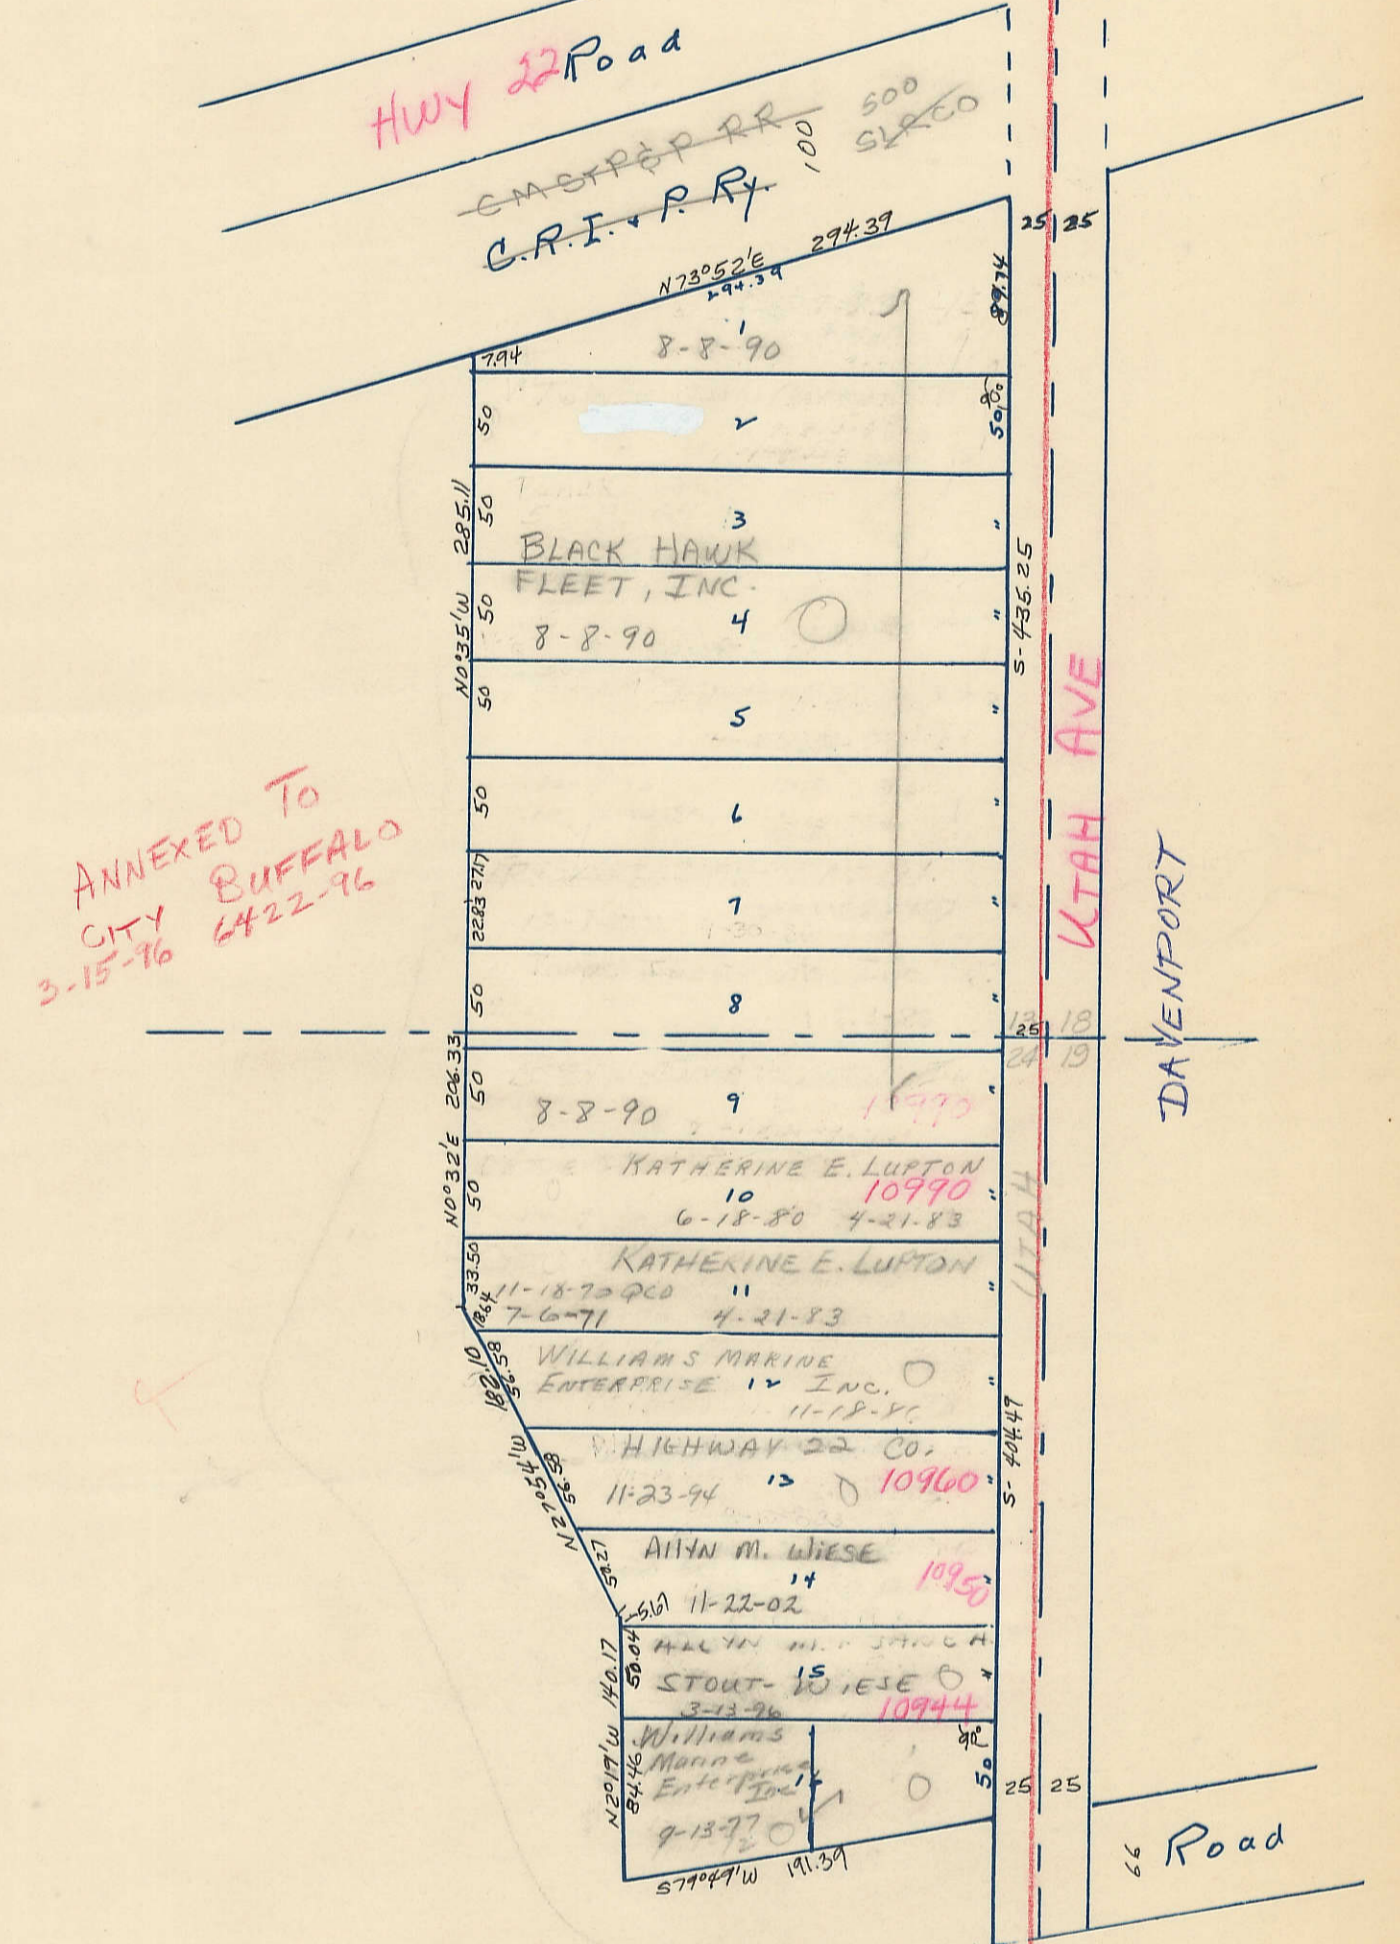

DYER'S FIRST ADDITION

Transfer Page 959 T.L.

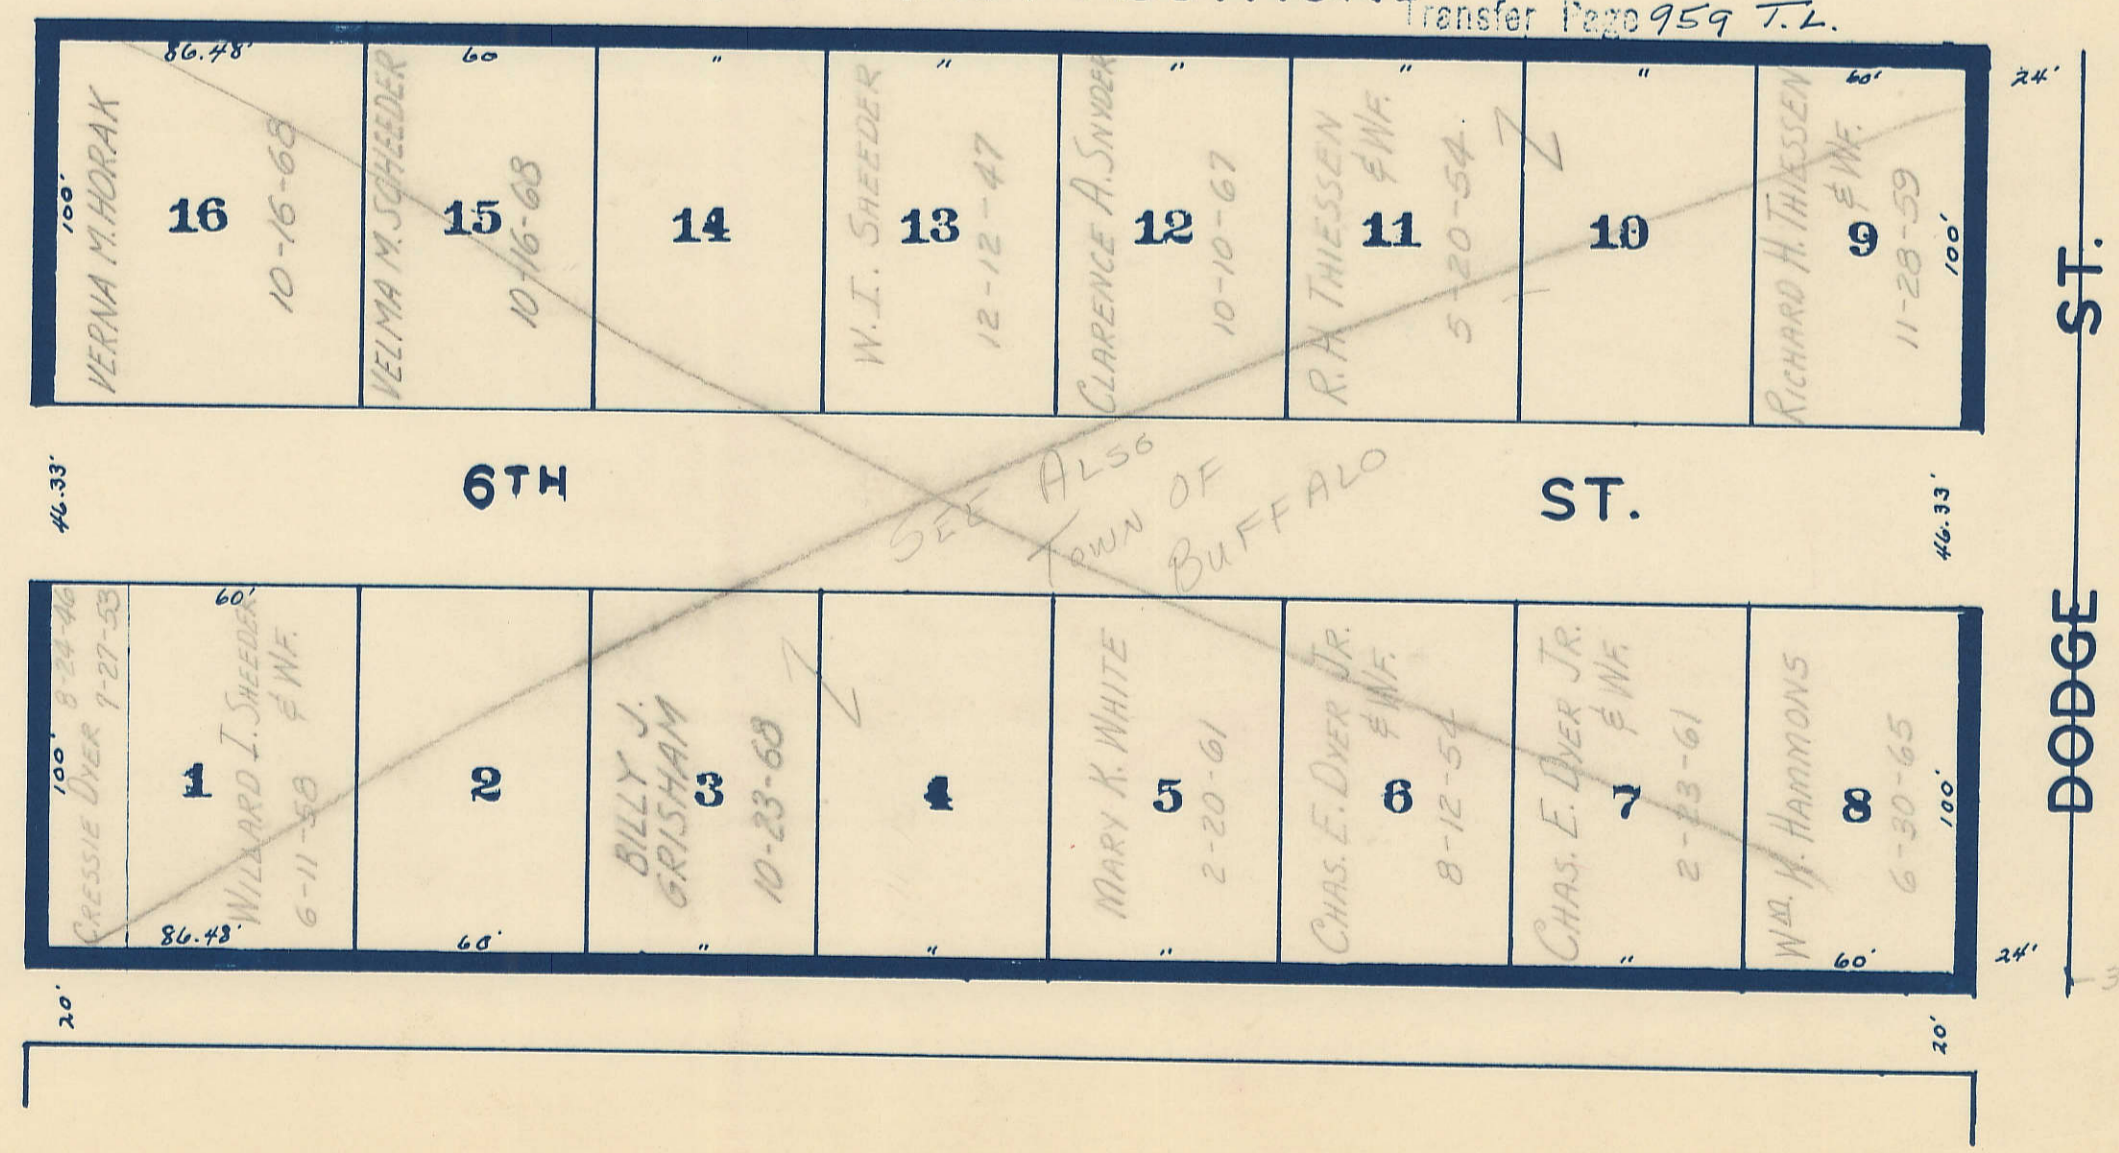

SEE ALSO TOWN OF BUFFALO

6TH ST.  
DODGE ST.

328.44' N. ALLEY