


SE 1/4, SE 1/4, SEC. 28-80-4
SCALE: 1"=100'

BLANK LOTS: MARVIN E. & FRANCES M. HINKLE
6-30-87
2-7, 9, 10, 13, 19

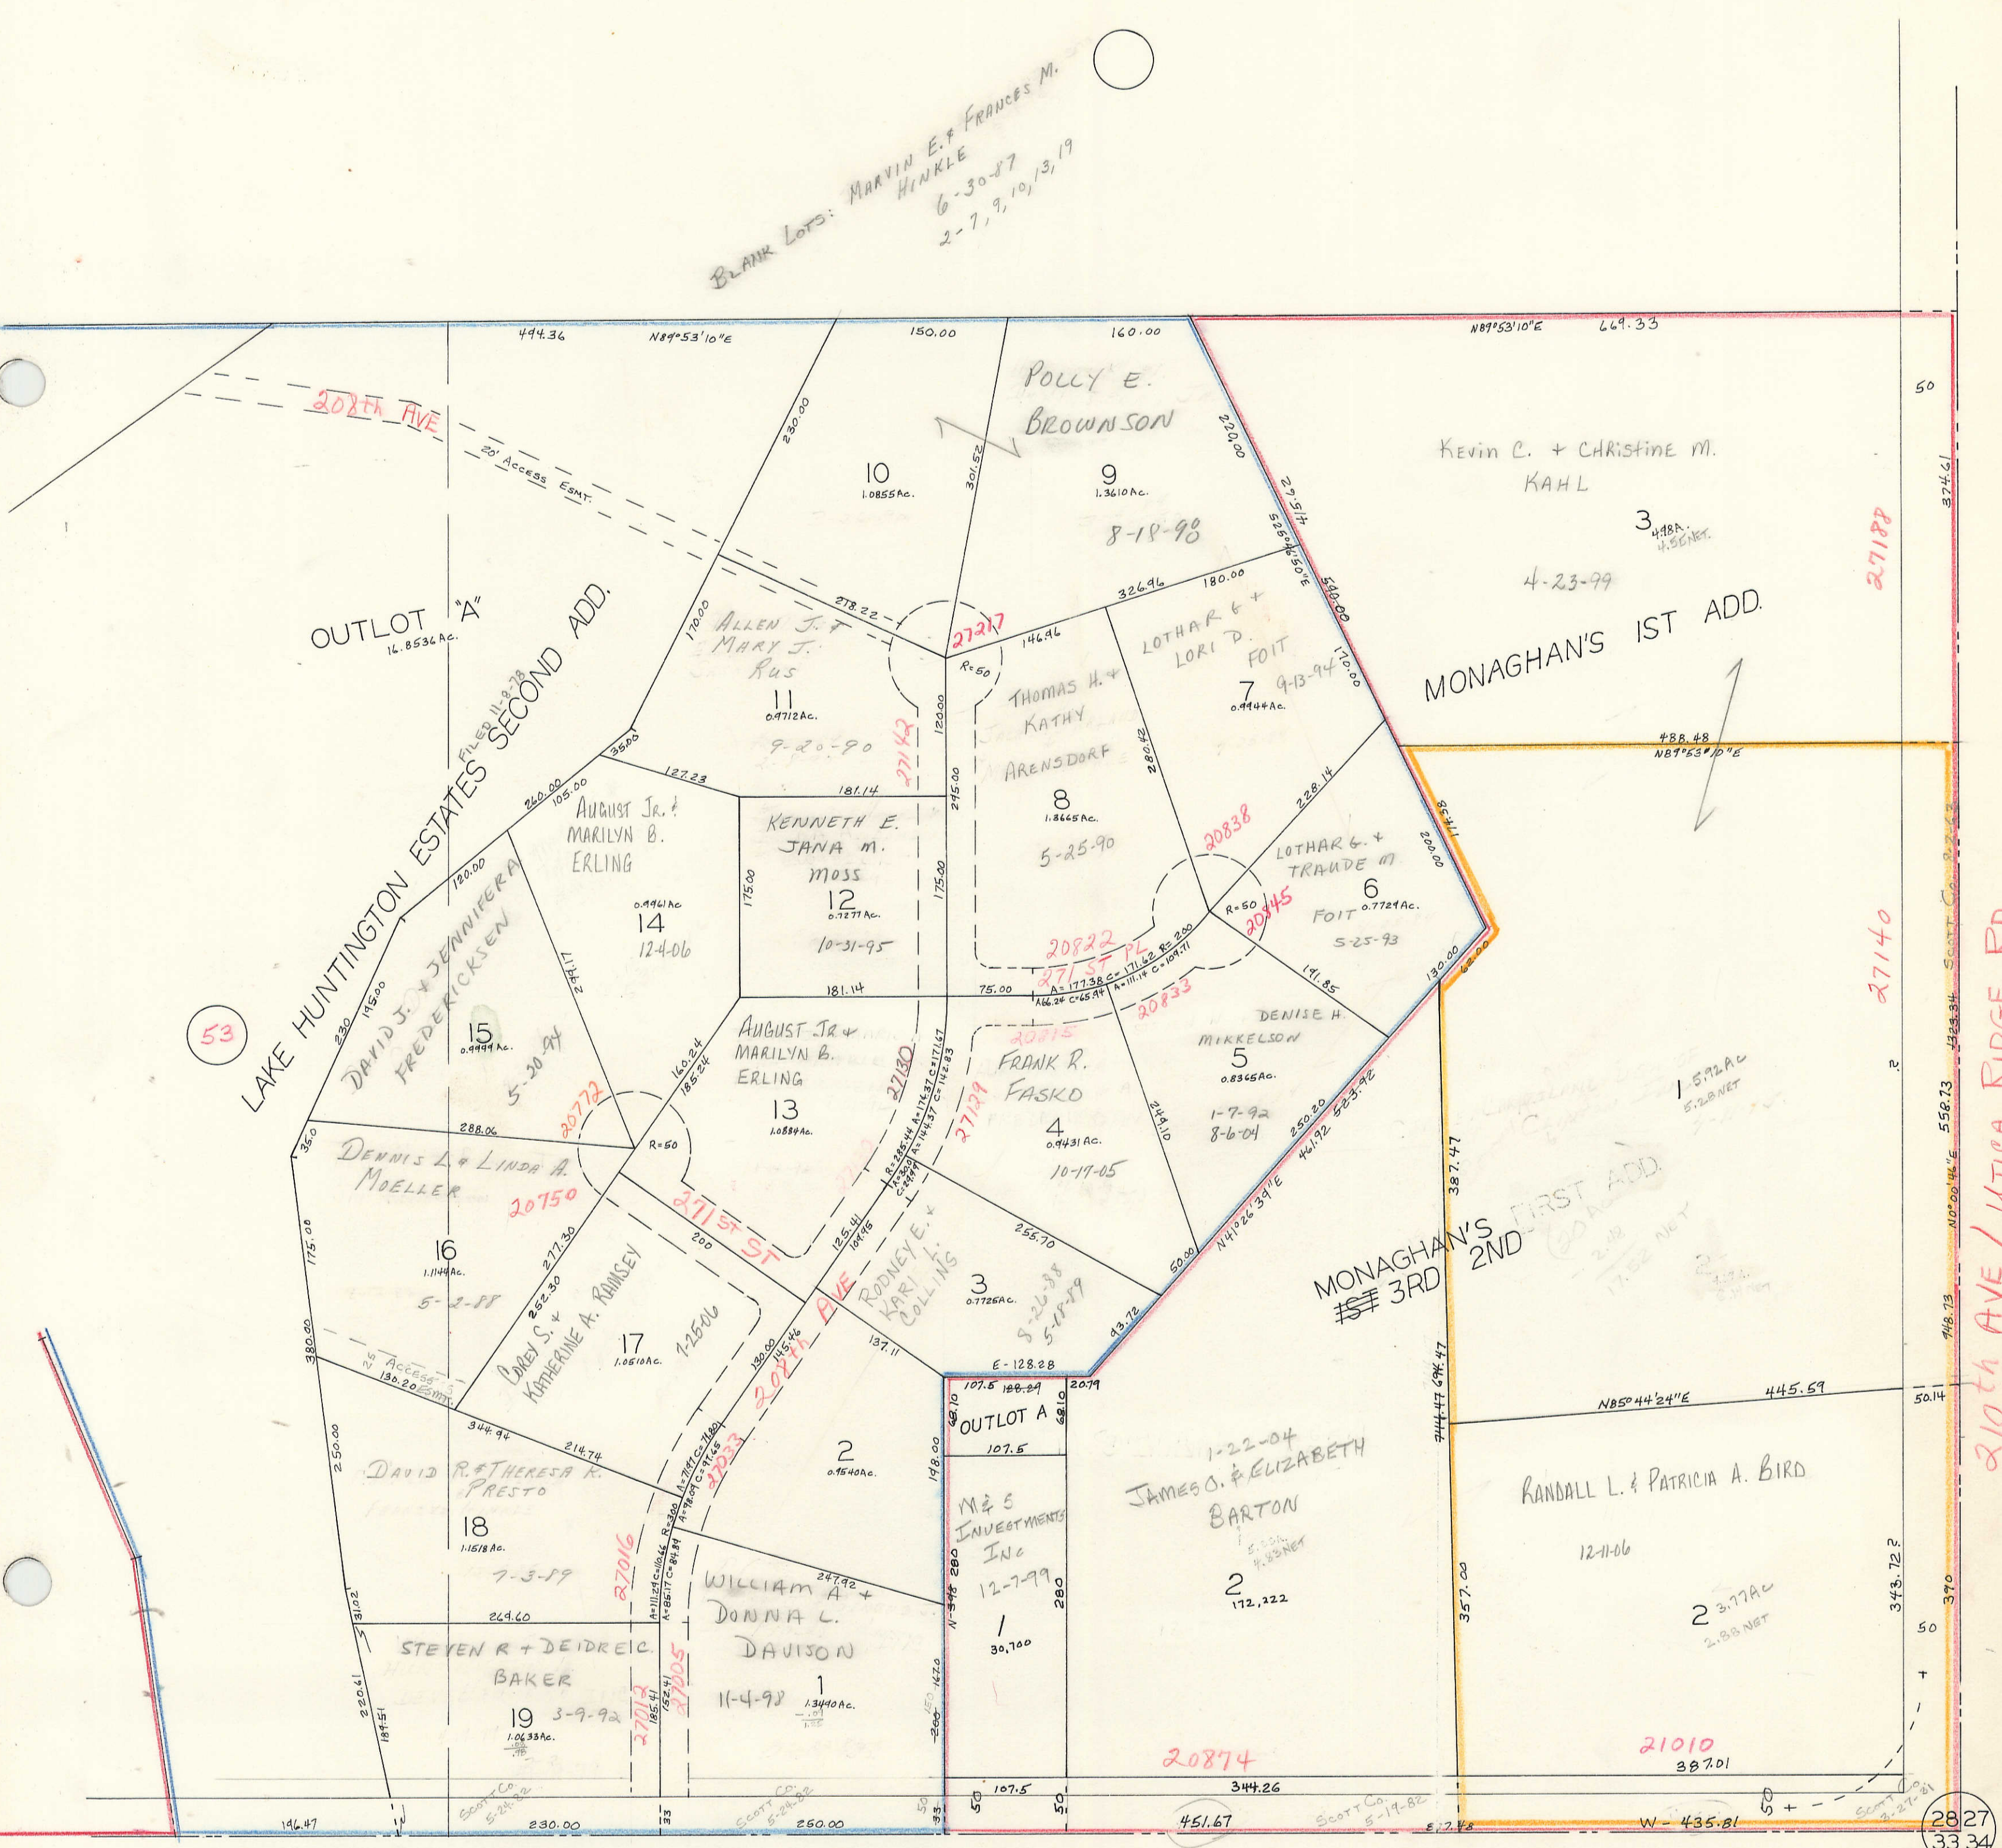

SEC. 27

SEC. 33