


SECTION 10

Township 80-North; Range 4
EAST OF THE FIFTH PRINCIPAL MERIDIAN
SCOTT COUNTY, IOWA
BUTLER TOWNSHIP

SCALE IN CHAINS



SCALE IN FEET

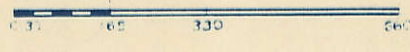

Transfer Page 102

NORTH

WEST

EAST

BOYLE-BERGERT LLC
3-25-97

CARL H WITT
11-12-62

PAUL D. + STEPHANIE K.
CLAEYS
12-25-88

SCOTT D. KELLING
3-11-87
9-15-05

7-16-40

11-20-40

7-22-40

DEBRA JOHNSON
487


LINDA LA WESTENBERG
1-23-46
6-17-88
5-2-85

SHIRLEY ANN MIRFIELD
4-3-68
6-15-00

210th AVE / ULTICA RIDGE RD
4-21-59

300th ST.

SOUTH

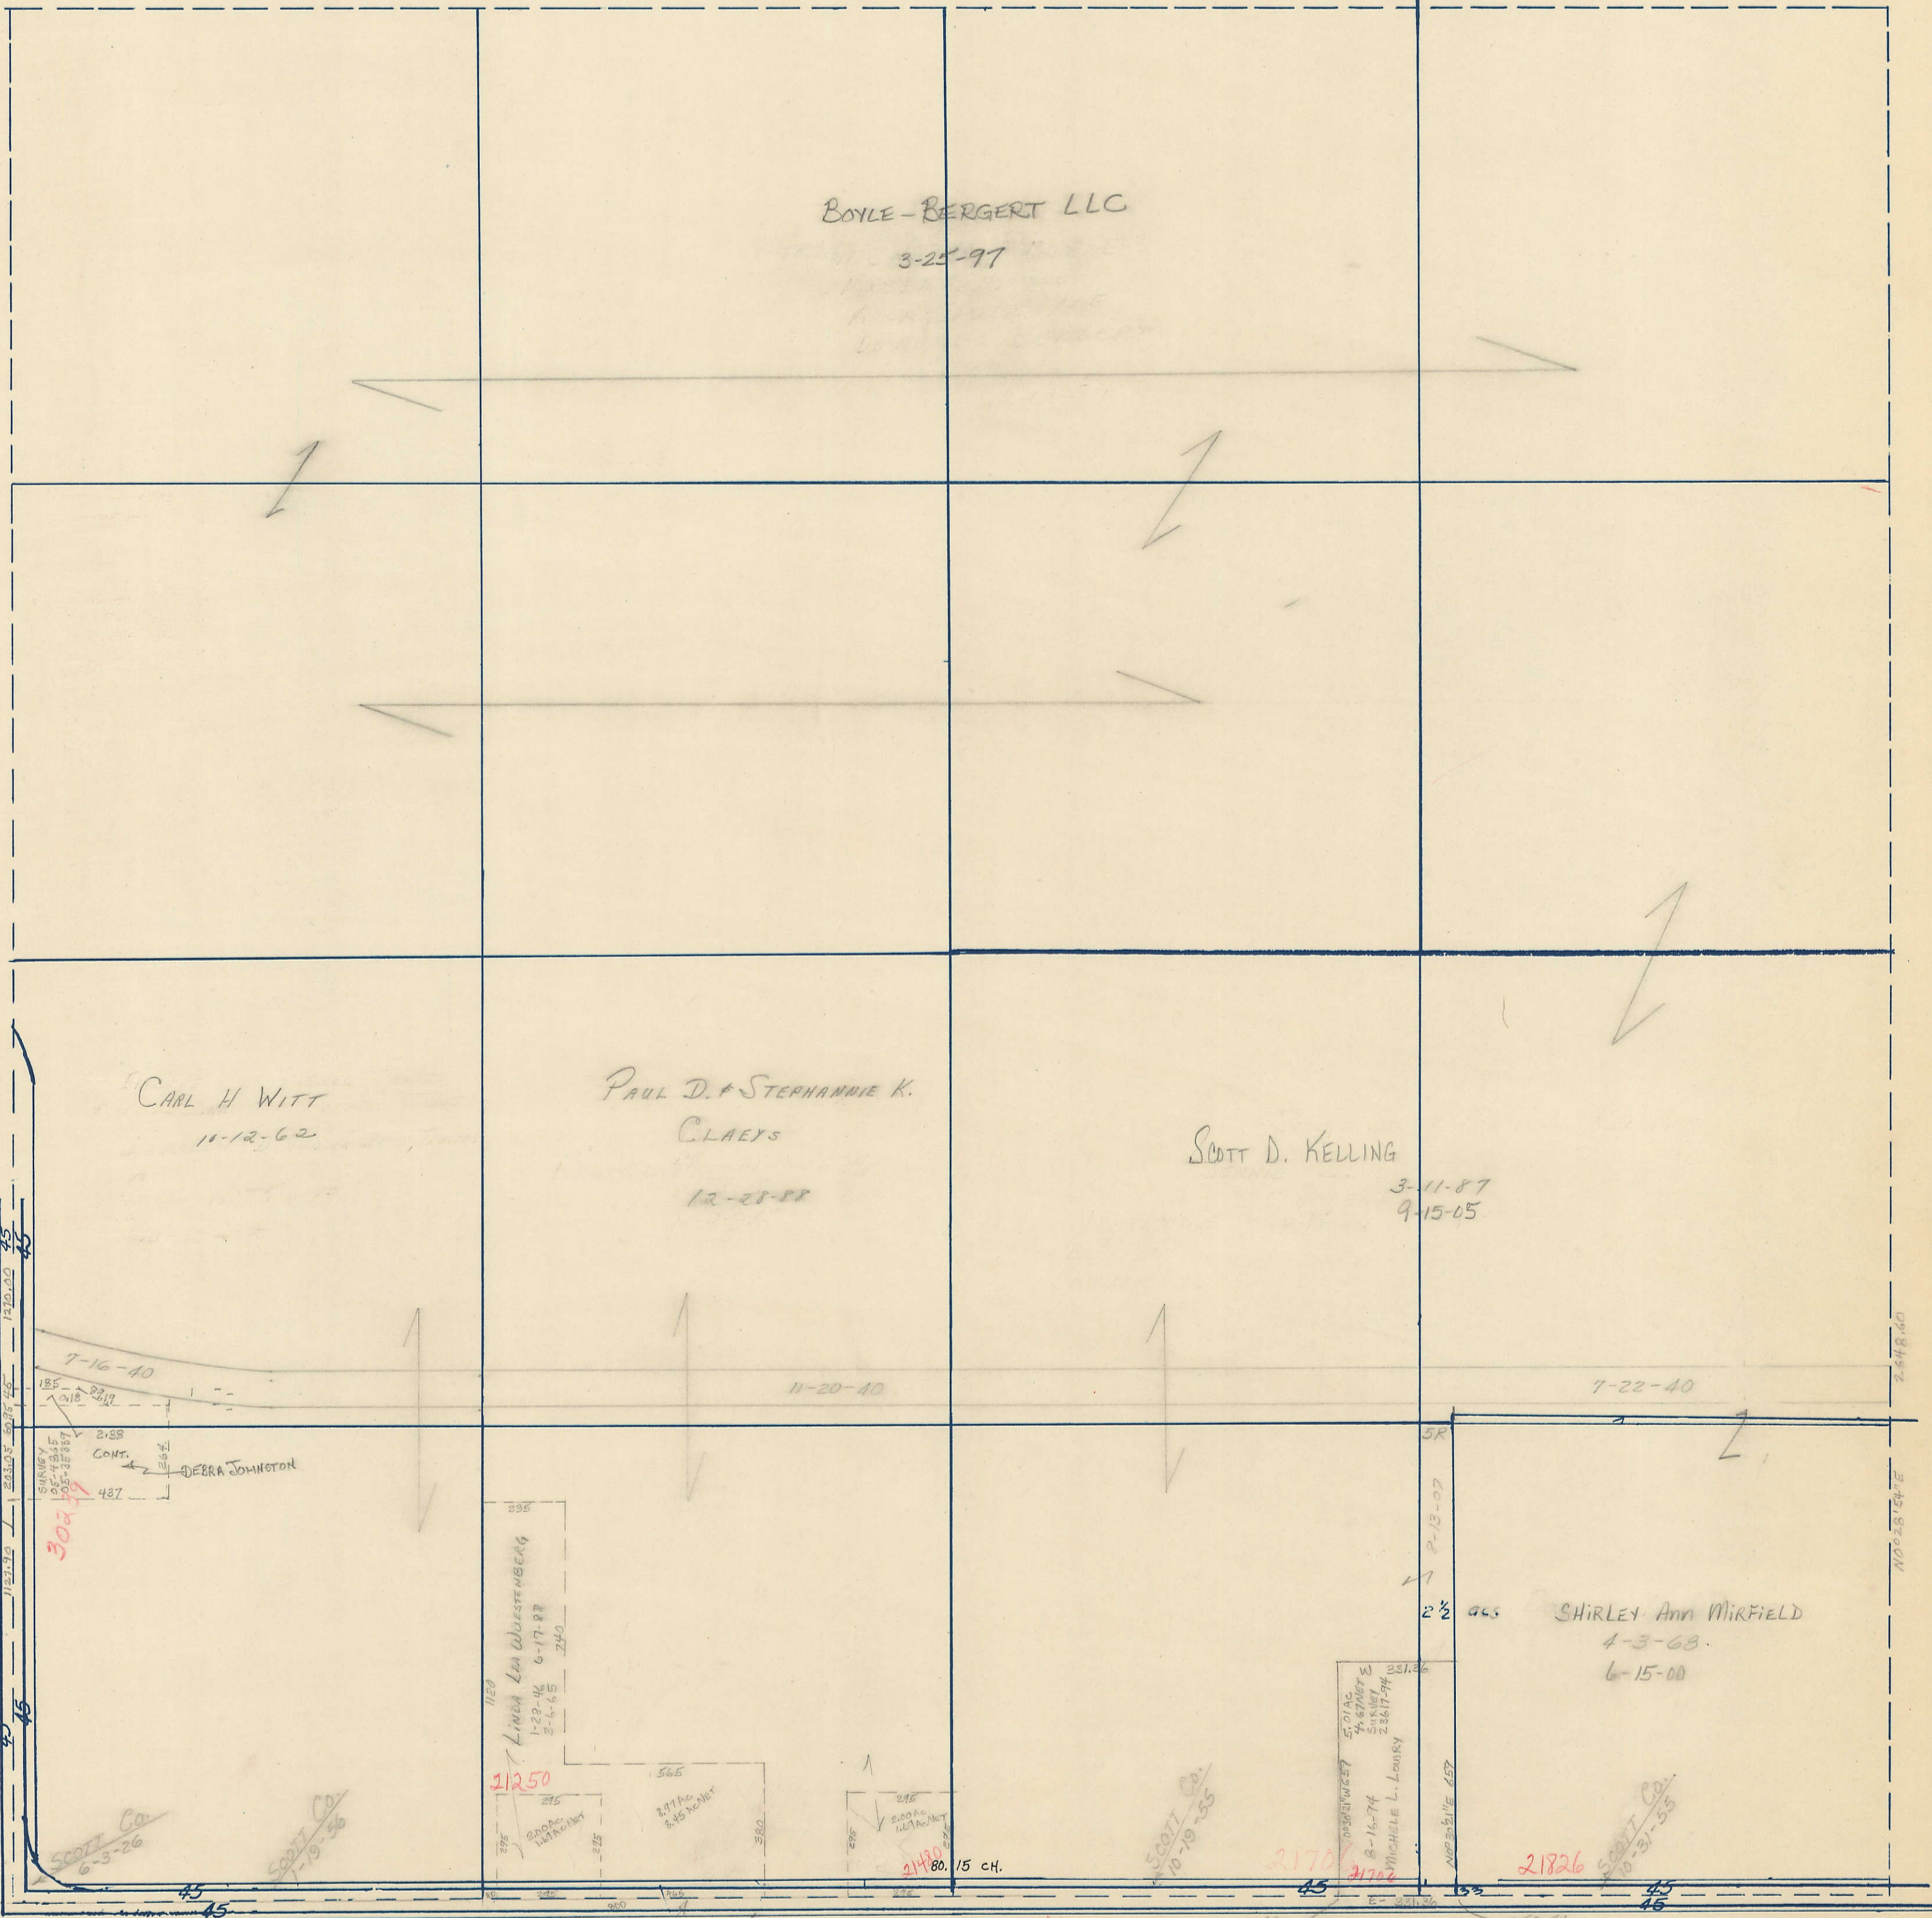

SCOTT Co
6-3-26

SCOTT Co
7-19-26

21250

565

21180

SCOTT Co
7-19-26

2170

21826

SCOTT Co
10-31-55

10/1/55
Scott County
5007 Co
8-28-26

1057.80

1258.54

NO. 25754E

2.848.40