

SECTION 4

Township 80-North; Range 4


EAST OF THE FIFTH PRINCIPAL MERIDIAN

SCOTT COUNTY, IOWA


BUTLER TOWNSHIP

NORTH


SCALE IN CHAINS

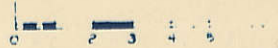

SCALE IN FEET

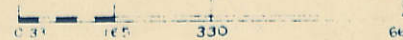

Transfer Page 96

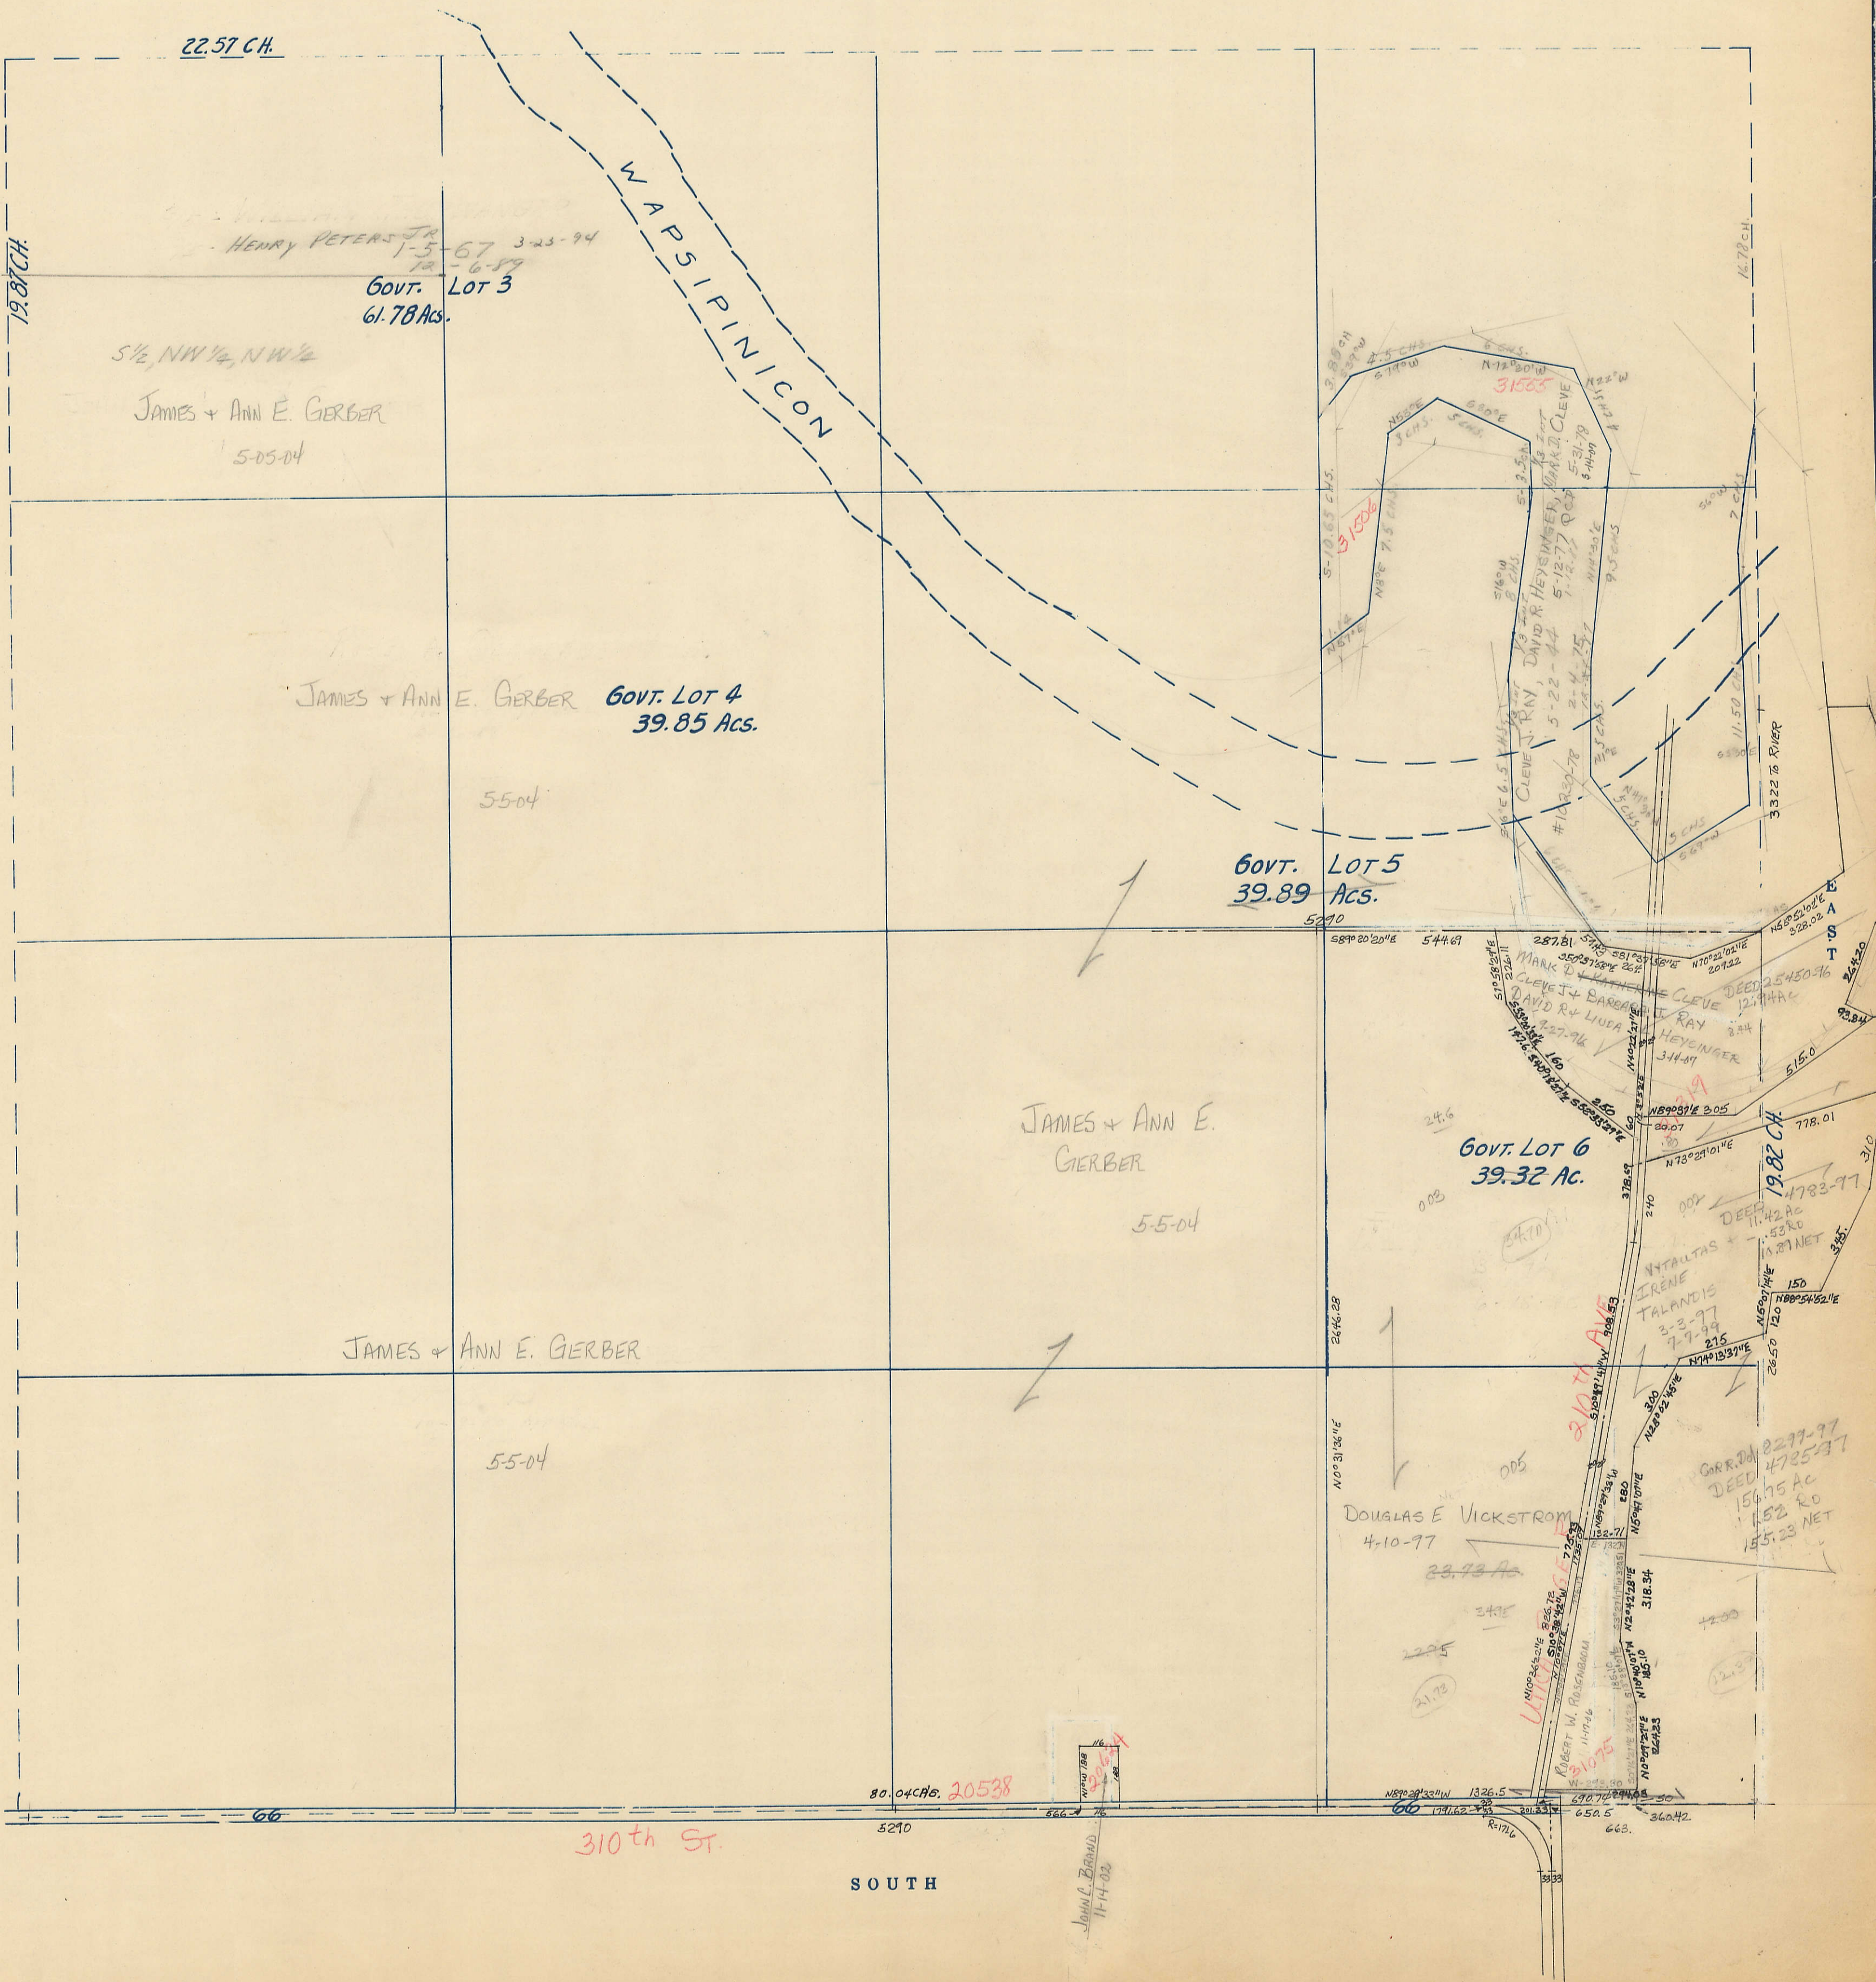

WEST

SOUTH

310th St.

80.04 CHS. 20538

5270

66 65A.5 663. 360.42

John L. Brand 11-14-02

DOUGLAS E. VICKSTROM 4-10-97

GOVT. LOT 6 39.32 AC.

JAMES + ANN E. GERBER

GOVT. LOT 5 39.89 ACS.

JAMES + ANN E. GERBER GOVT. LOT 4 39.85 ACS.

HENRY PETERS JR 1-5-67 3-23-94
GOVT. LOT 3 61.78 ACS.
5 1/2 NW 1/4, NW 1/4
JAMES + ANN E. GERBER 5-05-04

22.57 CH.

H21861

16.78 CH.

3322 TO RIVER

19.82 CH.

155.23 NET

156.75 AC

11.52 AC

11.42 AC

11.37 NET

11.37 NET

