

SECTION
30

SCALE IN CHAINS



Township 79-North; Range 1

EAST OF THE FIFTH PRINCIPAL MERIDIAN

SCALE IN FEET



SCOTT COUNTY, IOWA
CLEONA TOWNSHIP


NORTH

Transfer Page 163

220th ST.

FIFTH PRINCIPAL MERIDIAN

10TH AVE EAST

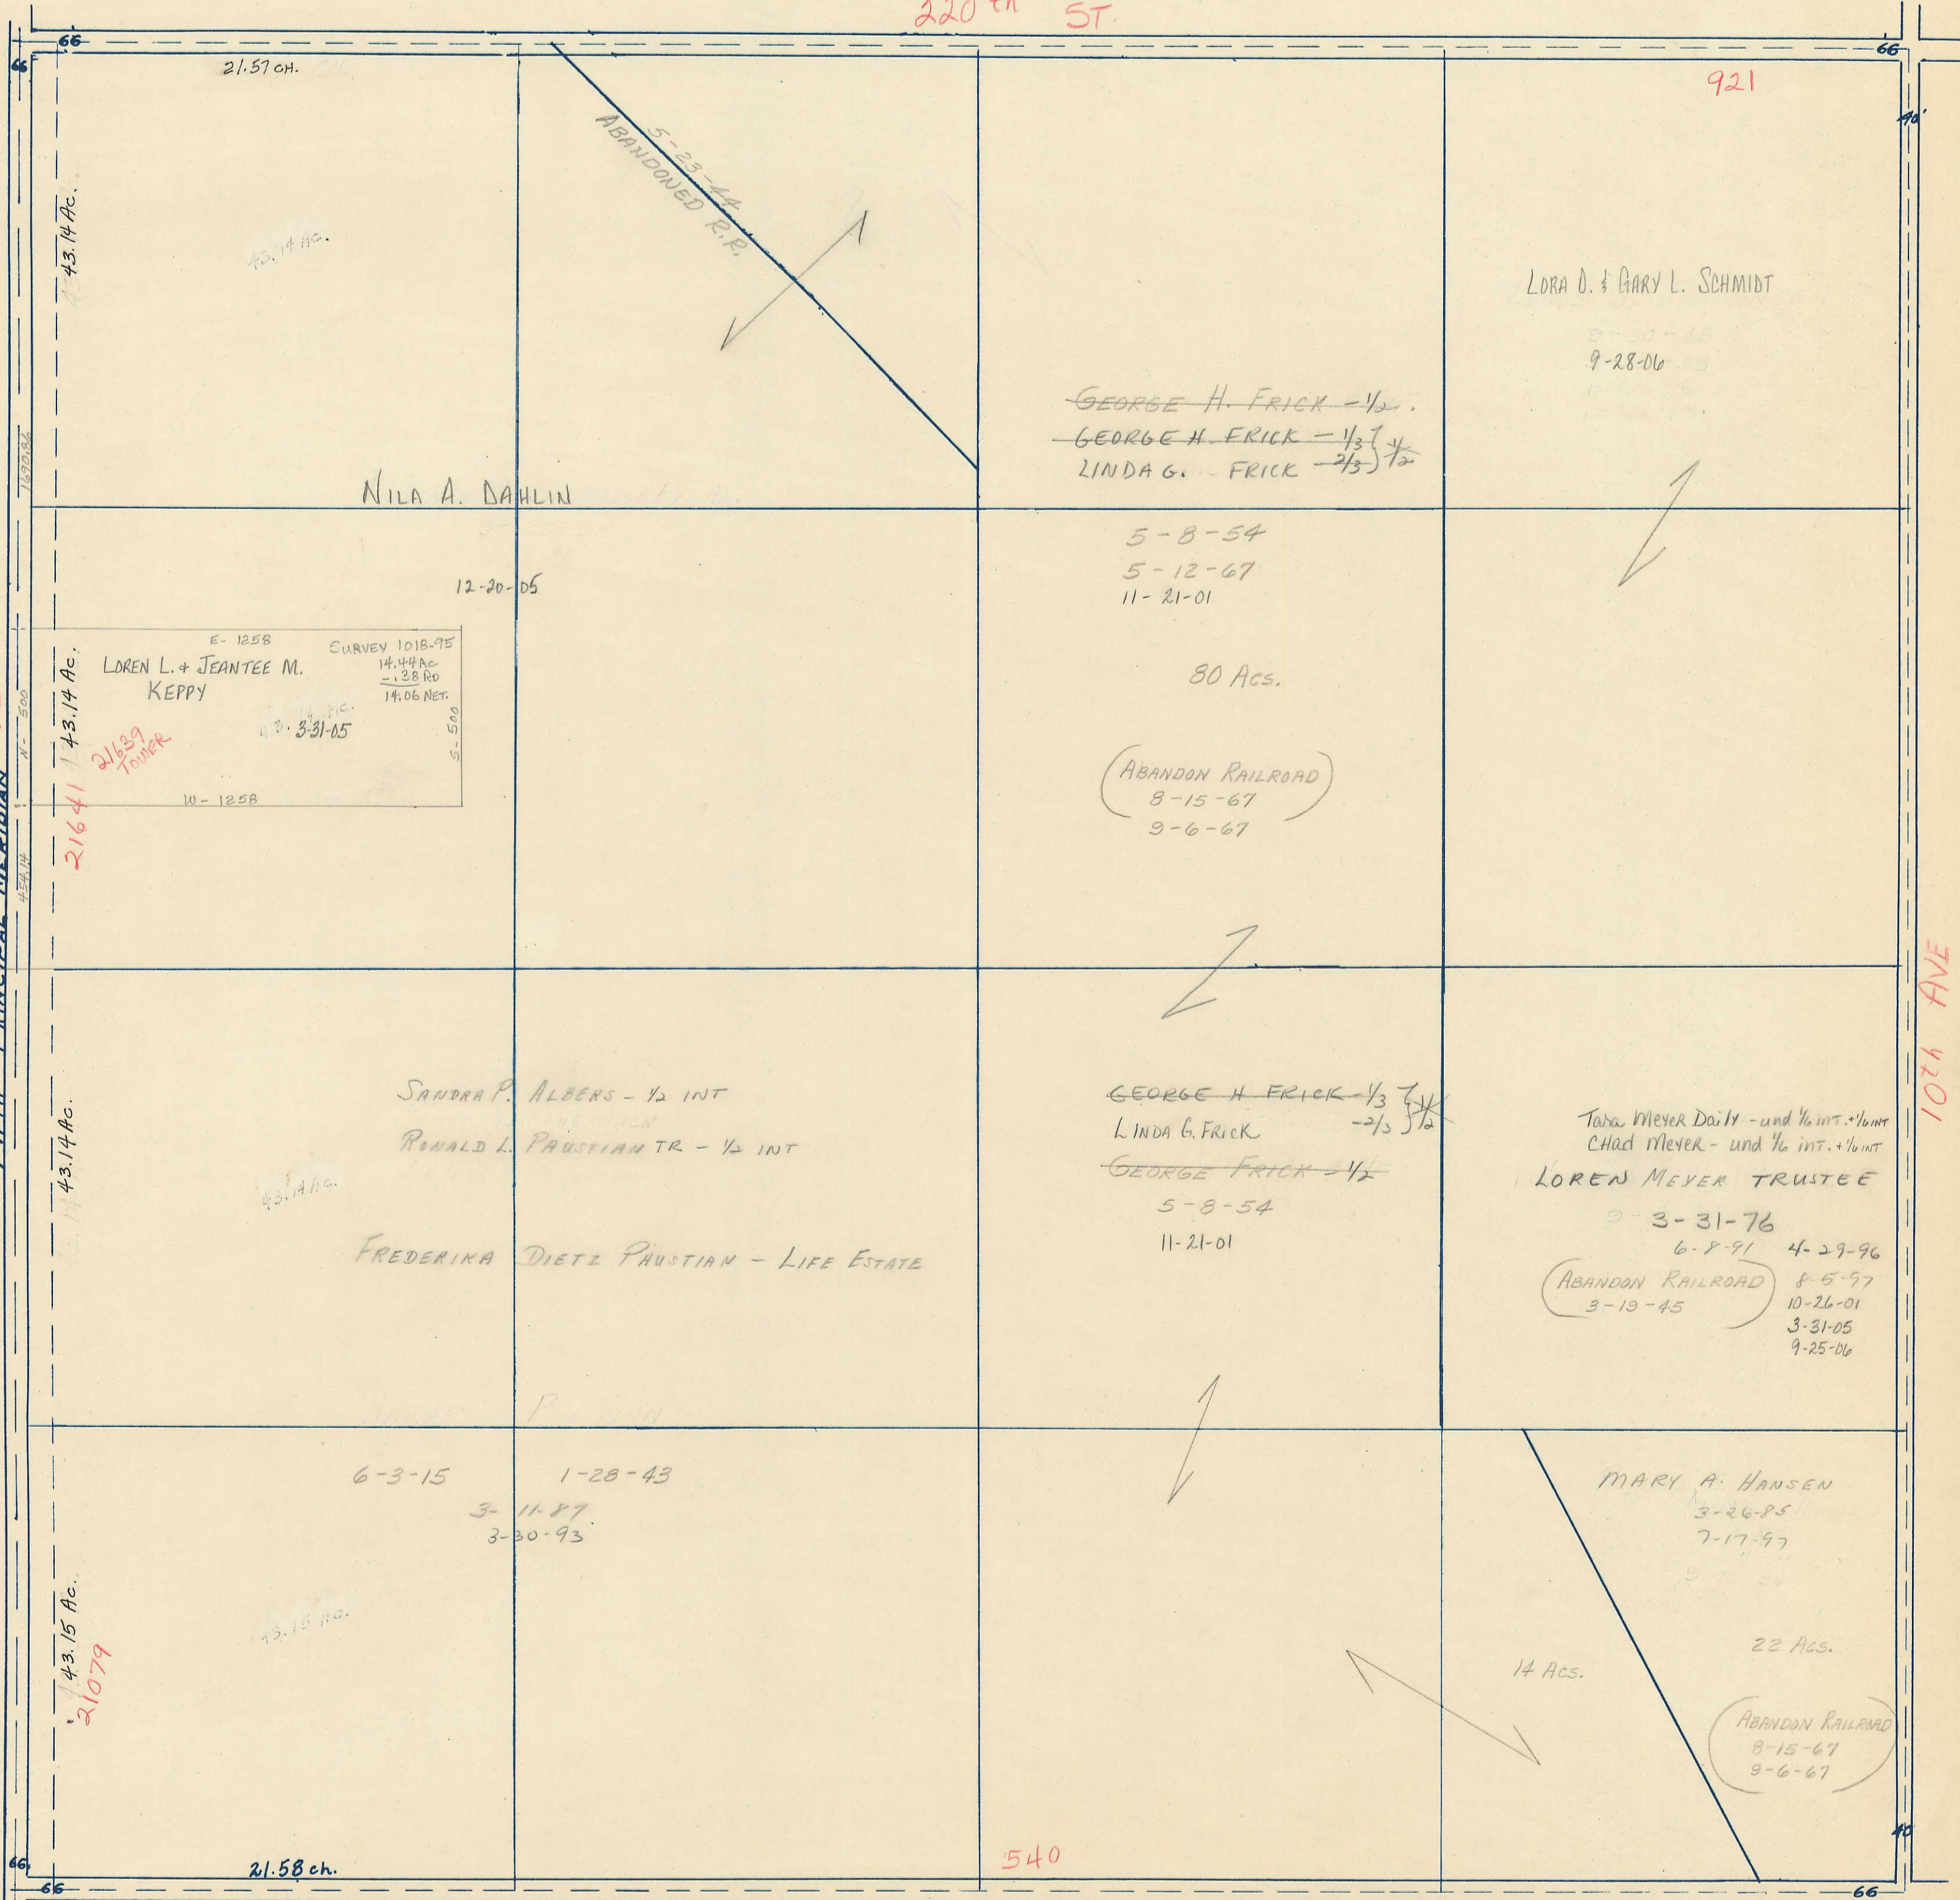

21.57 ch.

921

LORA D. & GARY L. SCHMIDT

9-28-06

~~GEORGE H. FRICK - 1/2~~
~~GEORGE H. FRICK - 1/2~~ 1/2
LINDA G. FRICK - 1/2

NILA A. DAHLIN

5-8-54
5-12-67
11-21-01

80 Acs.

(ABANDON RAILROAD)
8-15-67
9-6-67

E-1258 SURVEY 1018-95
LOREN L. + JEANTEE M. KEPPY
14.44 AC.
-1.28 RD.
14.06 NET.
3-31-05
W-1258

12-20-05

~~GEORGE H. FRICK - 1/3~~ 1/3
LINDA G. FRICK - 2/3
~~GEORGE FRICK - 1/2~~
5-8-54
11-21-01

SANDRA P. ALBERS - 1/2 INT
RONALD L. PAUSTIAN TR - 1/2 INT

Tara Meyer Daily - und 1/2 int. 1/2 int
Chad Meyer - und 1/2 int. 1/2 int
LOREN MEYER TRUSTEE
9-3-31-76
6-8-91 4-29-96
(ABANDON RAILROAD) 8-5-97
3-13-45 10-26-01
3-31-05
9-25-06

FREDERIKA DIETZ PAUSTIAN - LIFE ESTATE

6-3-15
3-11-87
3-30-93

1-28-43

MARY A. HANSEN
3-26-85
7-17-97

14 Acs.

22 Acs.

(ABANDON RAILROAD)
8-15-67
9-6-67

21.58 ch.

540

210th ST

SOUTH