

SECTION  
31

SCALE IN CHAINS



Township 79-North; Range 1

EAST OF THE FIFTH PRINCIPAL MERIDIAN

SCALE IN FEET




DURANT ANNEX 3-7-91 # 5072-91  
" " " # 9277-91  
" " 6-15-04 # 22173-04  
CORRECTION 10-13-04 # 36460-04

SCOTT COUNTY, IOWA  
CLEONA TOWNSHIP

NORTH

Transfer Page 164

210th ST

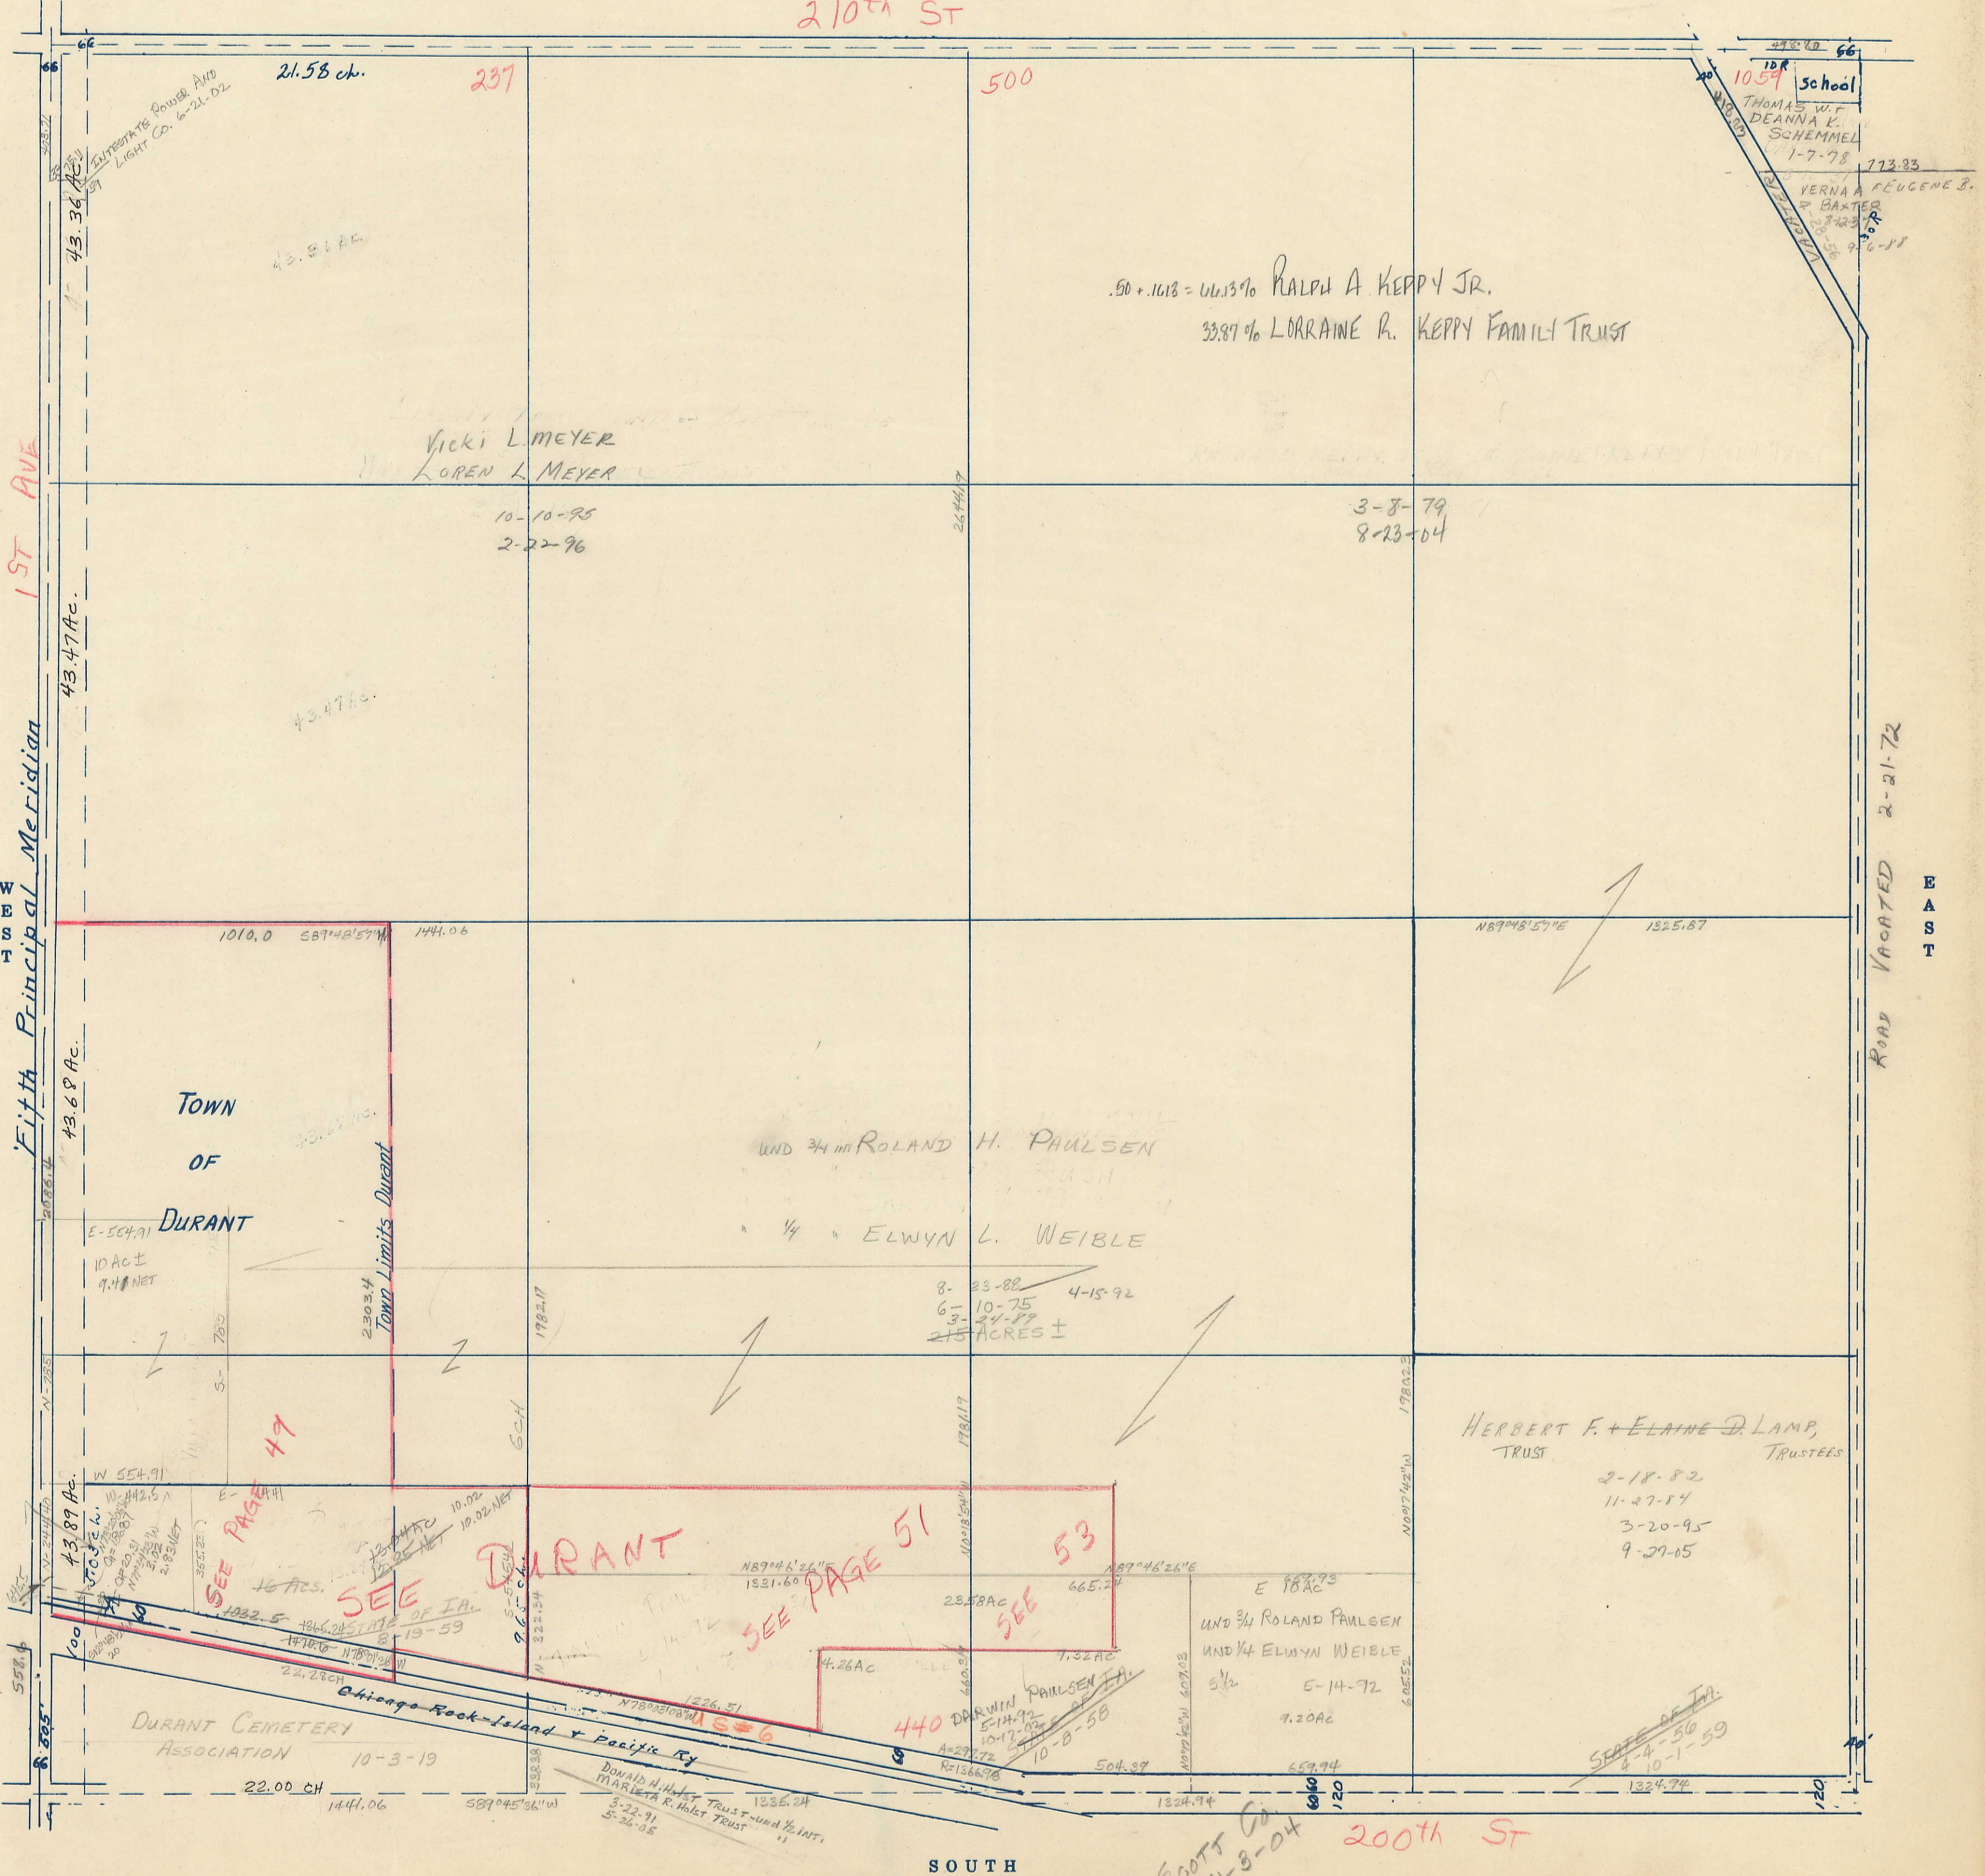

SOUTH

SCOTT Co  
11-8-04  
200th ST