


SECTION  
33

Township 79-North; Range 1  
EAST OF THE FIFTH PRINCIPAL MERIDIAN  
SCOTT COUNTY, IOWA  
CLEONA TOWNSHIP

SCALE IN CHAINS

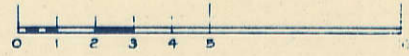


SCALE IN FEET



Transfer Page 166

NORTH

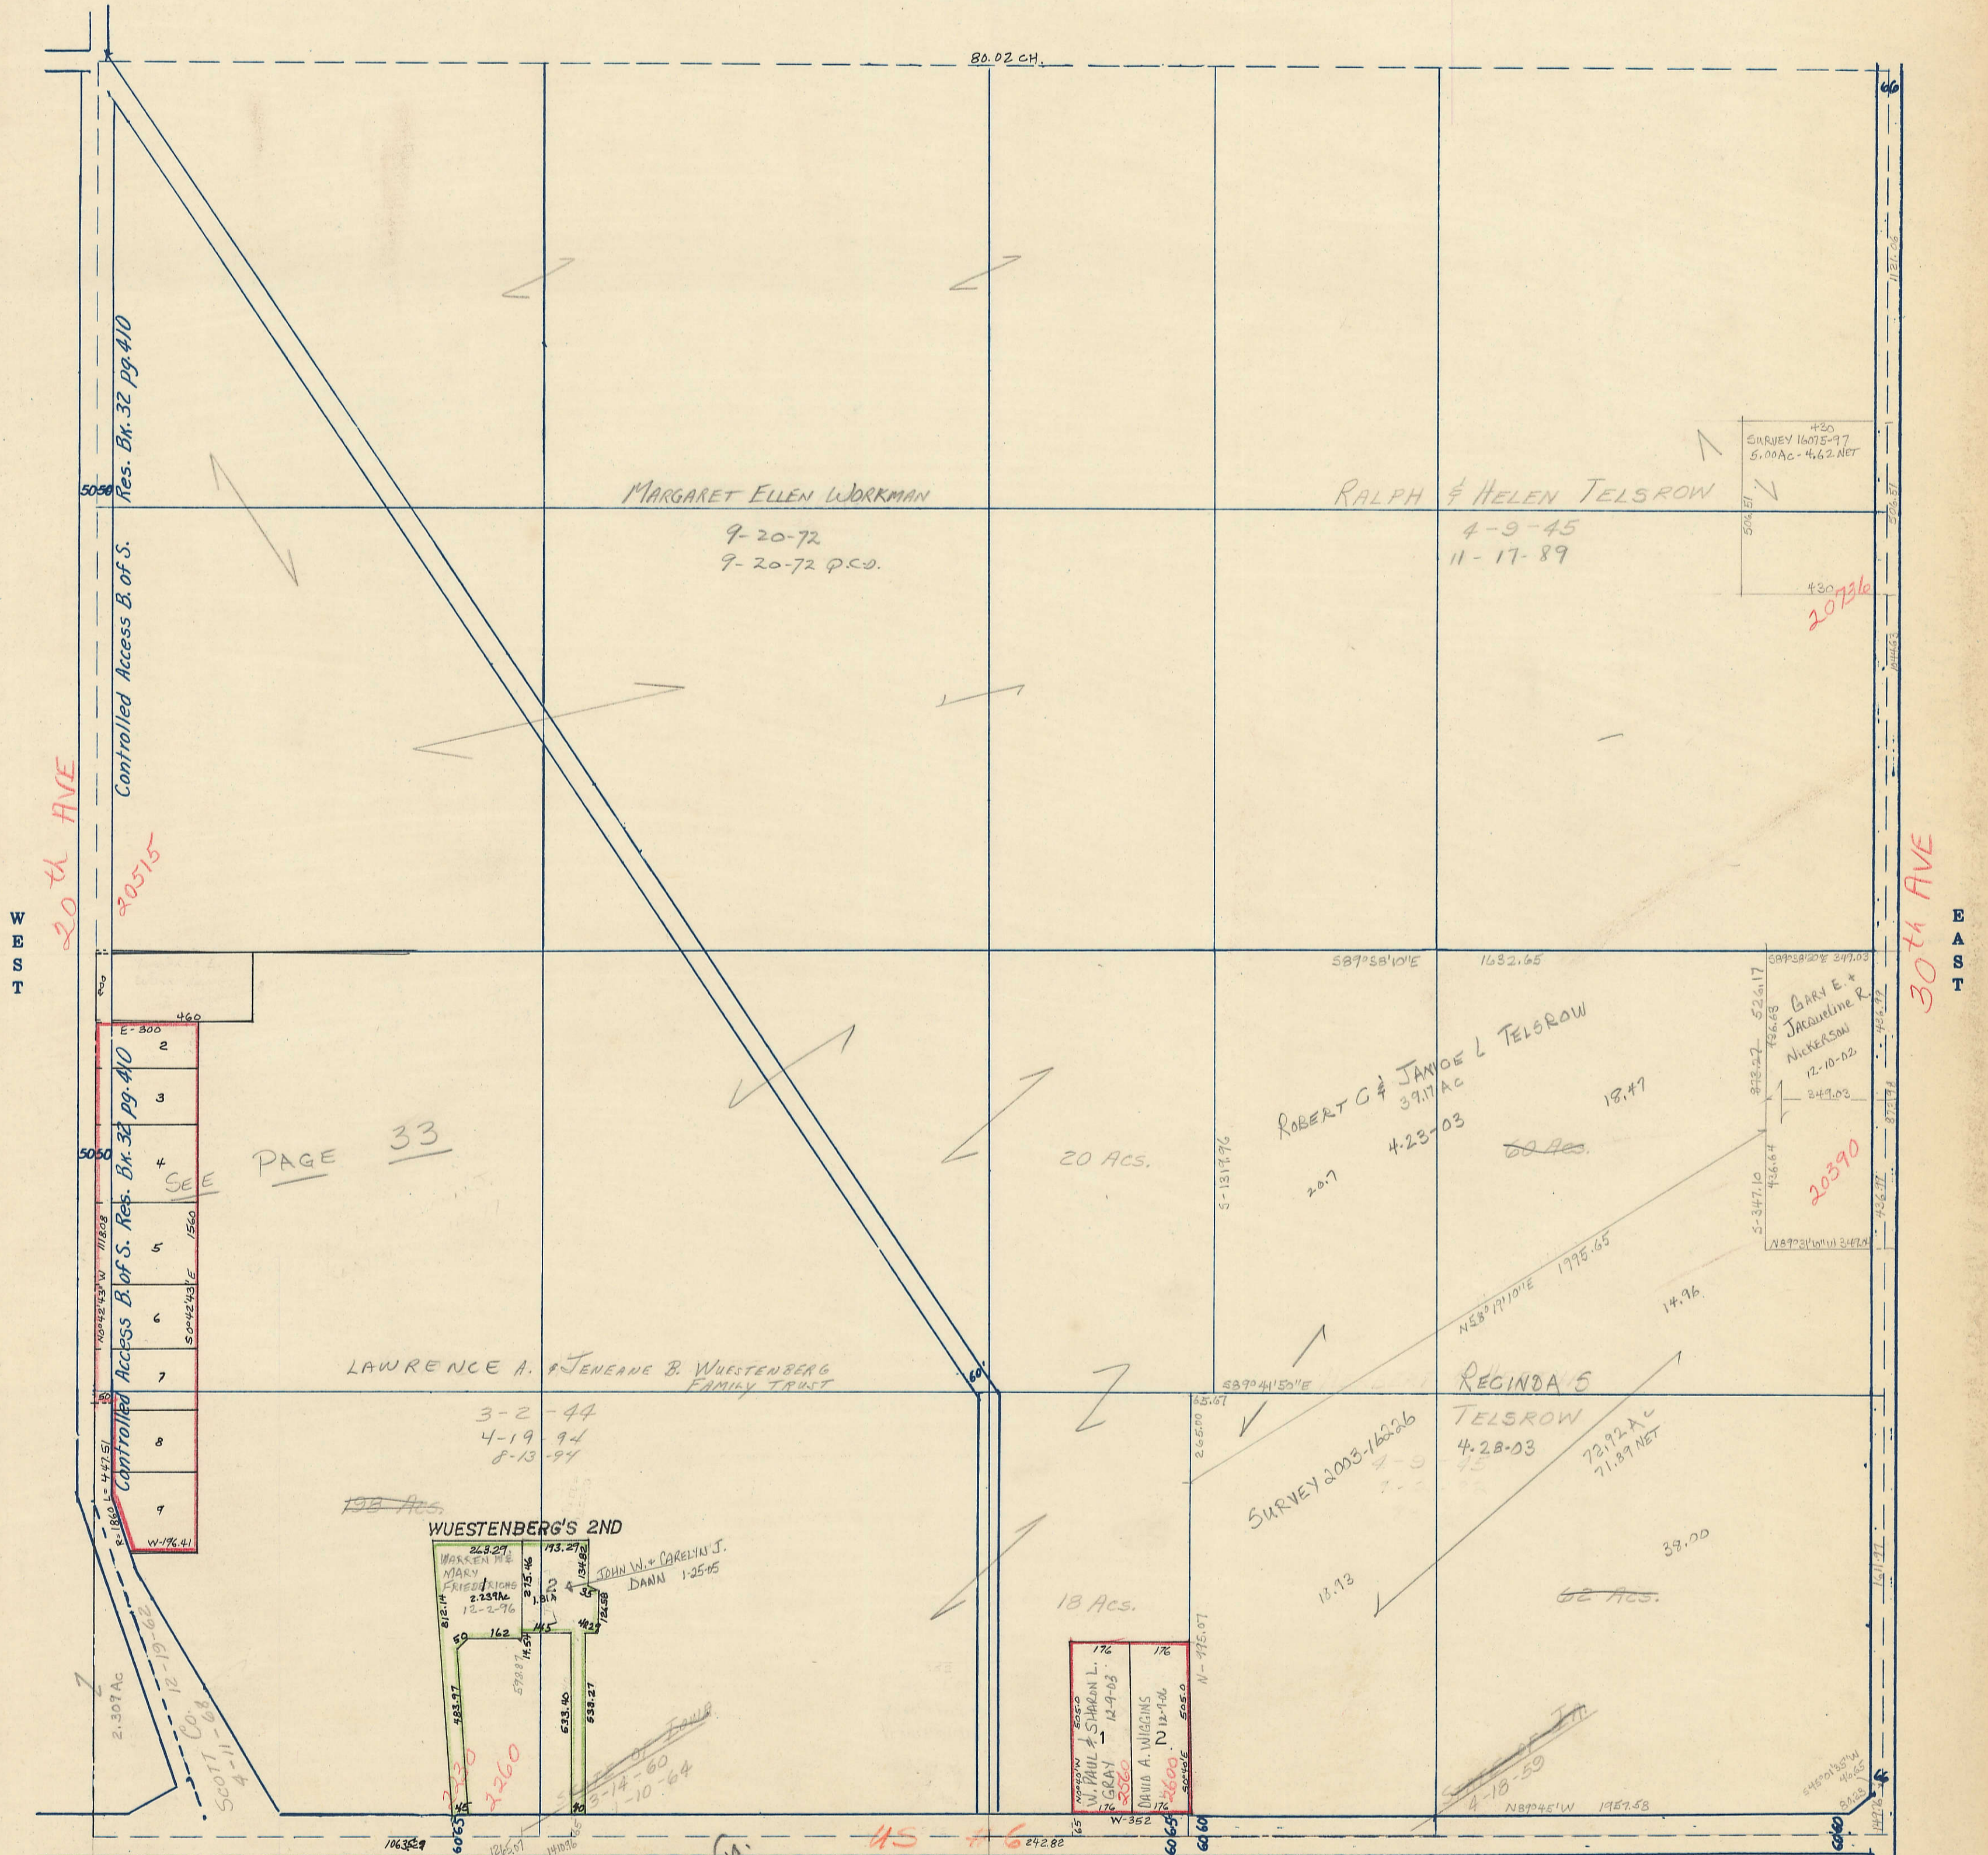

20th AVE  
Res. Bk. 32 pg 410

WEST  
20th AVE

EAST  
30th AVE


Controlled Access B. of S.

Controlled Access B. of S. Res. Bk. 32 pg 410

SEE PAGE 33


LAWRENCE A. & JENEANE B. WUESTENBERG FAMILY TRUST  
3-2-44  
4-19-94  
8-13-94

WUESTENBERG'S 2ND

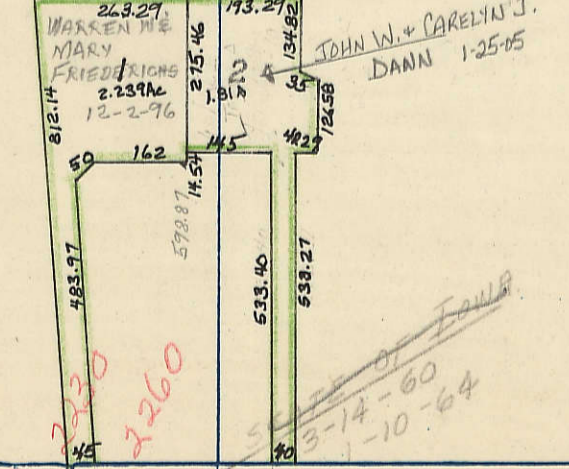

JOHN W. & CAROLYN J. DANN 1-25-65

SCOTT Co.  

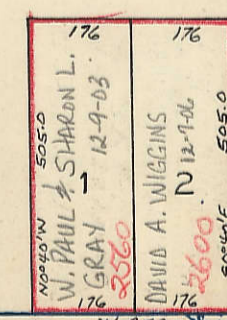


SOUTH

Transfer Page 1608 T.L.