


DONALD H. HOLST TRUST - UND 1/2 INT.
 MARIETA R. HOLST TRUST - UND 1/2 INT.
 5-26-05

SEE SECTION 31
 GLEDNA TWP.

49


53

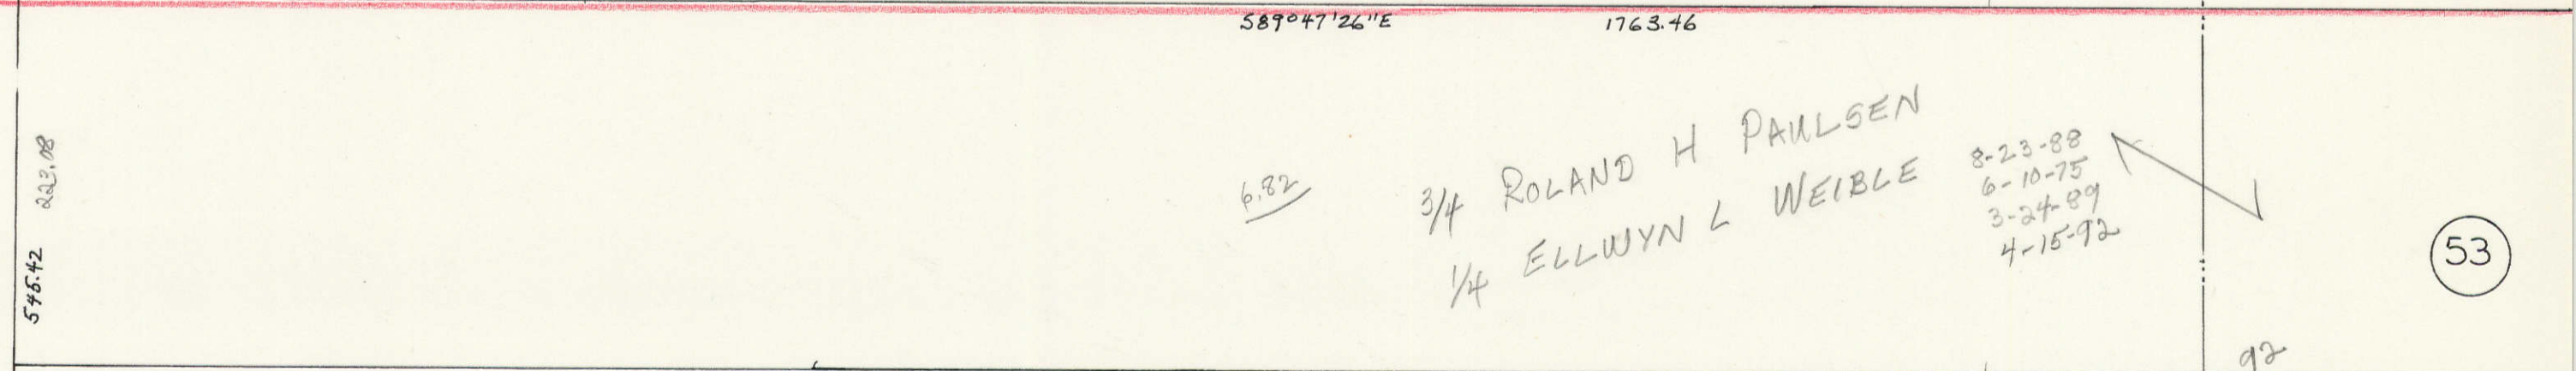


3/4 ROLAND H. PAULSEN
 1/4 ELLWYN L. WEIBLE

8-23-88
 6-10-75
 3-24-89
 4-15-92

SURVEY 18248-92

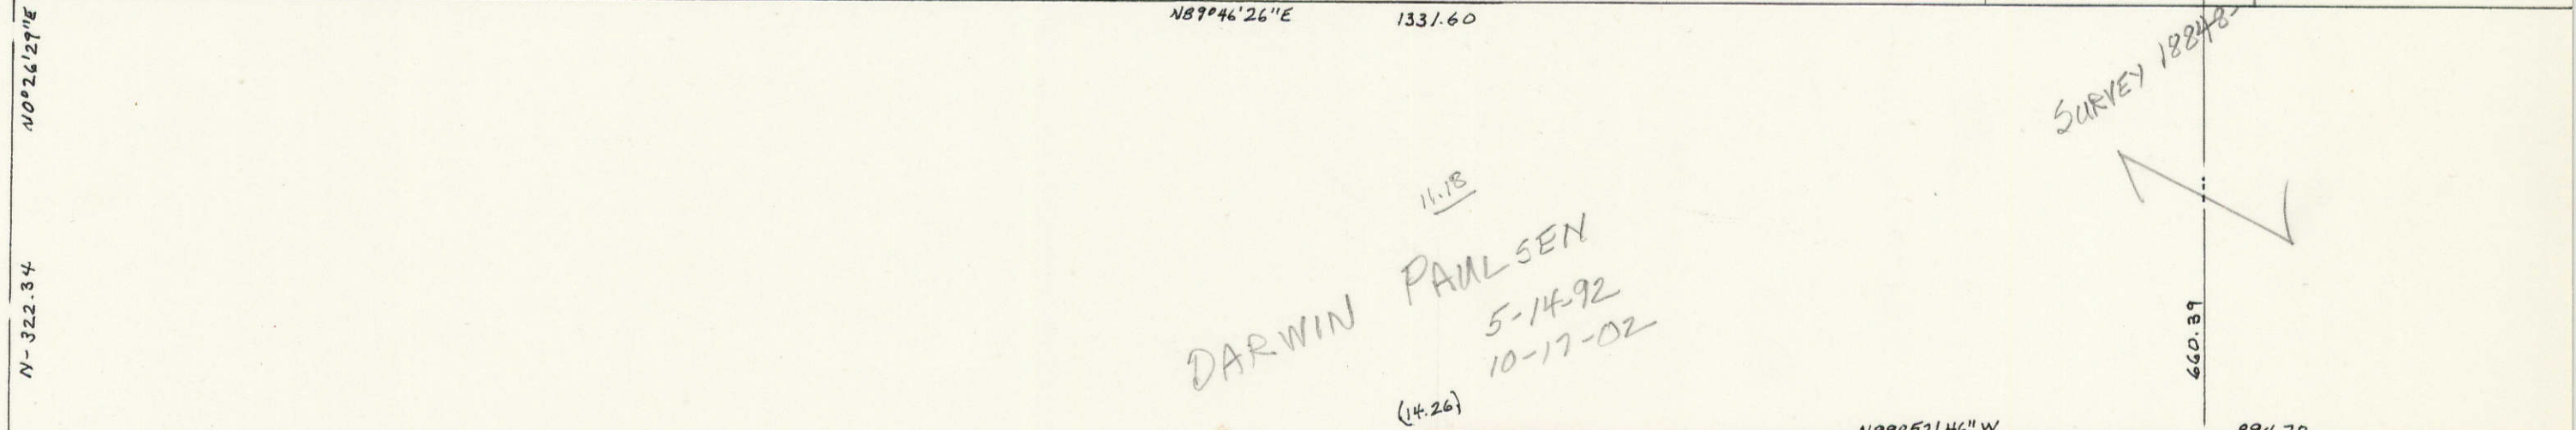

DARWIN PAULSEN
 5-14-92
 10-17-02

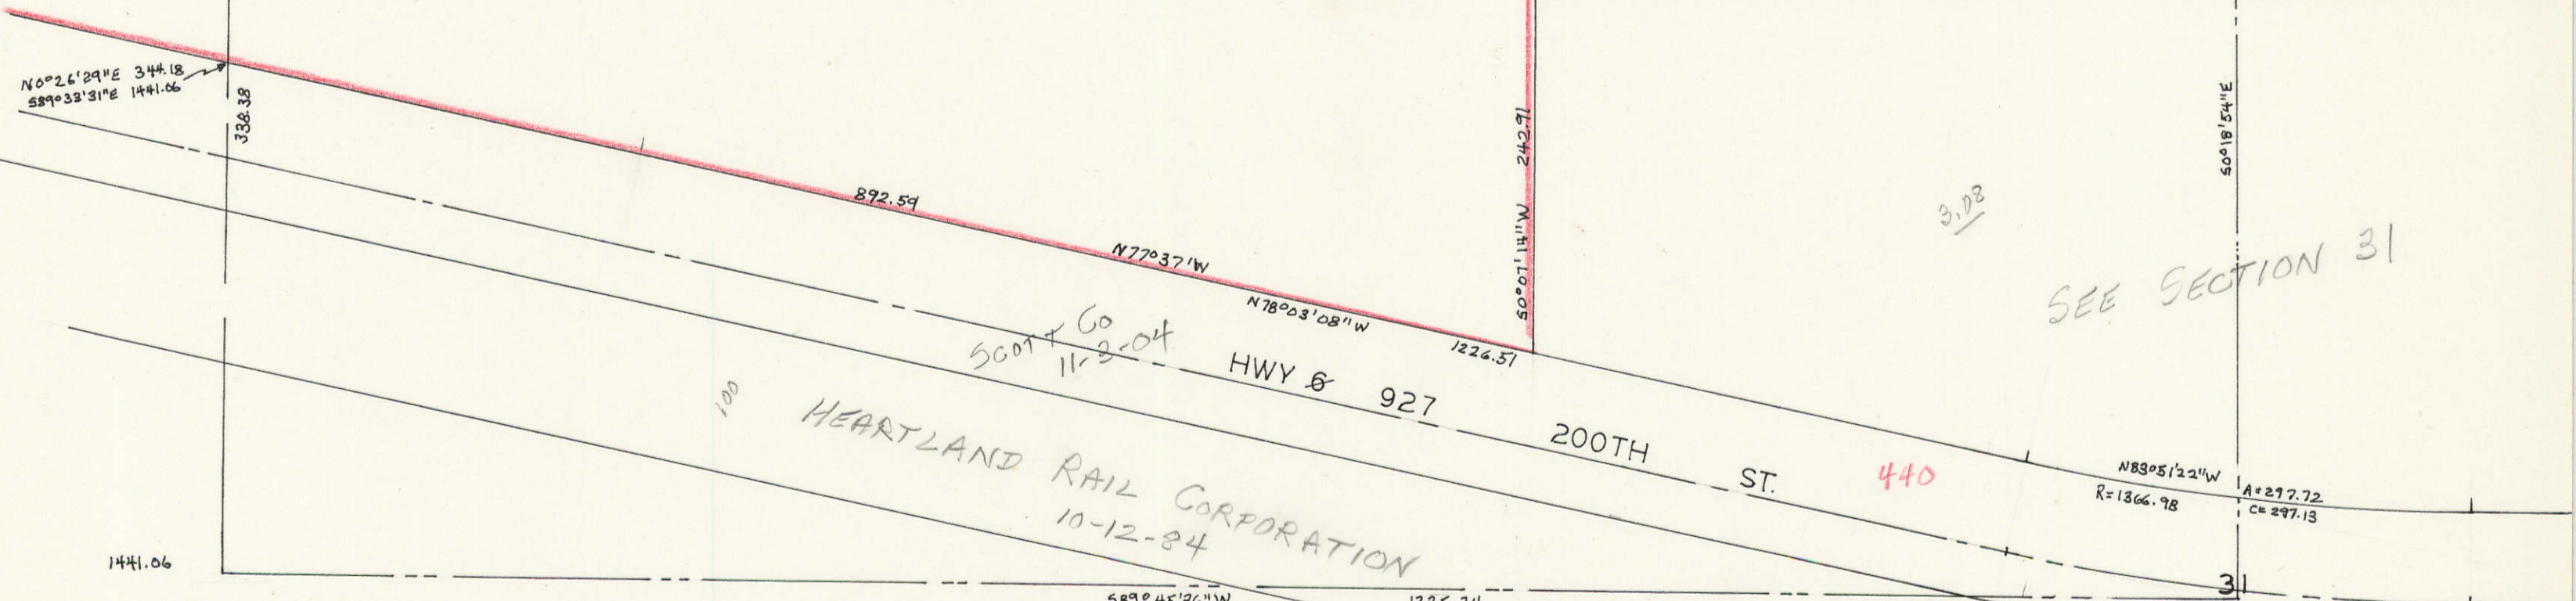

HEARTLAND RAIL CORPORATION
 10-12-84

SEE SECTION 31

1441.06

31