


5

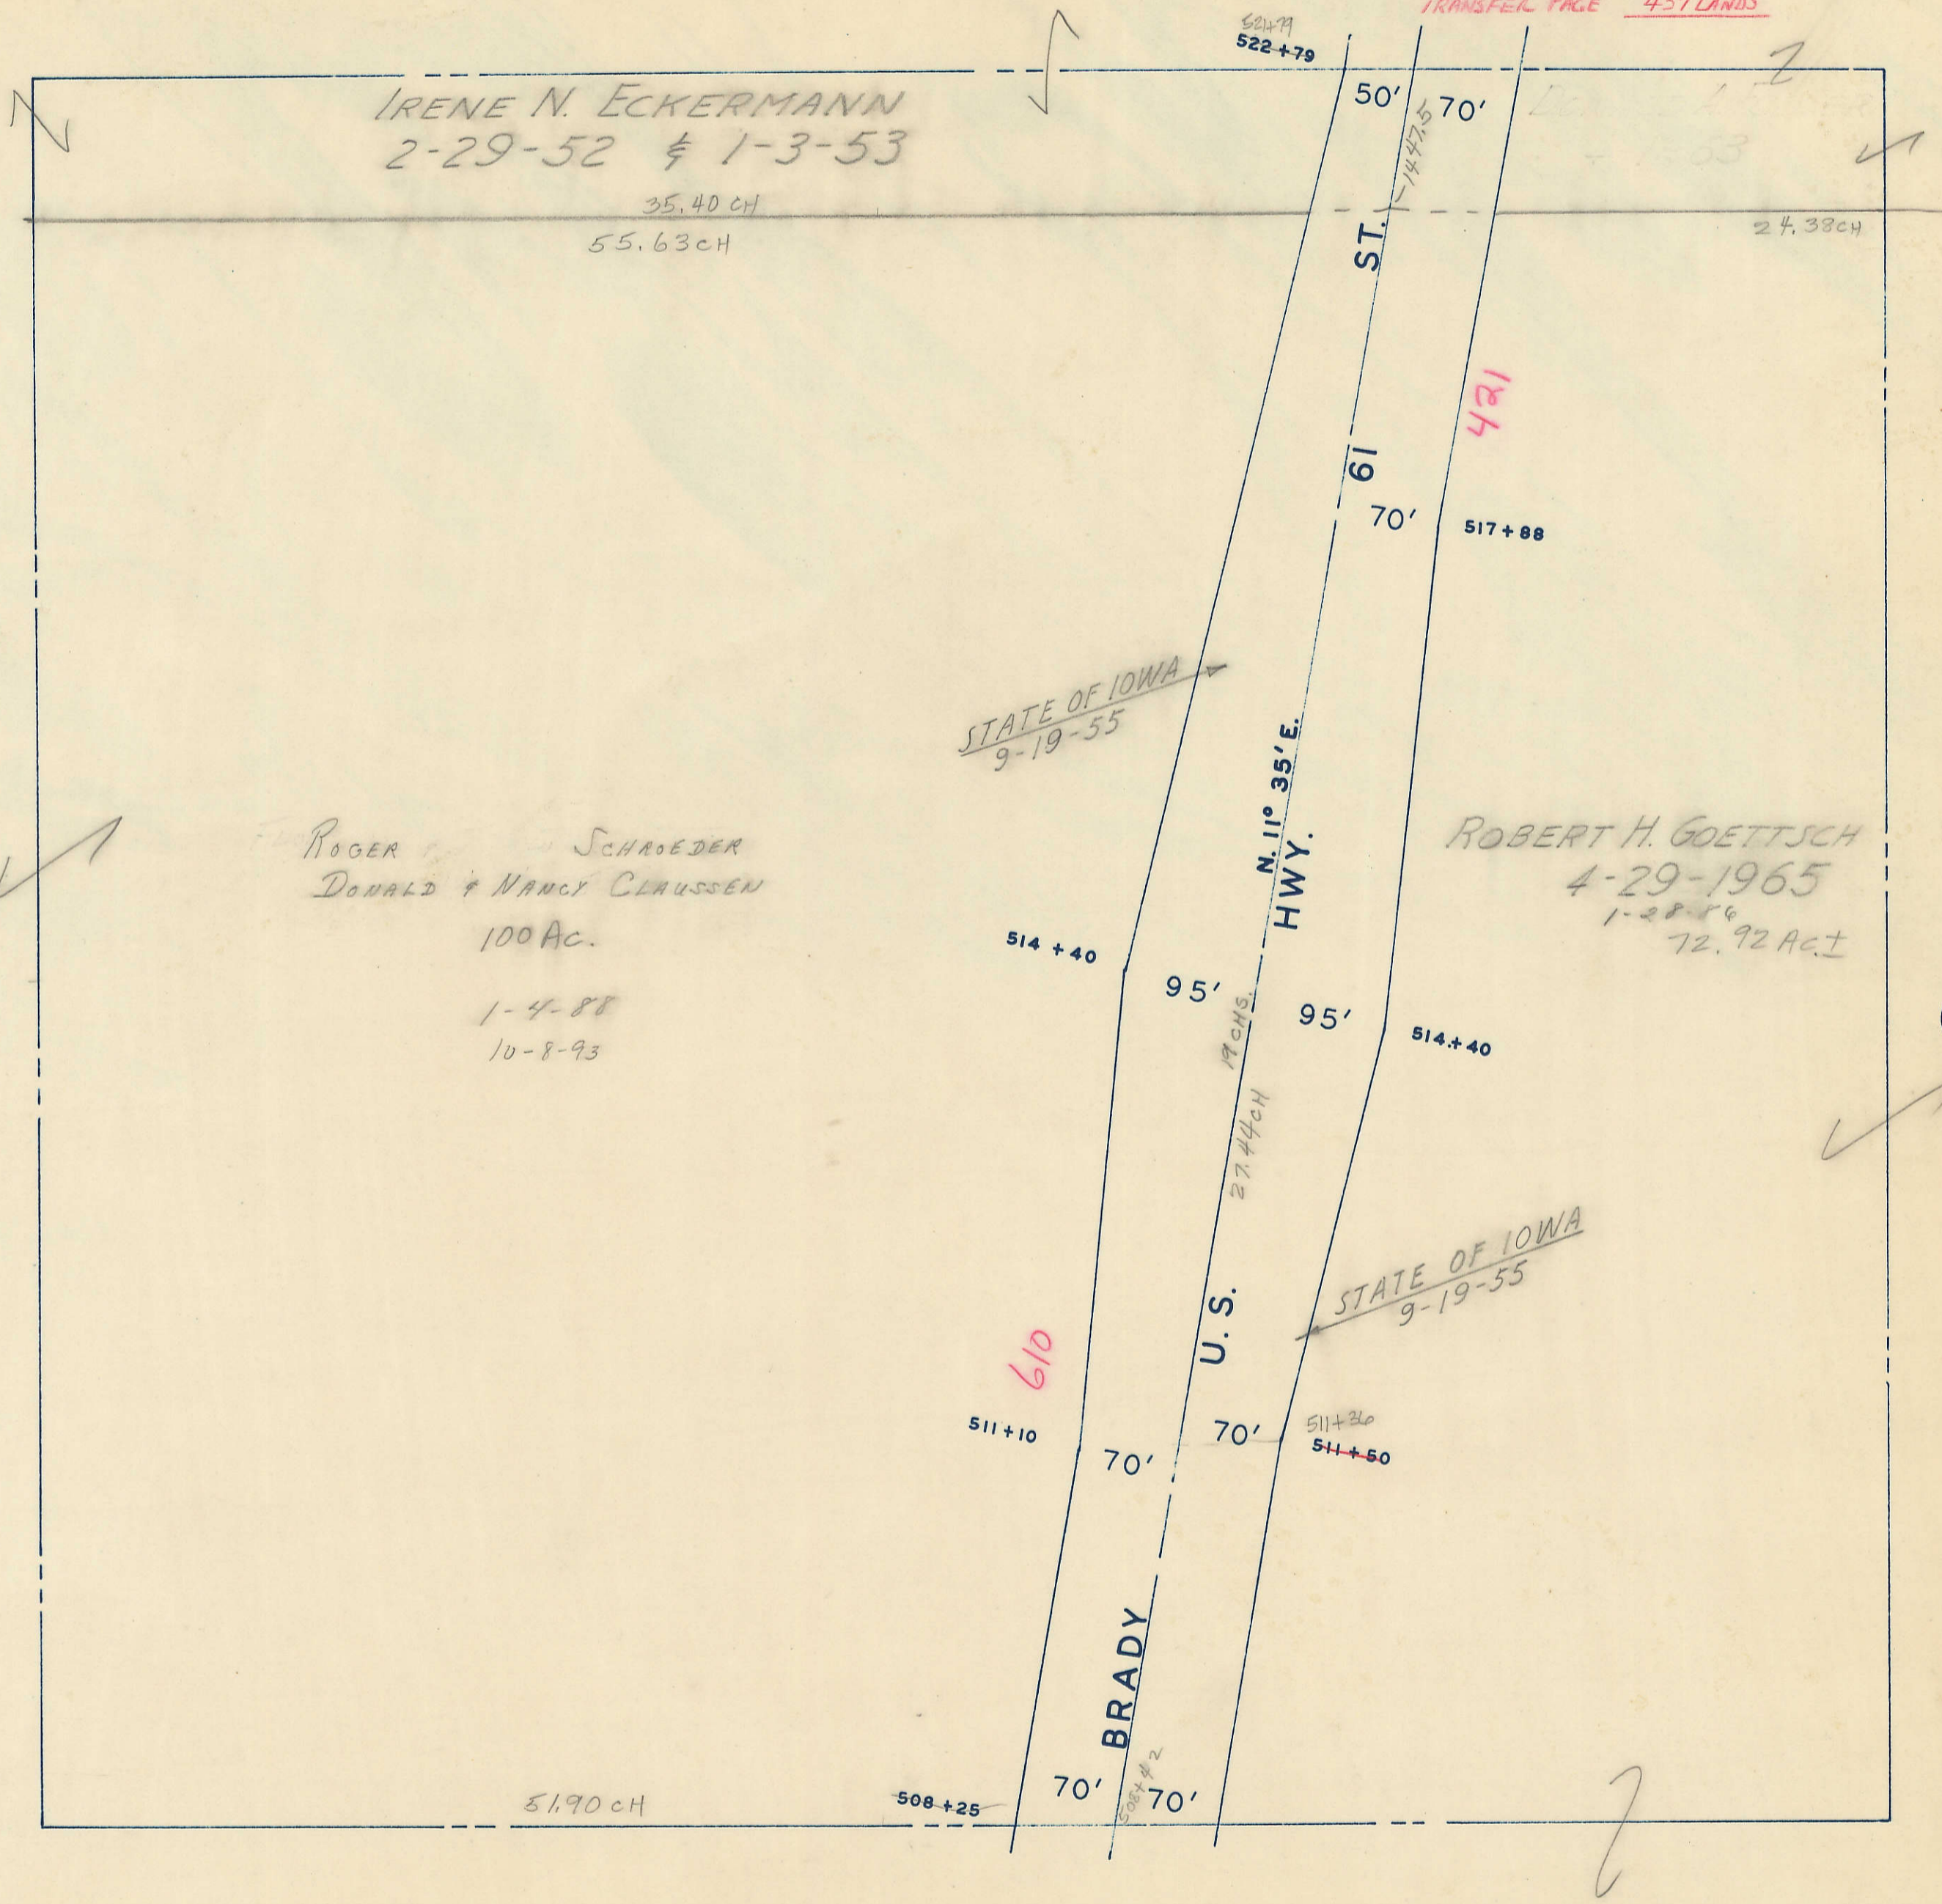

19

23

37