


(33)

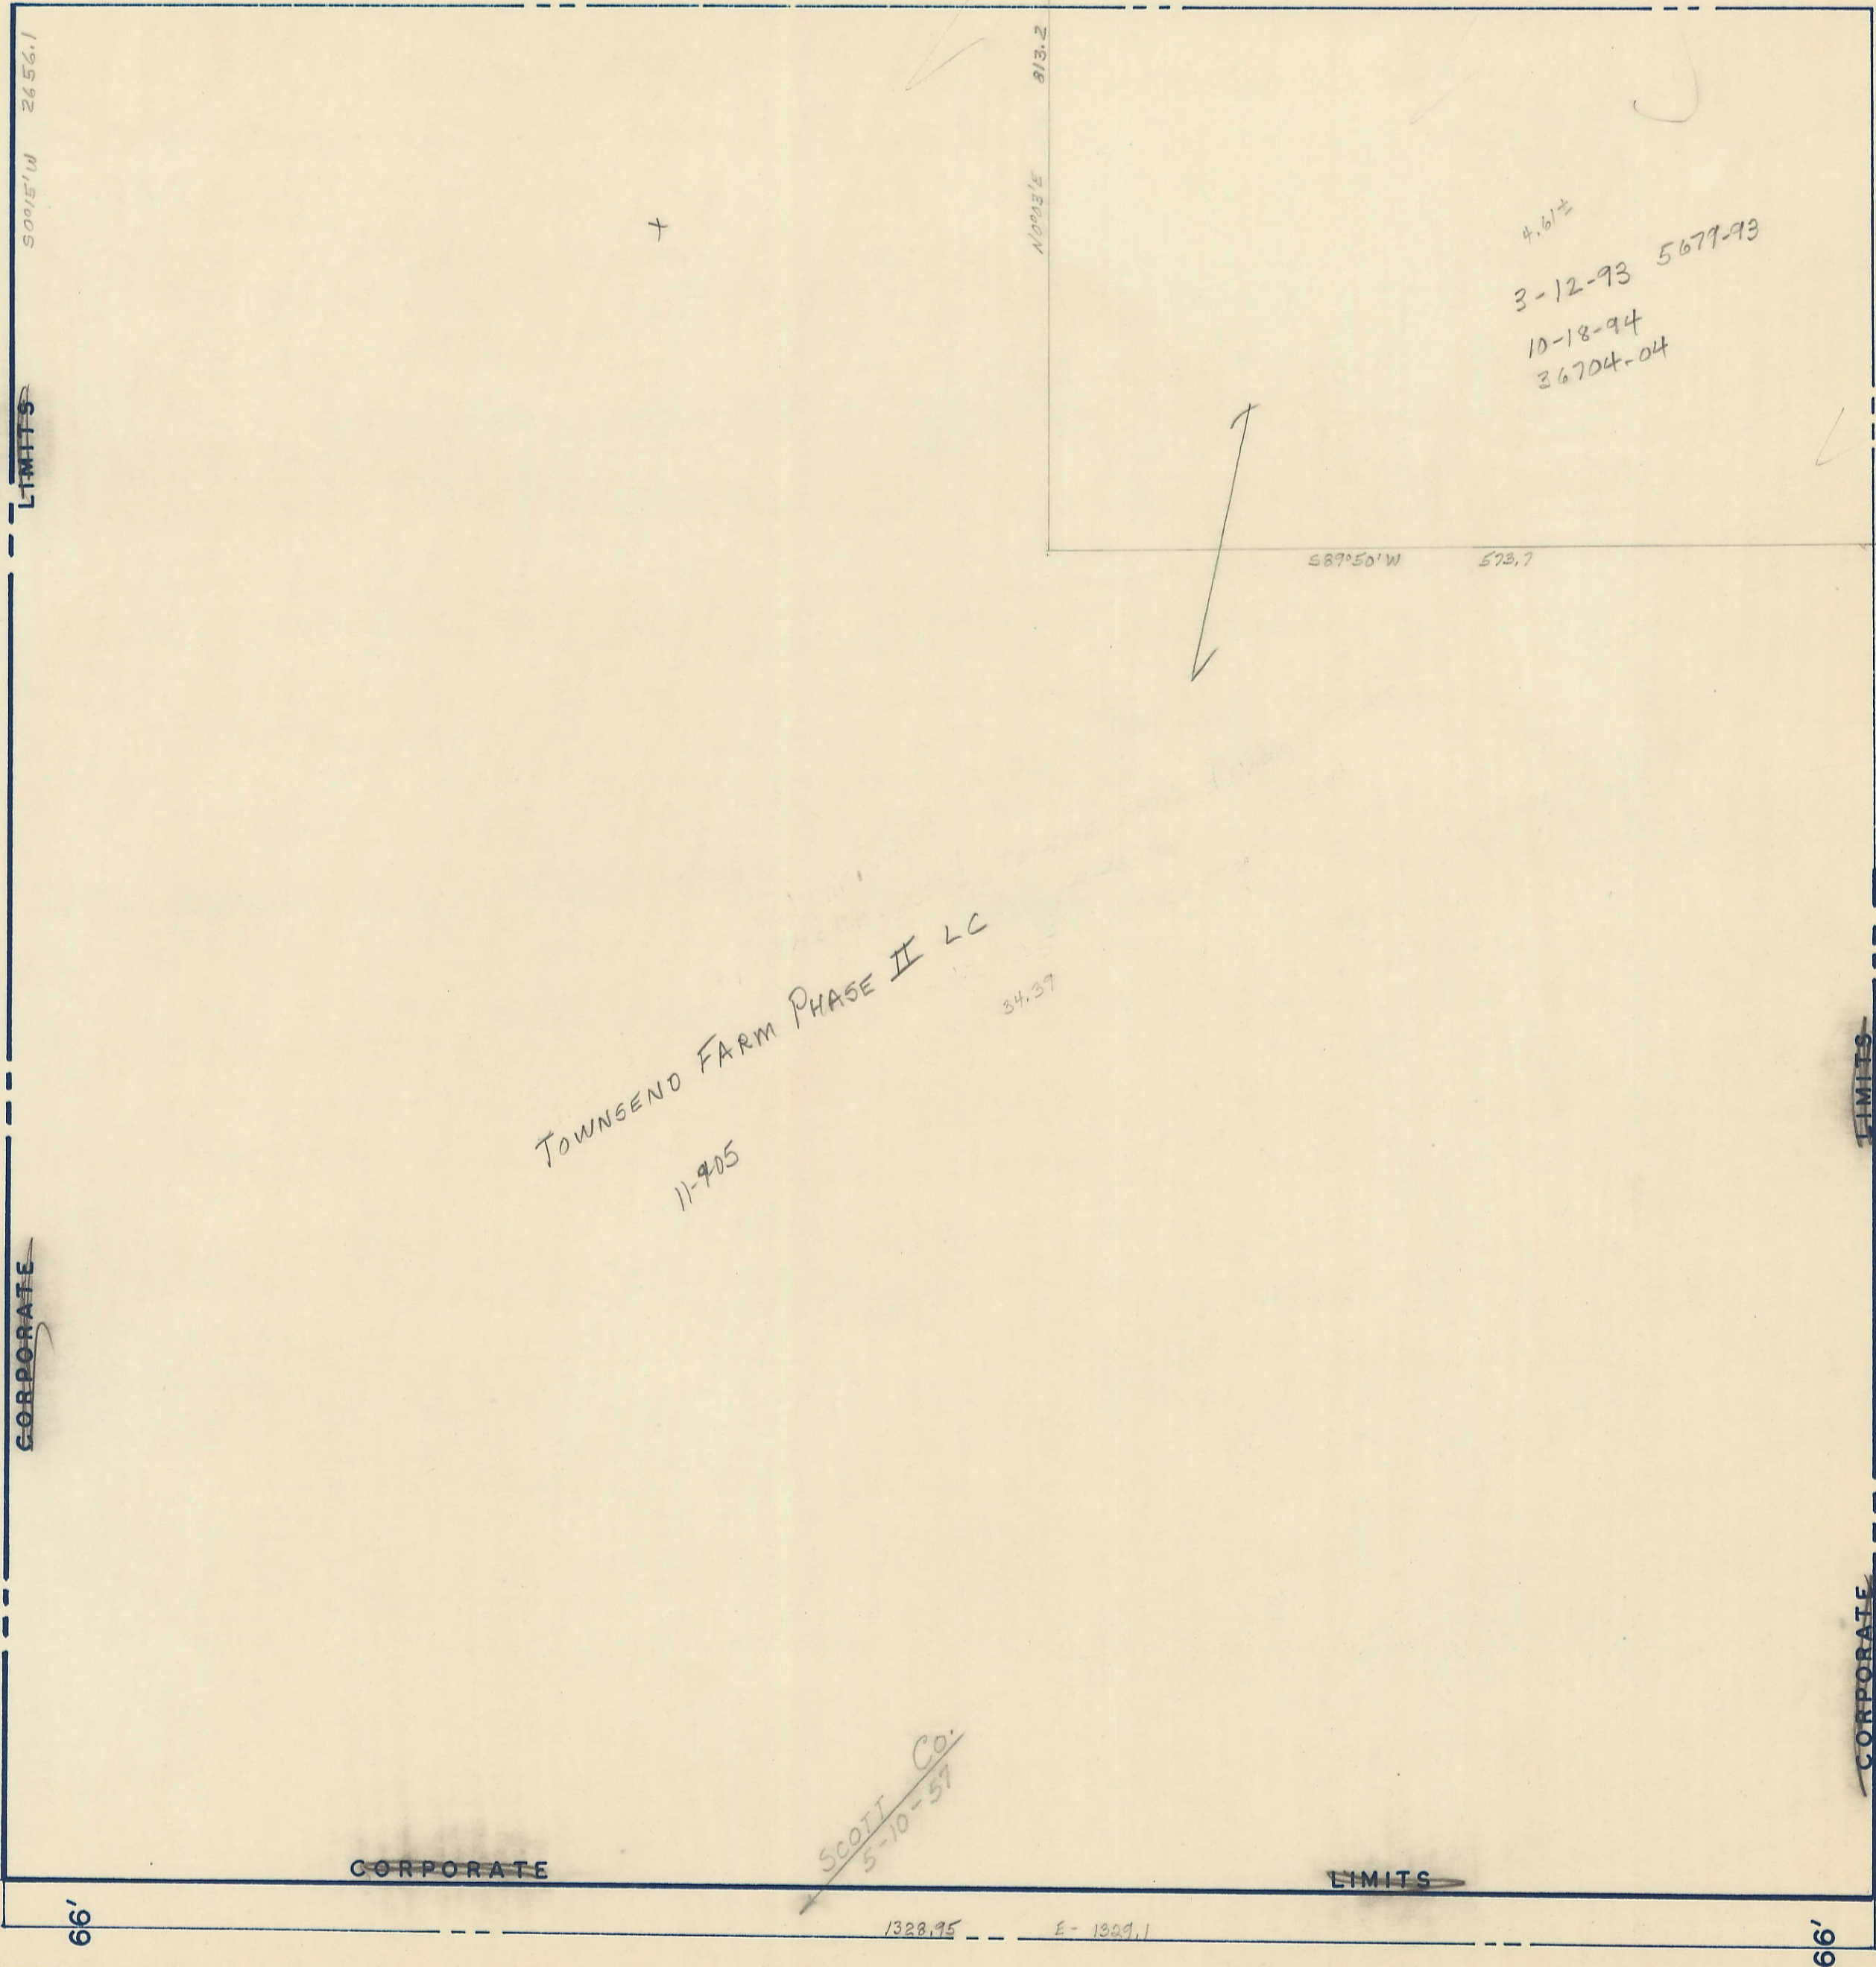

4.61±  
3-12-93 5679-93  
10-18-94  
36704-04

TOWNSEND FARM PHASE II LC  
11-905  
34.37

SCOTT Co.  
5-10-57

(51)