


SW 1/4 SW 1/4 SEC. 24-79-3
SCALE: 1"=100'

55
SEC 23

HWY 61

STATE OF IOWA
12-5-79

SEC 25

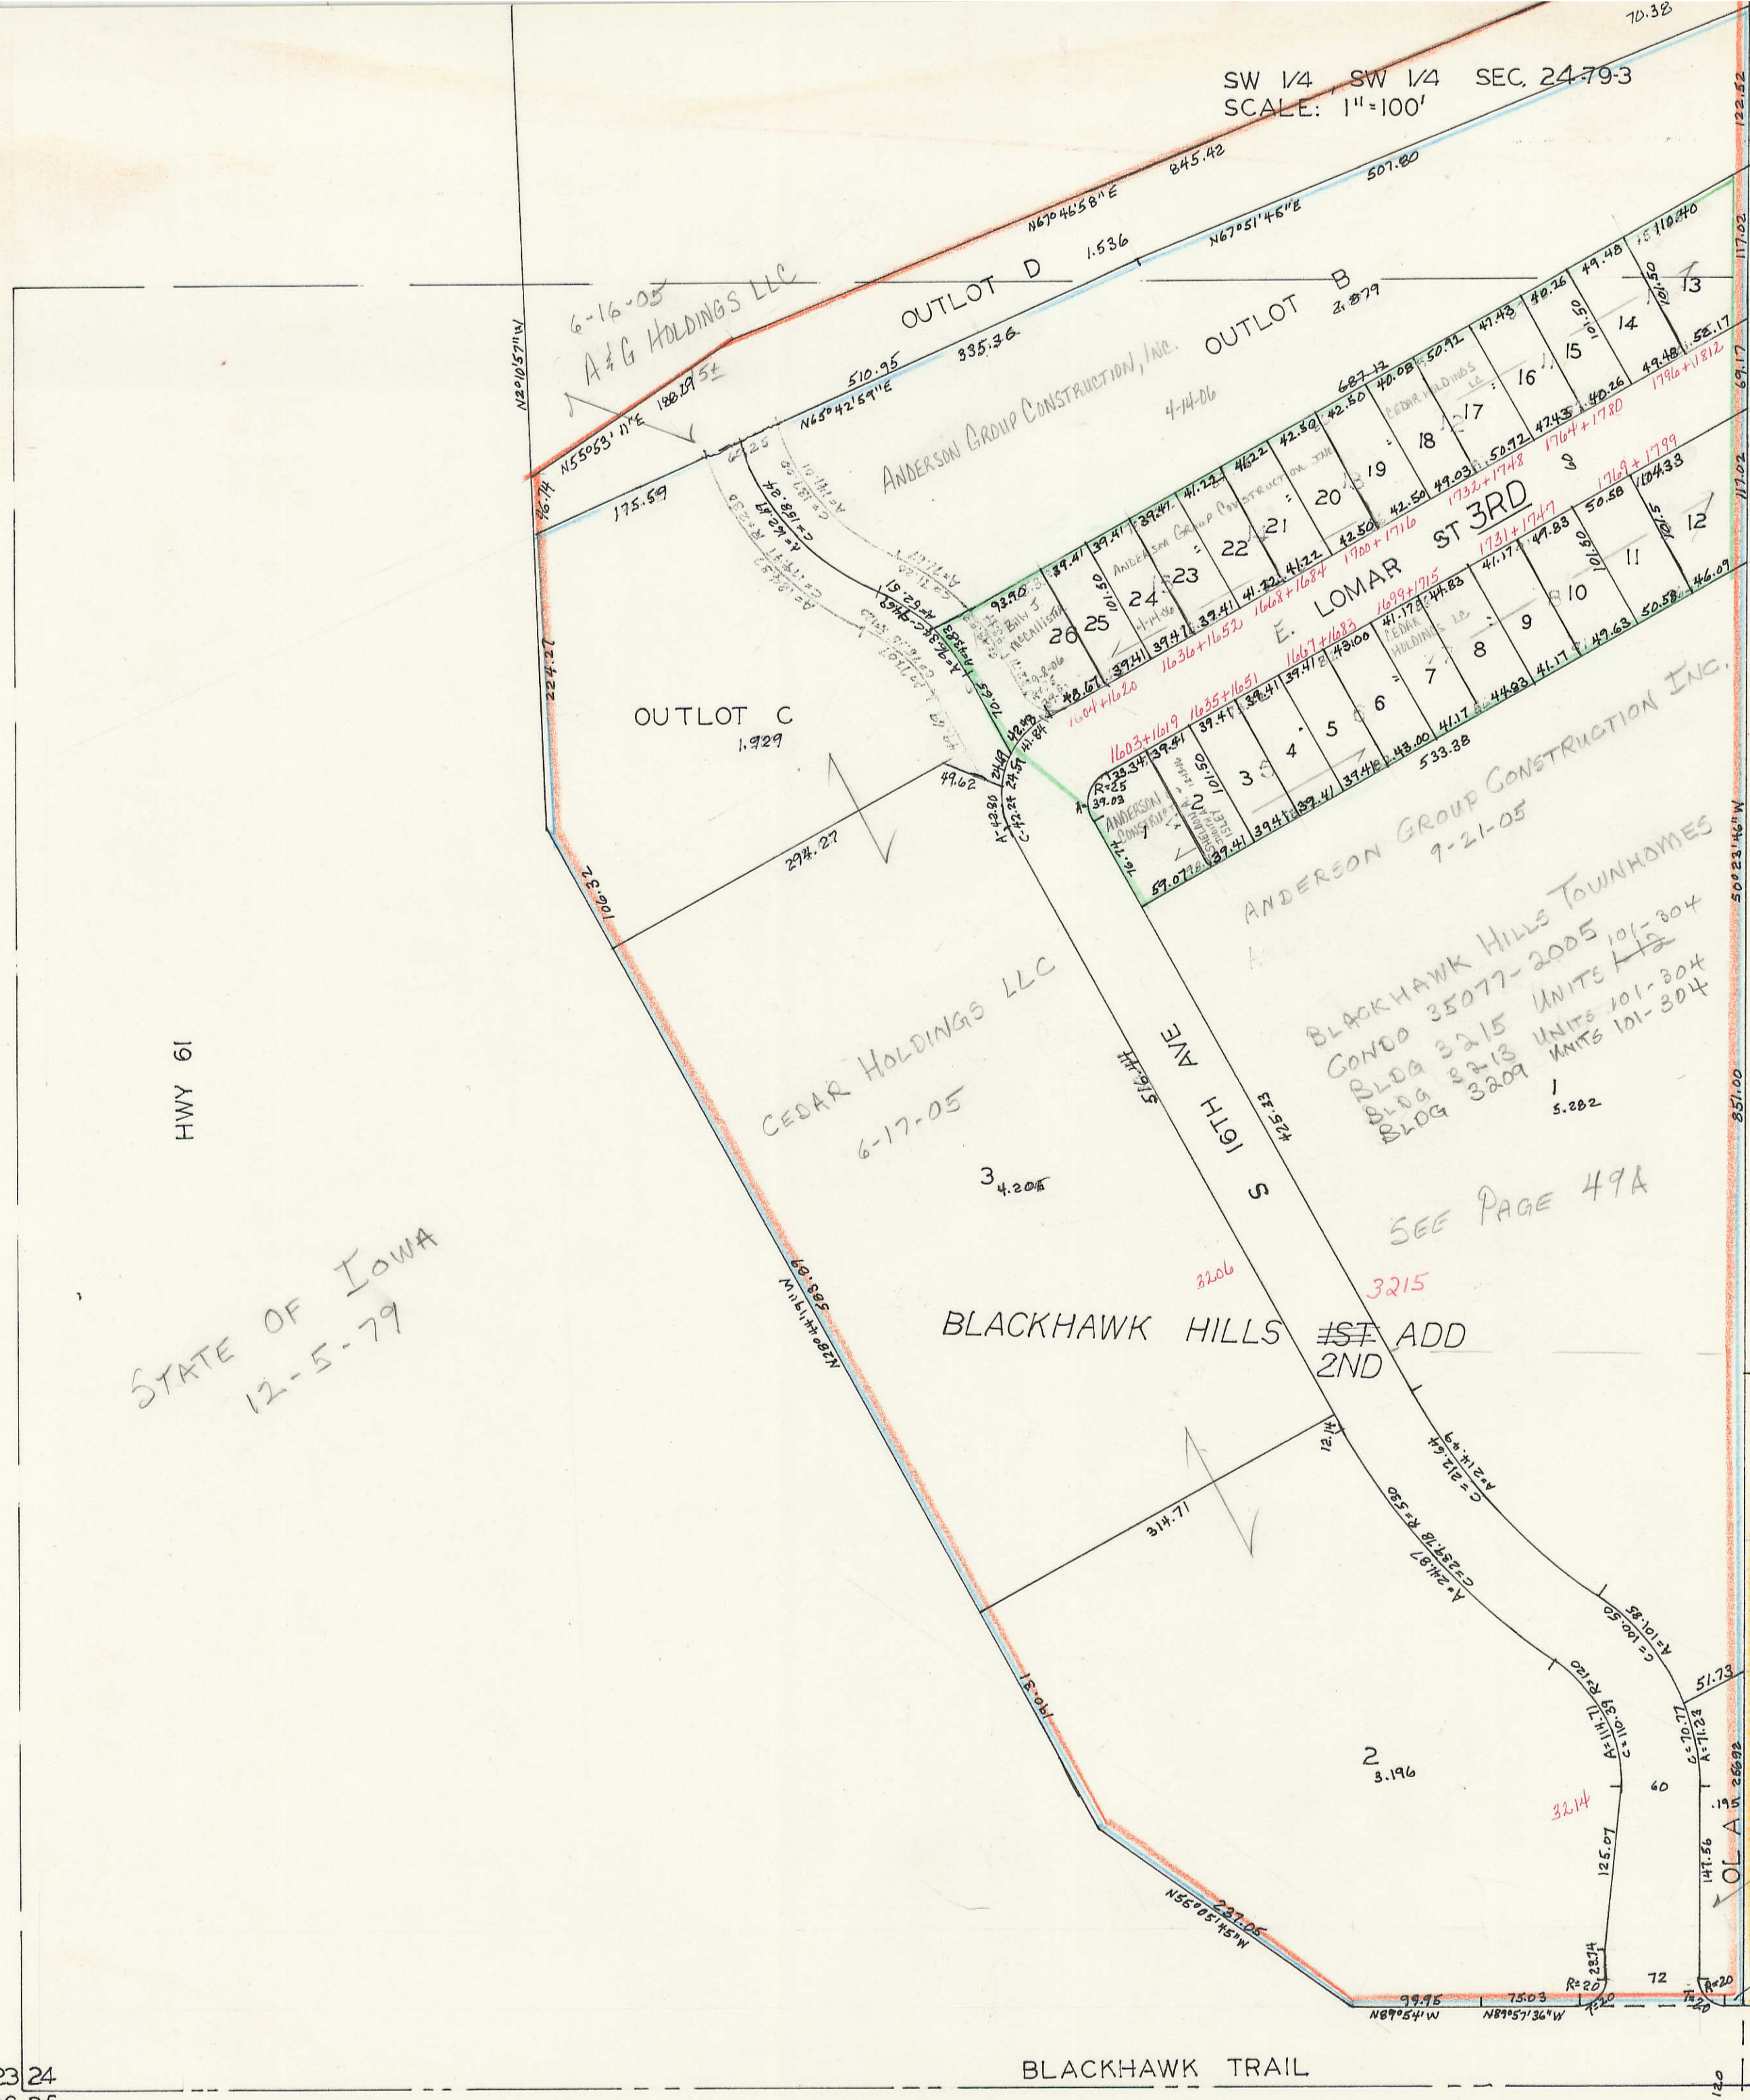

ANDERSON GROUP CONSTRUCTION INC.
9-21-05

BLACKHAWK HILLS TOWNHOMES
CONDO 35077-2005 UNITS 101-304
BLDG 3215 UNITS 101-304
BLDG 3213 UNITS 101-304
BLDG 3209 UNITS 101-304
1 5.282

SEE PAGE 49A

BLACKHAWK HILLS #1ST ADD 2ND

BLACKHAWK TRAIL

23 24
26 25

51

