

SECTION 16

SCALE IN CHAINS





Township 79-North; Range 2

EAST OF THE FIFTH PRINCIPAL MERIDIAN

SCOTT COUNTY, IOWA
HICKORY GROVE TOWNSHIP

NORTH

SCALE IN FEET

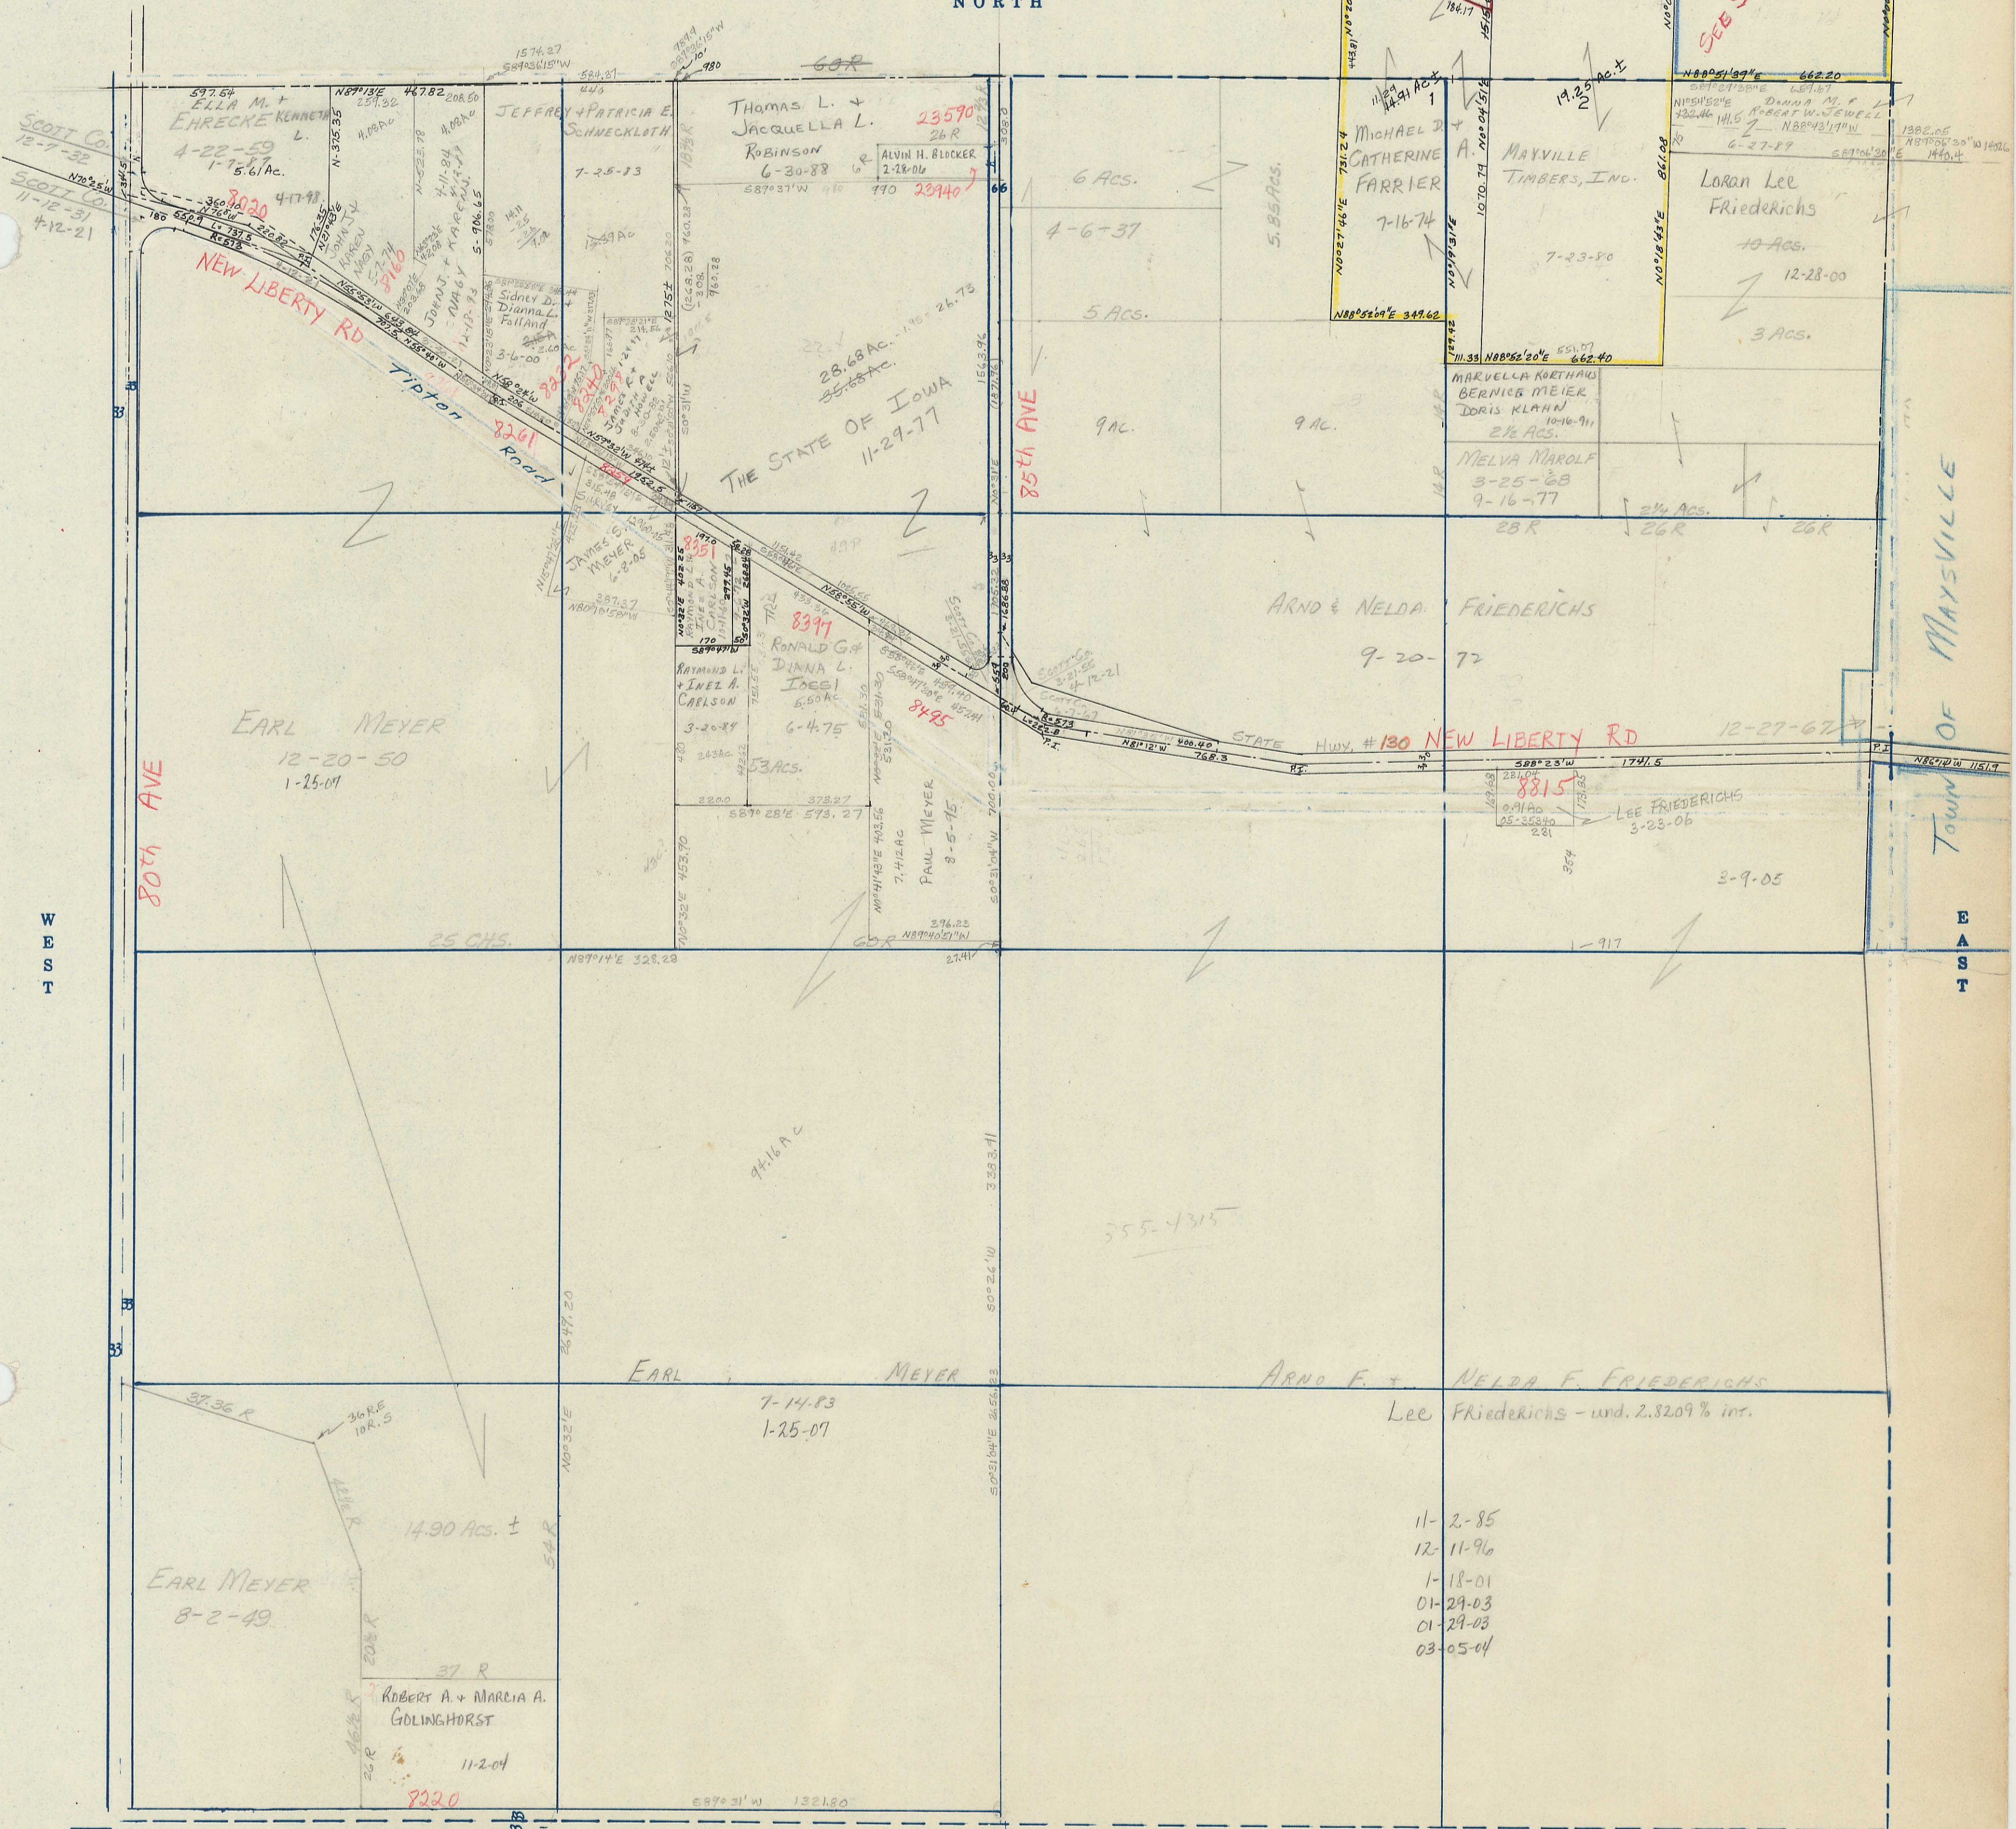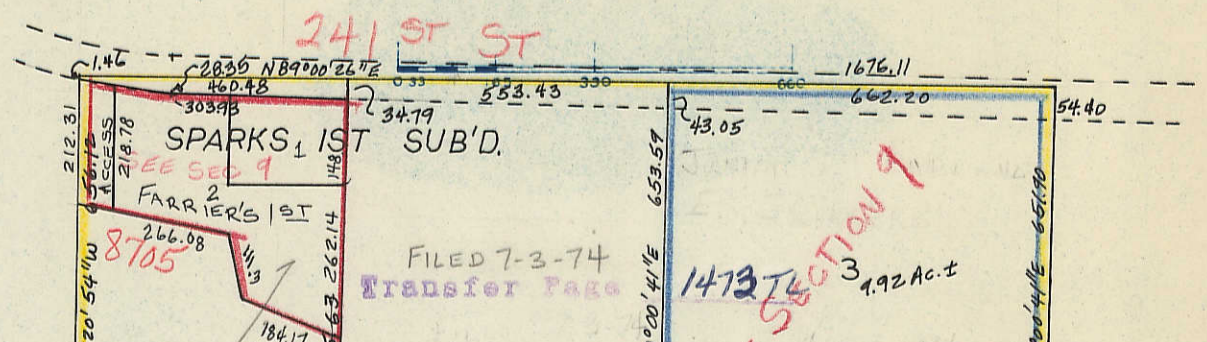

WEST

EAST

SOUTH

- 11-2-85
- 12-11-96
- 1-18-01
- 01-29-03
- 01-29-03
- 03-05-04