

SECTION
17


SCALE IN CHAINS



Township 79-North; Range 2

EAST OF THE FIFTH PRINCIPAL MERIDIAN


SCALE IN FEET

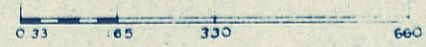

SCOTT COUNTY, IOWA
HICKORY GROVE TOWNSHIP

Transfer Page 238

NORTH

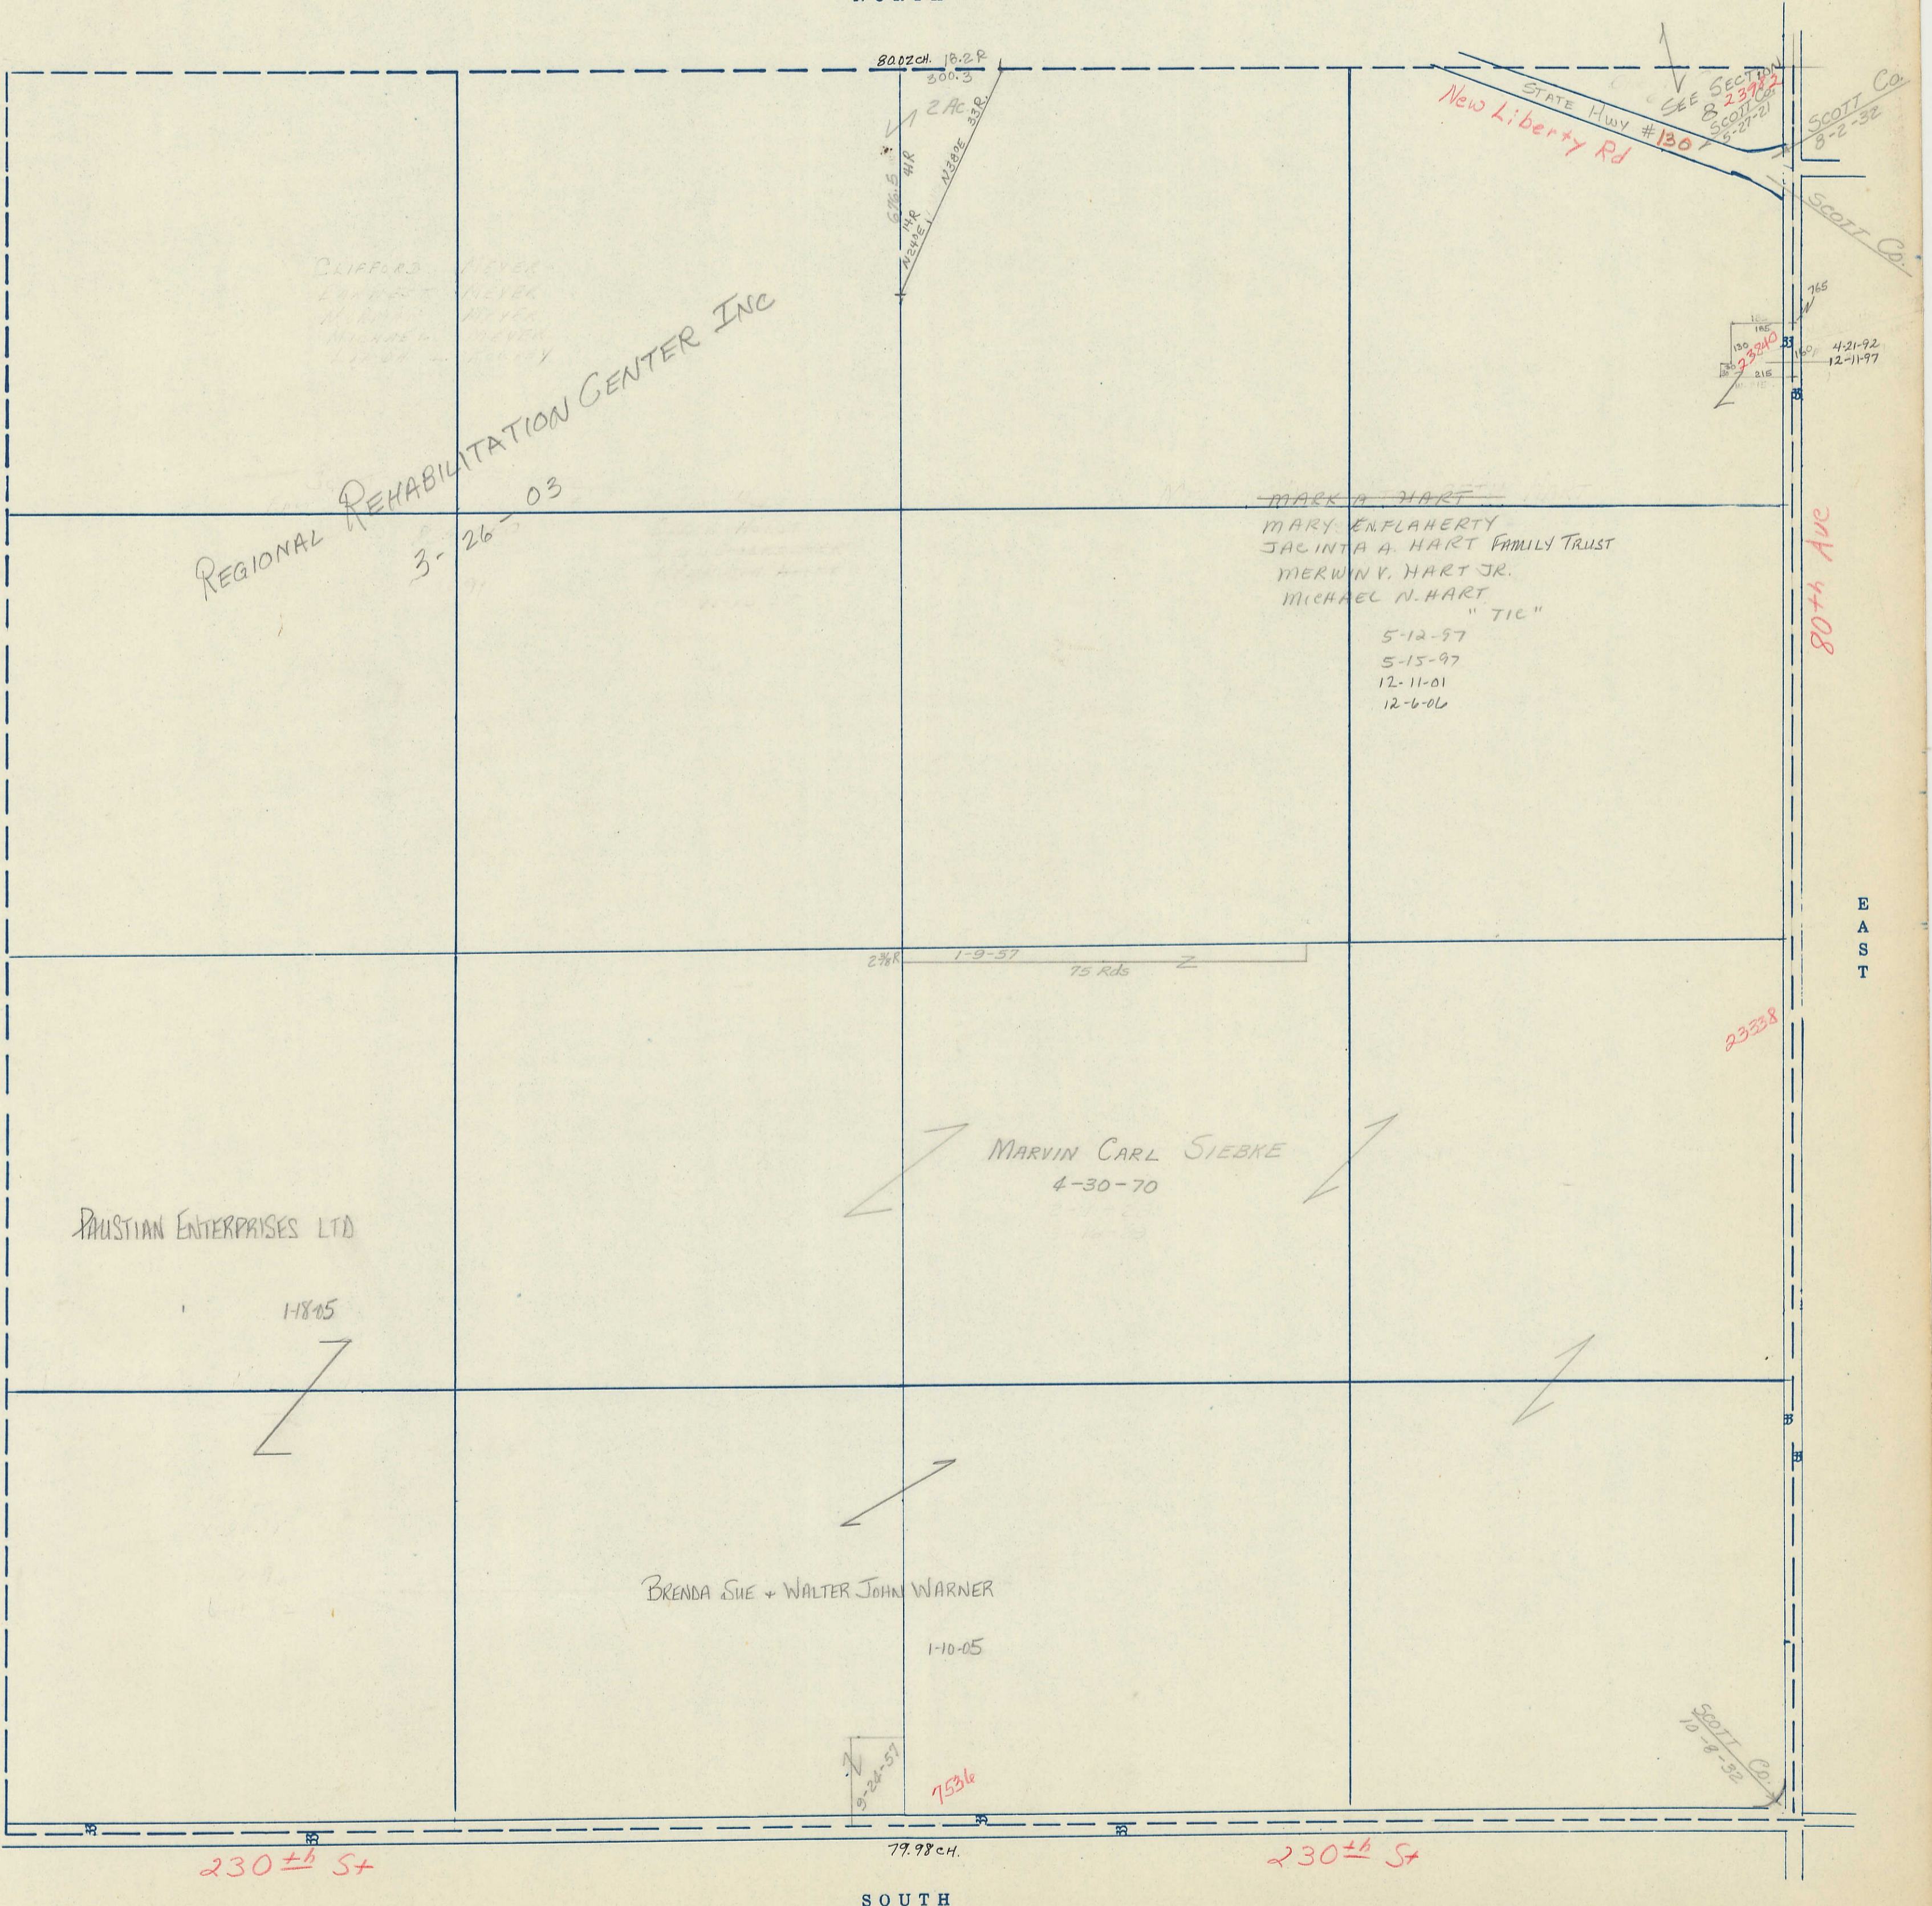

CLIFFORD MEYER
LARRY MEYER
MICHAEL MEYER
LINDA MEYER

REGIONAL REHABILITATION CENTER INC
3-26-03

MARK A HART
MARY ENFLAHERTY
JACINTA A. HART FAMILY TRUST
MERWIN V. HART JR.
MICHAEL N. HART
"TIC"
5-12-97
5-15-97
12-11-01
12-6-06

MARVIN CARL SIEBKE
4-30-70

BRENDA SUE + WALTER JOHN WARNER
1-10-05

PAUSTIAN ENTERPRISES LTD
1-18-05

8002 CH. 18.2 F
300.3
2 AC
6.76.5
4 HR

SEE SECTION 8
SCOTT Co
8-2-32
New Liberty Rd
STATE Hwy #1307

130
216
4-21-92
12-11-97

SCOTT Co
8-2-32

SCOTT Co
8-2-32

80th Ave

23328

9-24-57
7536

SCOTT Co
10-8-32

230± S+

79.98 CH.

230± S+

SOUTH

WEST

EAST