

SECTION
21

Township 79-North; Range 2

EAST OF THE FIFTH PRINCIPAL MERIDIAN


SCOTT COUNTY, IOWA
HICKORY GROVE TOWNSHIP

NORTH

SCALE IN CHAINS




SCALE IN FEET

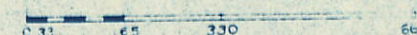

Transfer Page 242

VACATED 11-29-49

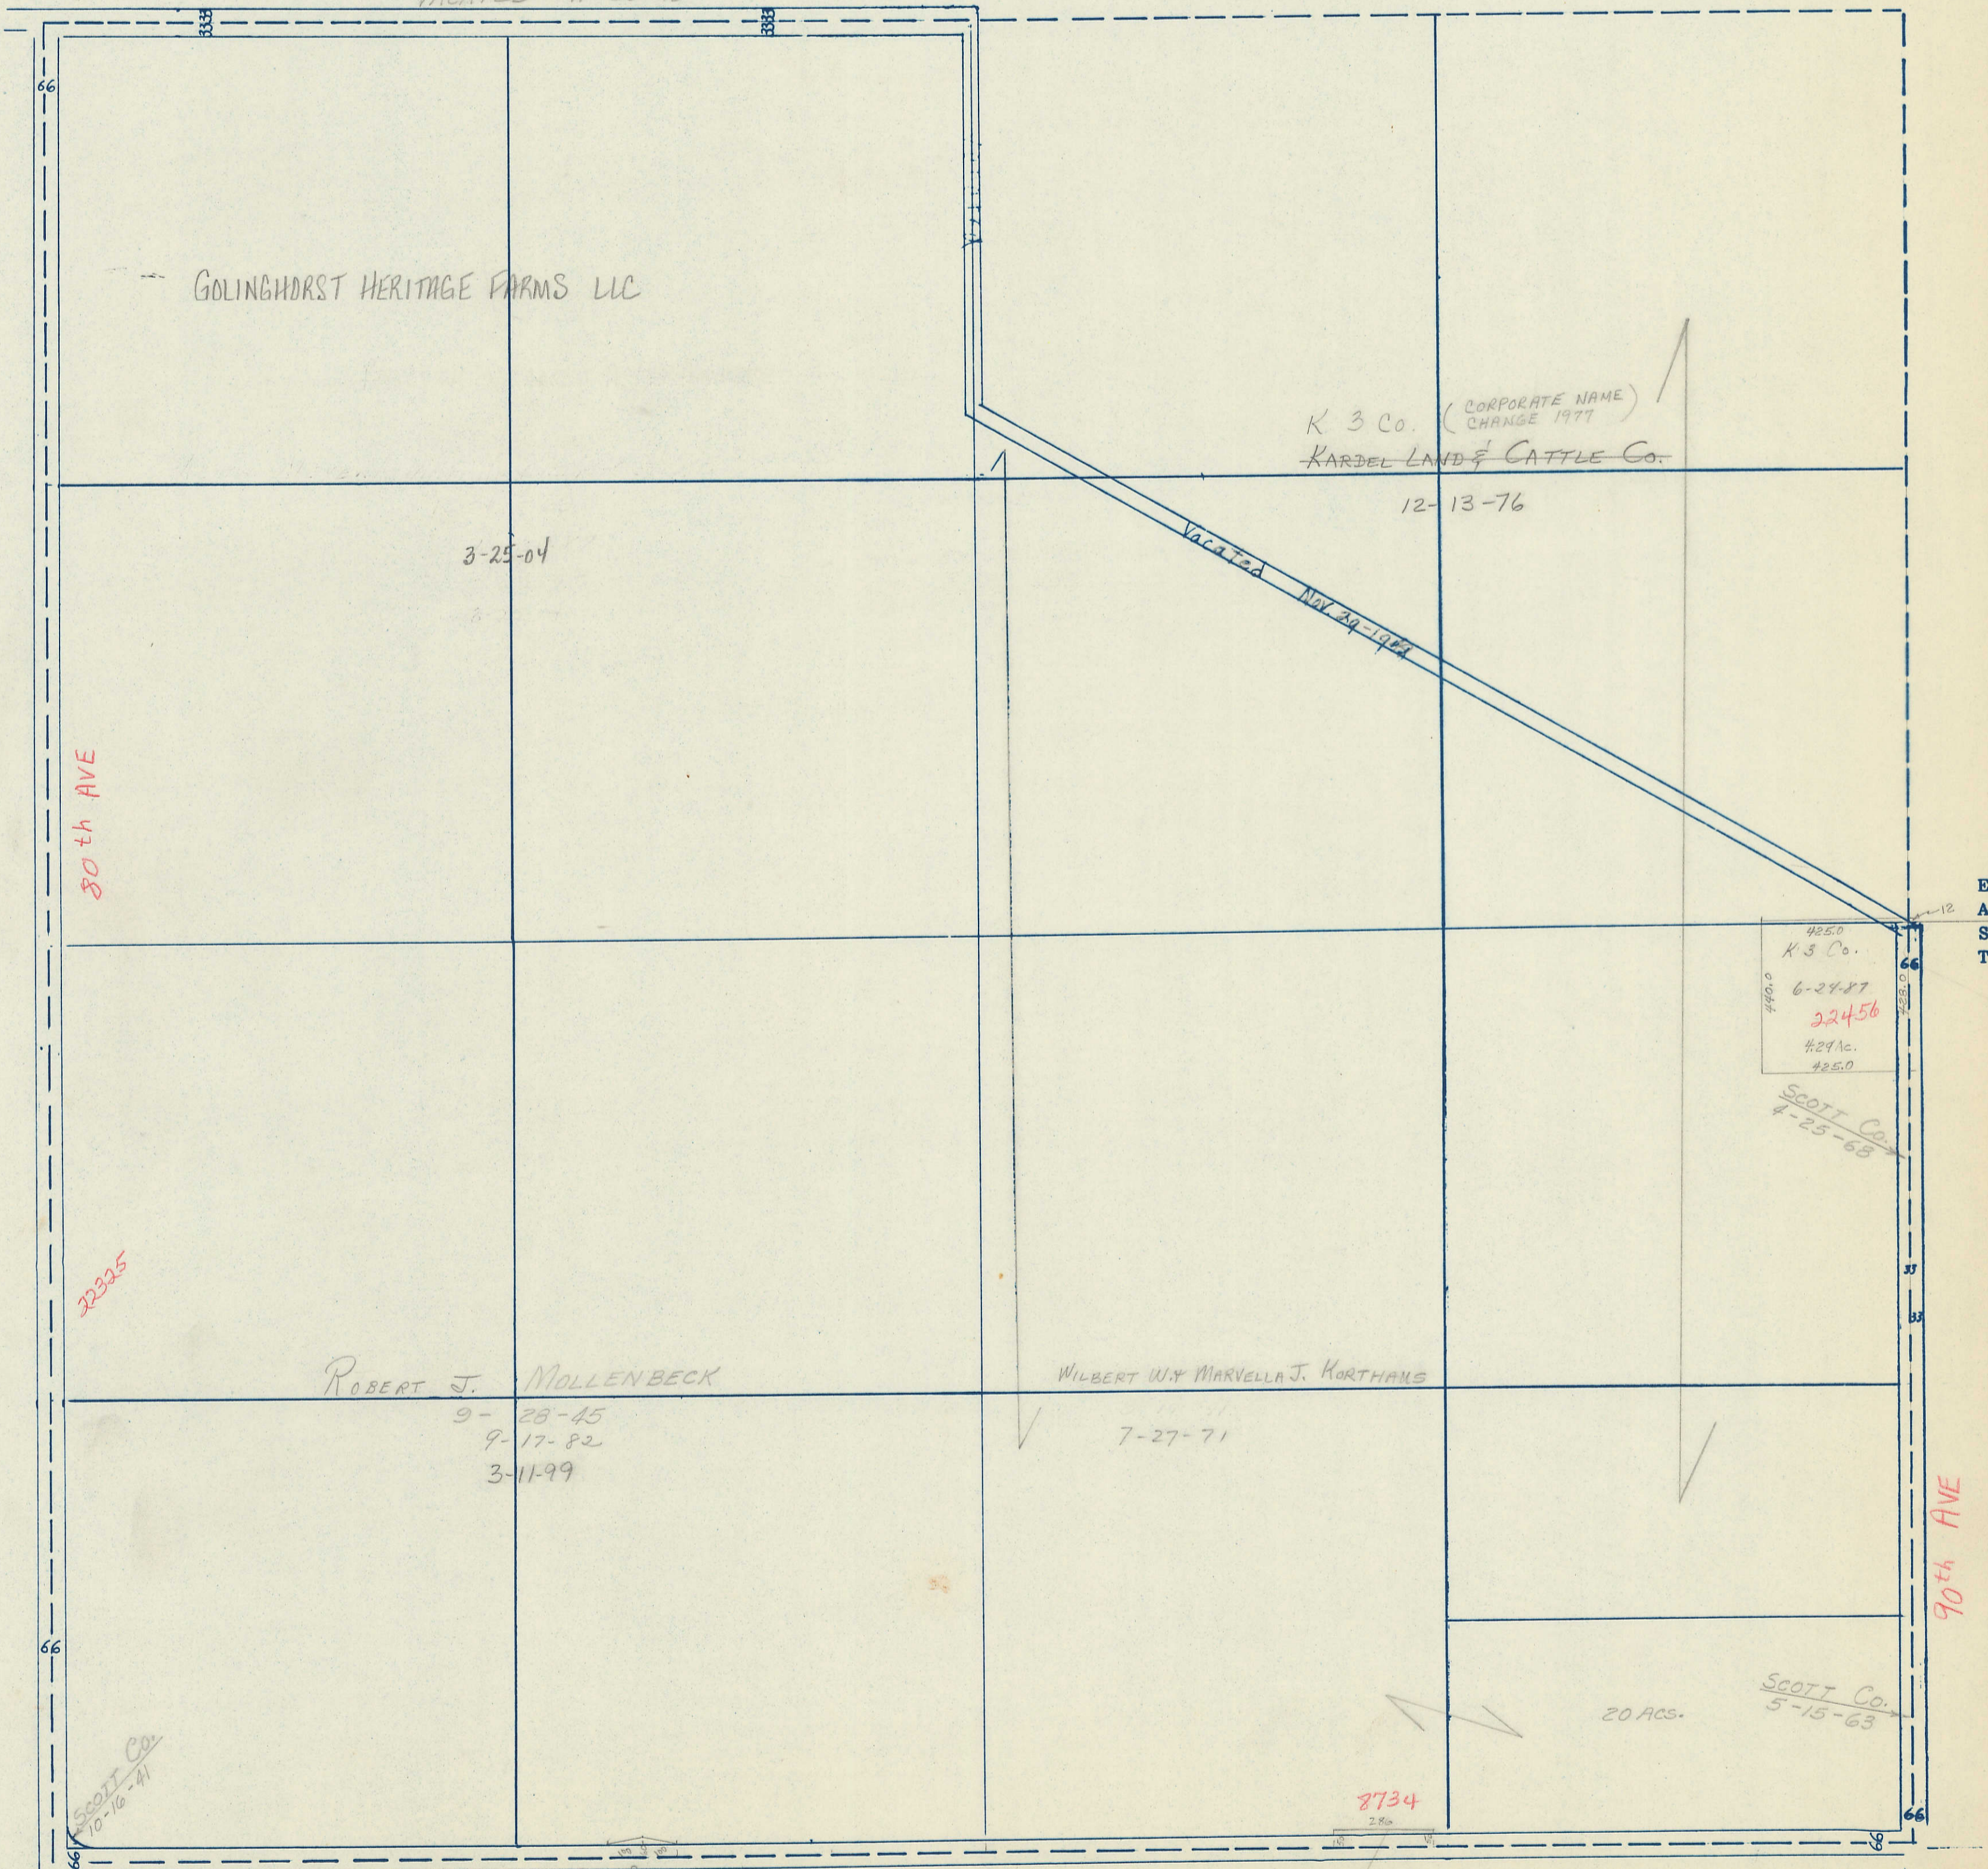

GOLINGHORST HERITAGE FARMS LLC

K 3 Co. (CORPORATE NAME CHANGE 1977)
KARDEL LAND & CATTLE CO.

12-13-76

3-25-04

VACATED NOV 29 1949

425.0
K 3 Co.
6-24-87
224.56
4.29 Ac.
425.0

SCOTT Co.
4-25-68

ROBERT J. MOLLENBECK

9-28-45
9-17-82
3-11-99

WILBERT W. MARVELLA J. KORTHANS

7-27-71

20 ACS.
SCOTT Co.
5-15-63

8734

80th AVE

22325

90th AVE

220th St 79.74CH

SOUTH

WEST

EAST