



SECTION
5

SCALE IN CHAINS

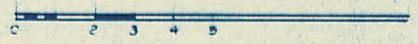

Township 79-North; Range 2
EAST OF THE FIFTH PRINCIPAL MERIDIAN

SCALE IN FEET

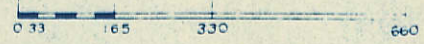

SCOTT COUNTY, IOWA
HICKORY GROVE TOWNSHIP


Transfer Page 226

NORTH

260th ST.

WEST

EAST

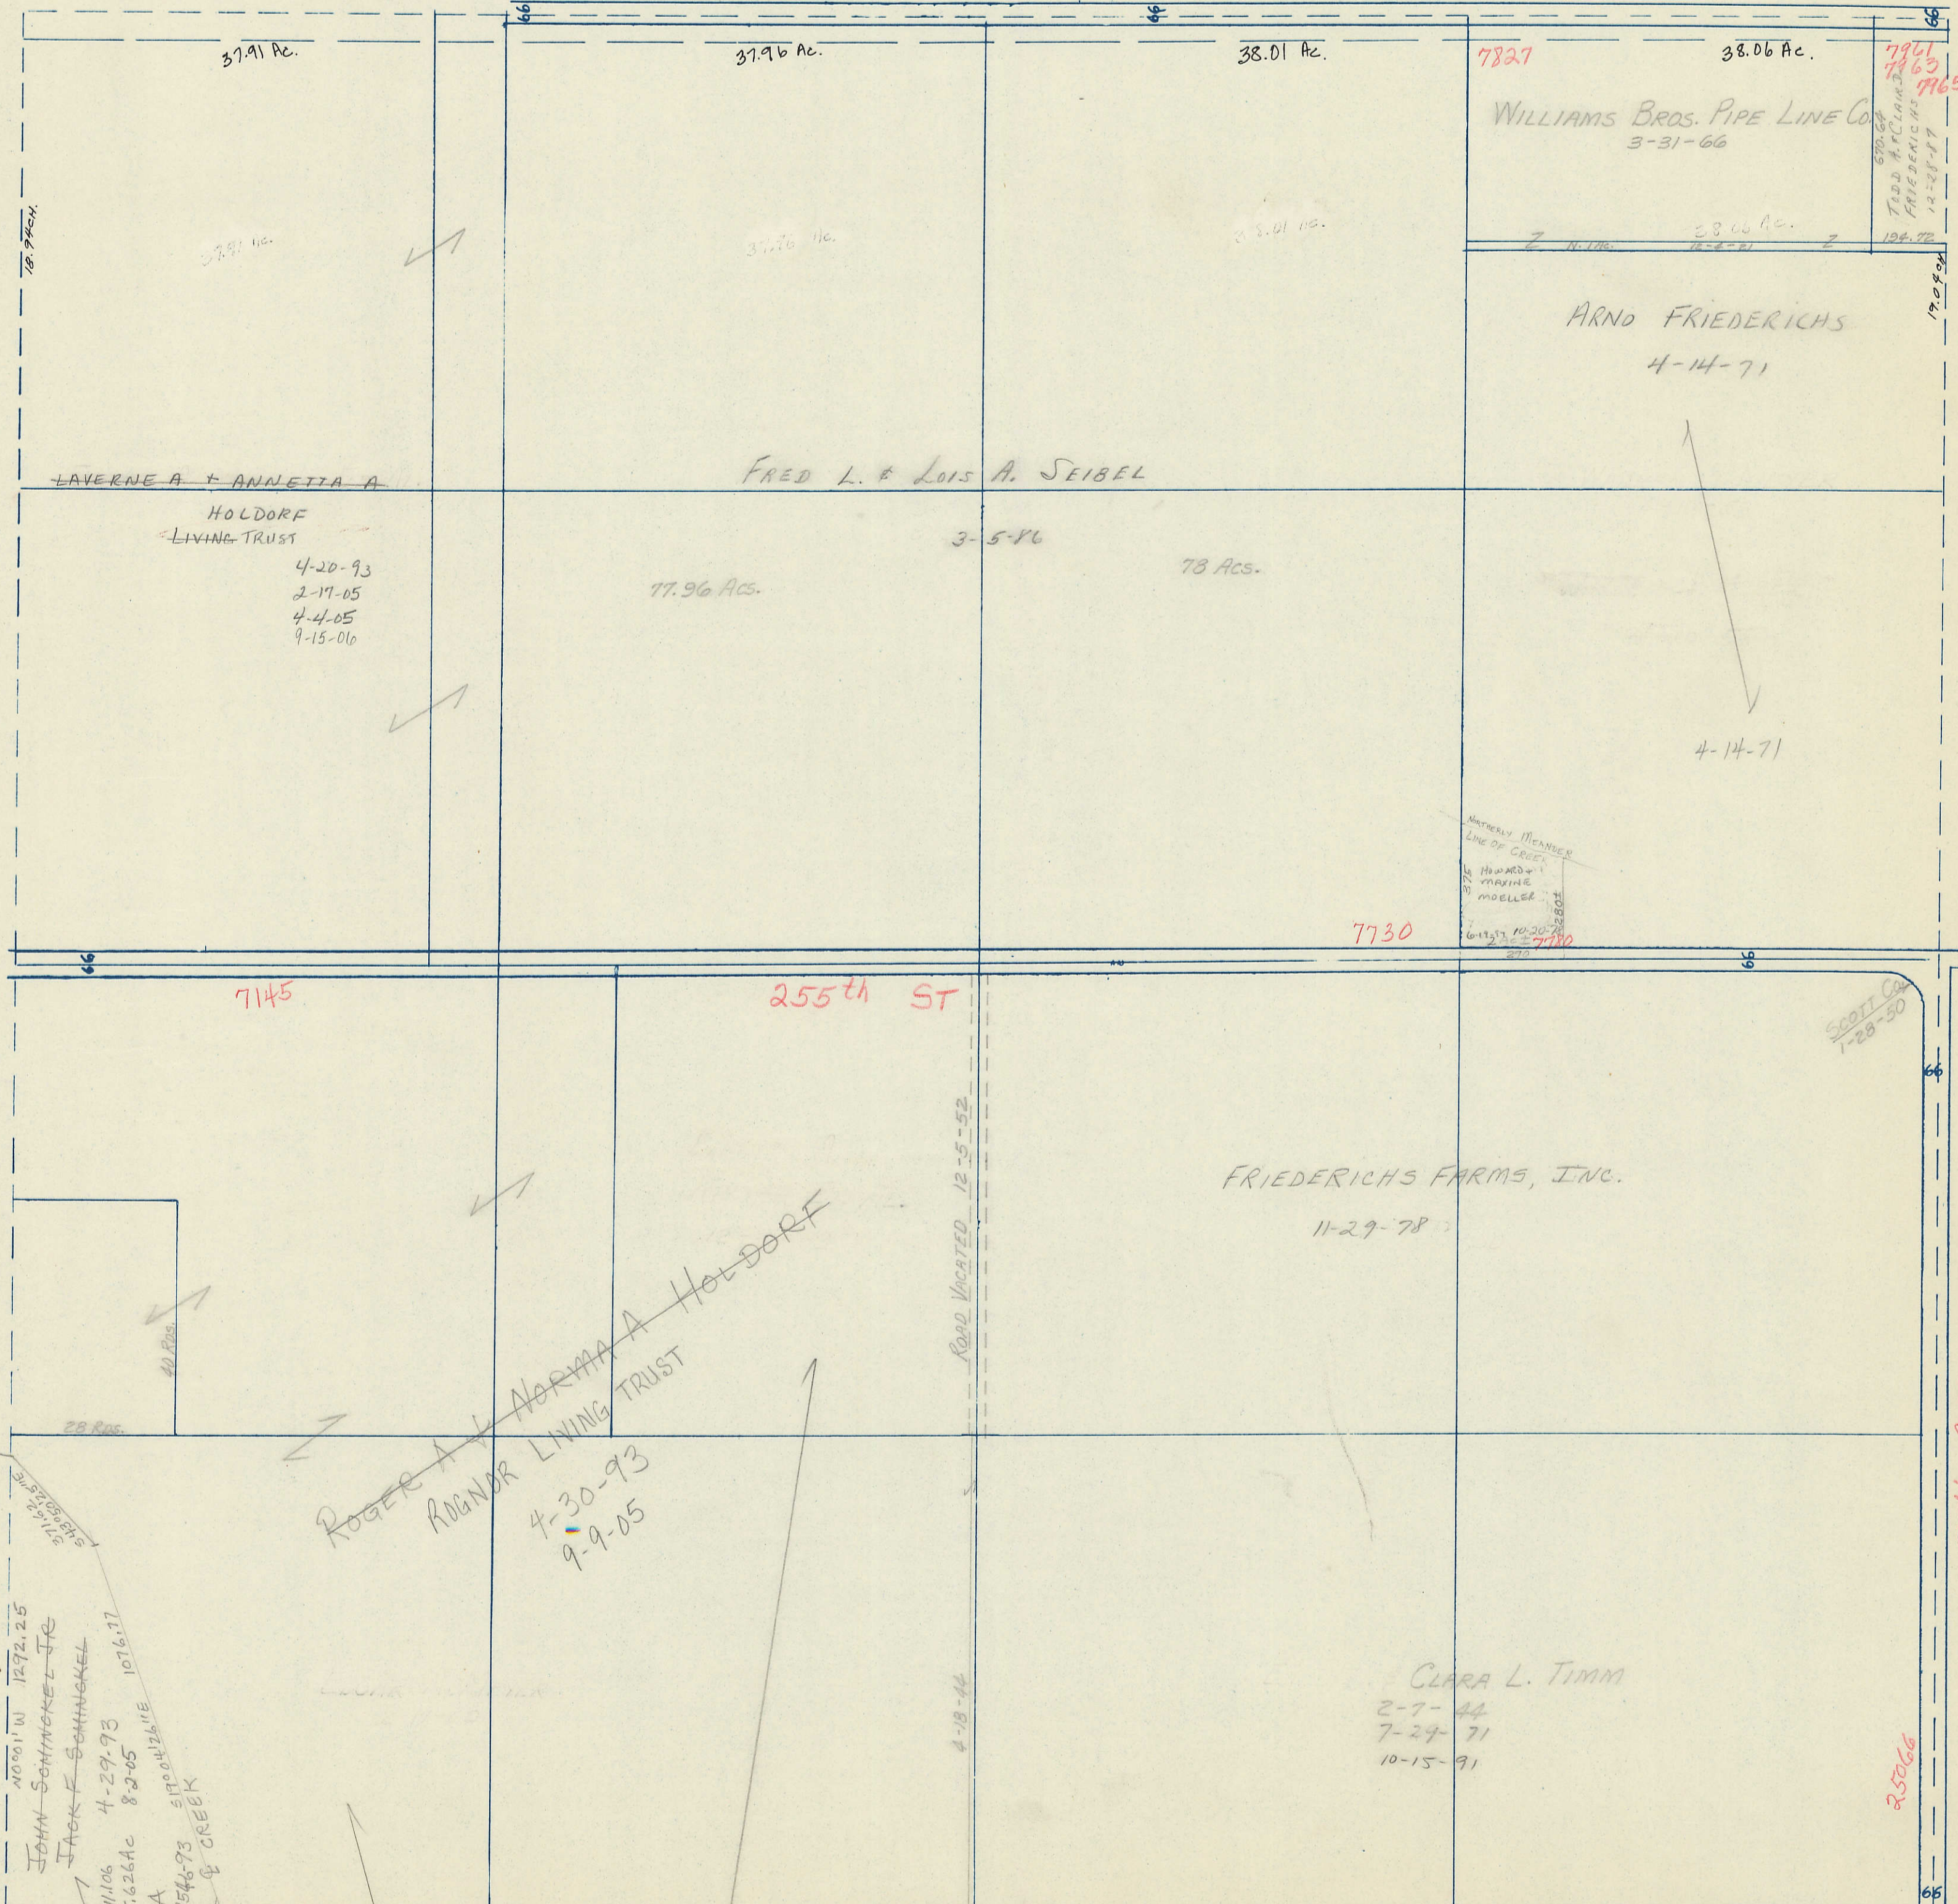

300.00
SCHWINGEL FARM
REMEMBER TRUST
100° 01' W 1292.25
JOHN SCHWINGEL JR
JACK F SCHWINGEL
4.52+11106 4-29-93
=15.626Ac 8-2-05 1076.77
PARCELS
SURVEY #7546-93
380.50
520.57
CREEK

ROGER A & NORMA A HOLDORF
ROGNOR LIVING TRUST
4-30-93
9-9-05

LAVERNE A & ANNETTA A
HOLDORF
LIVING TRUST
4-20-93
2-17-05
4-4-05
9-15-06

FRED L. & LOIS A. SEIBEL
3-5-96
78 Acs.

77.96 Acs.

7827
WILLIAMS BROS. PIPE LINE CO
3-31-66
28.06 Ac.
124.72

ARNO FRIEDERICHS
4-14-71

4-14-71

7730
MAXINE
MOELLE
10-20-78
7730

FRIEDERICHS FARMS, INC.
11-29-78

CLARA L. TIMM
2-7-44
7-29-71
10-15-91

80.19 CH

SOUTH

SCOTT CO
1-28-50

80th AVE

25066