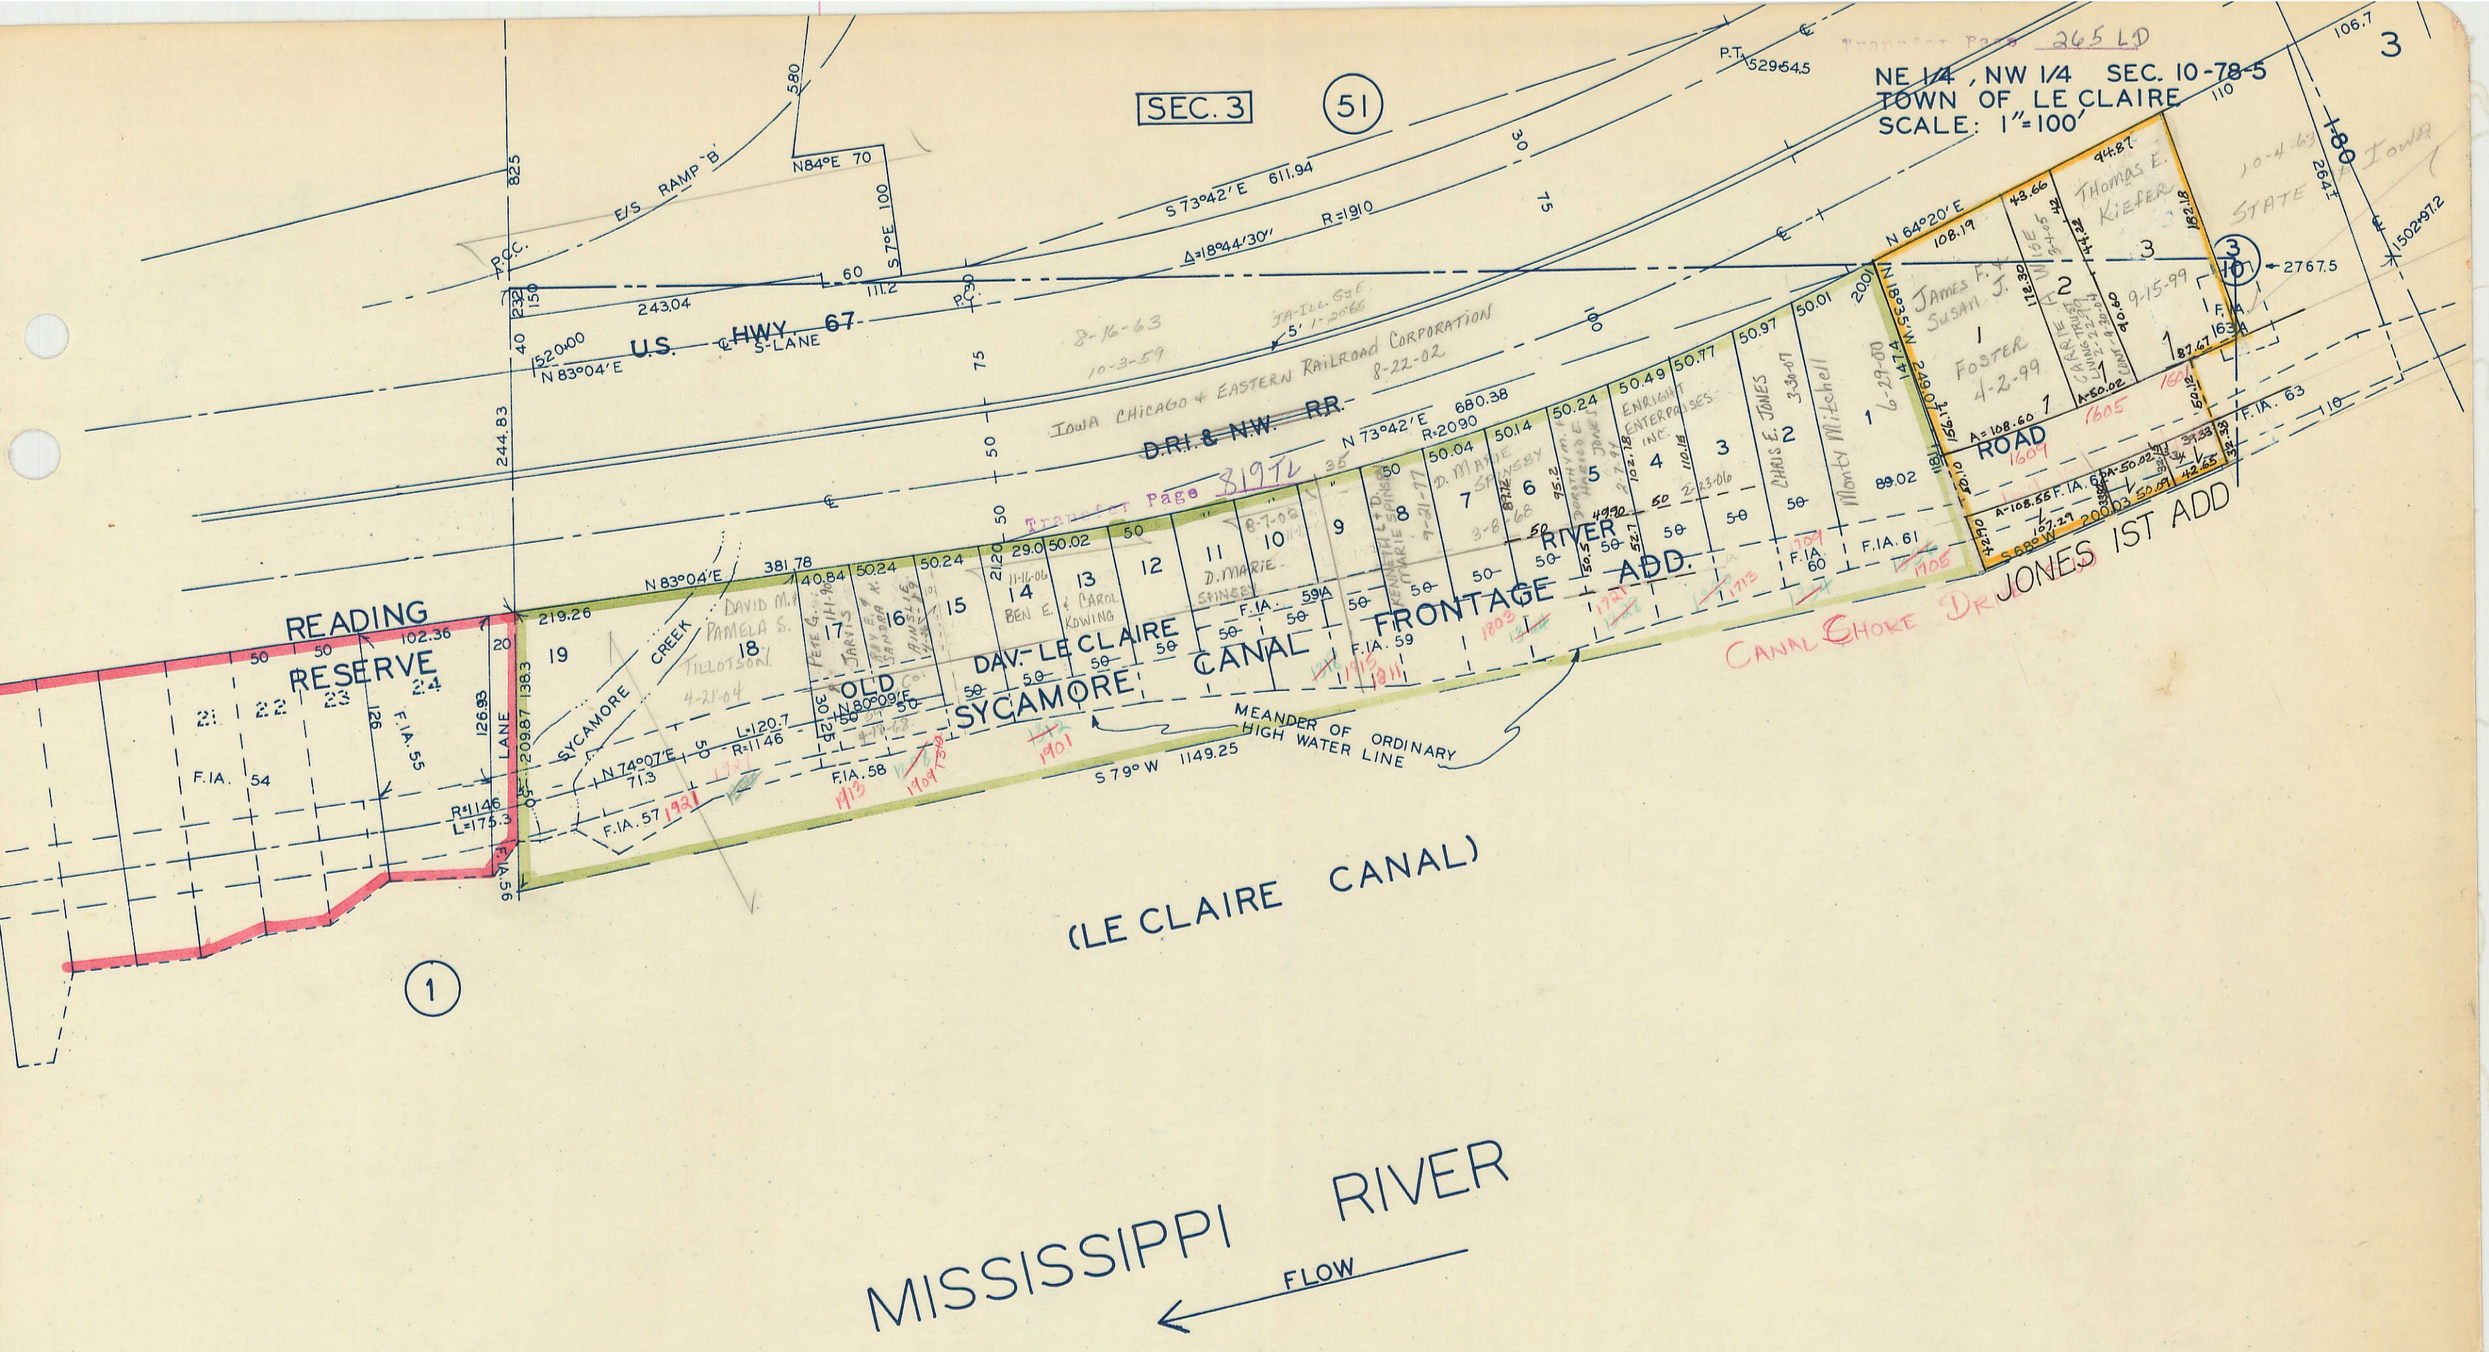

SEC. 3
51
NE 1/4, NW 1/4 SEC. 10-78-5
TOWN OF LE CLAIRE
SCALE: 1"=100'
3
U.S. HWY. 67
S-LANE
IOWA CHICAGO & EASTERN RAILROAD CORPORATION
D.R.I. & N.W. RR.
READING RESERVE
OLD DAV.-LE CLAIRE
SYCAMORE CANAL
FRONTAGE ADD.
RIVER
ROAD
JONES 1ST ADD
CANAL CHOKE DR
MEANDER OF ORDINARY HIGH WATER LINE
(LE CLAIRE CANAL)
1
MISSISSIPPI RIVER
FLOW