

NE 1/4, NW 1/4 SEC. 9-78-5
TOWN OF LE CLAIRE
SCALE: 1" = 100'

SEC. 4 (51)

A. SERGEANT'S RIVER VIEW ADD.

SERGEANT'S 3RD RIVER VIEW ADD.

2ND PLAT, A. SERGEANT'S RIVER VIEW

GOVT LOT 2

U.S. HWY. 67


U.S. HWY. 67

Iowa, Chicago & Eastern Railroad Corporation
D. R. & N. W. RR

(LE CLAIRE CANAL)

MISSISSIPPI RIVER
FLOW ←

SMITH'S ISLAND

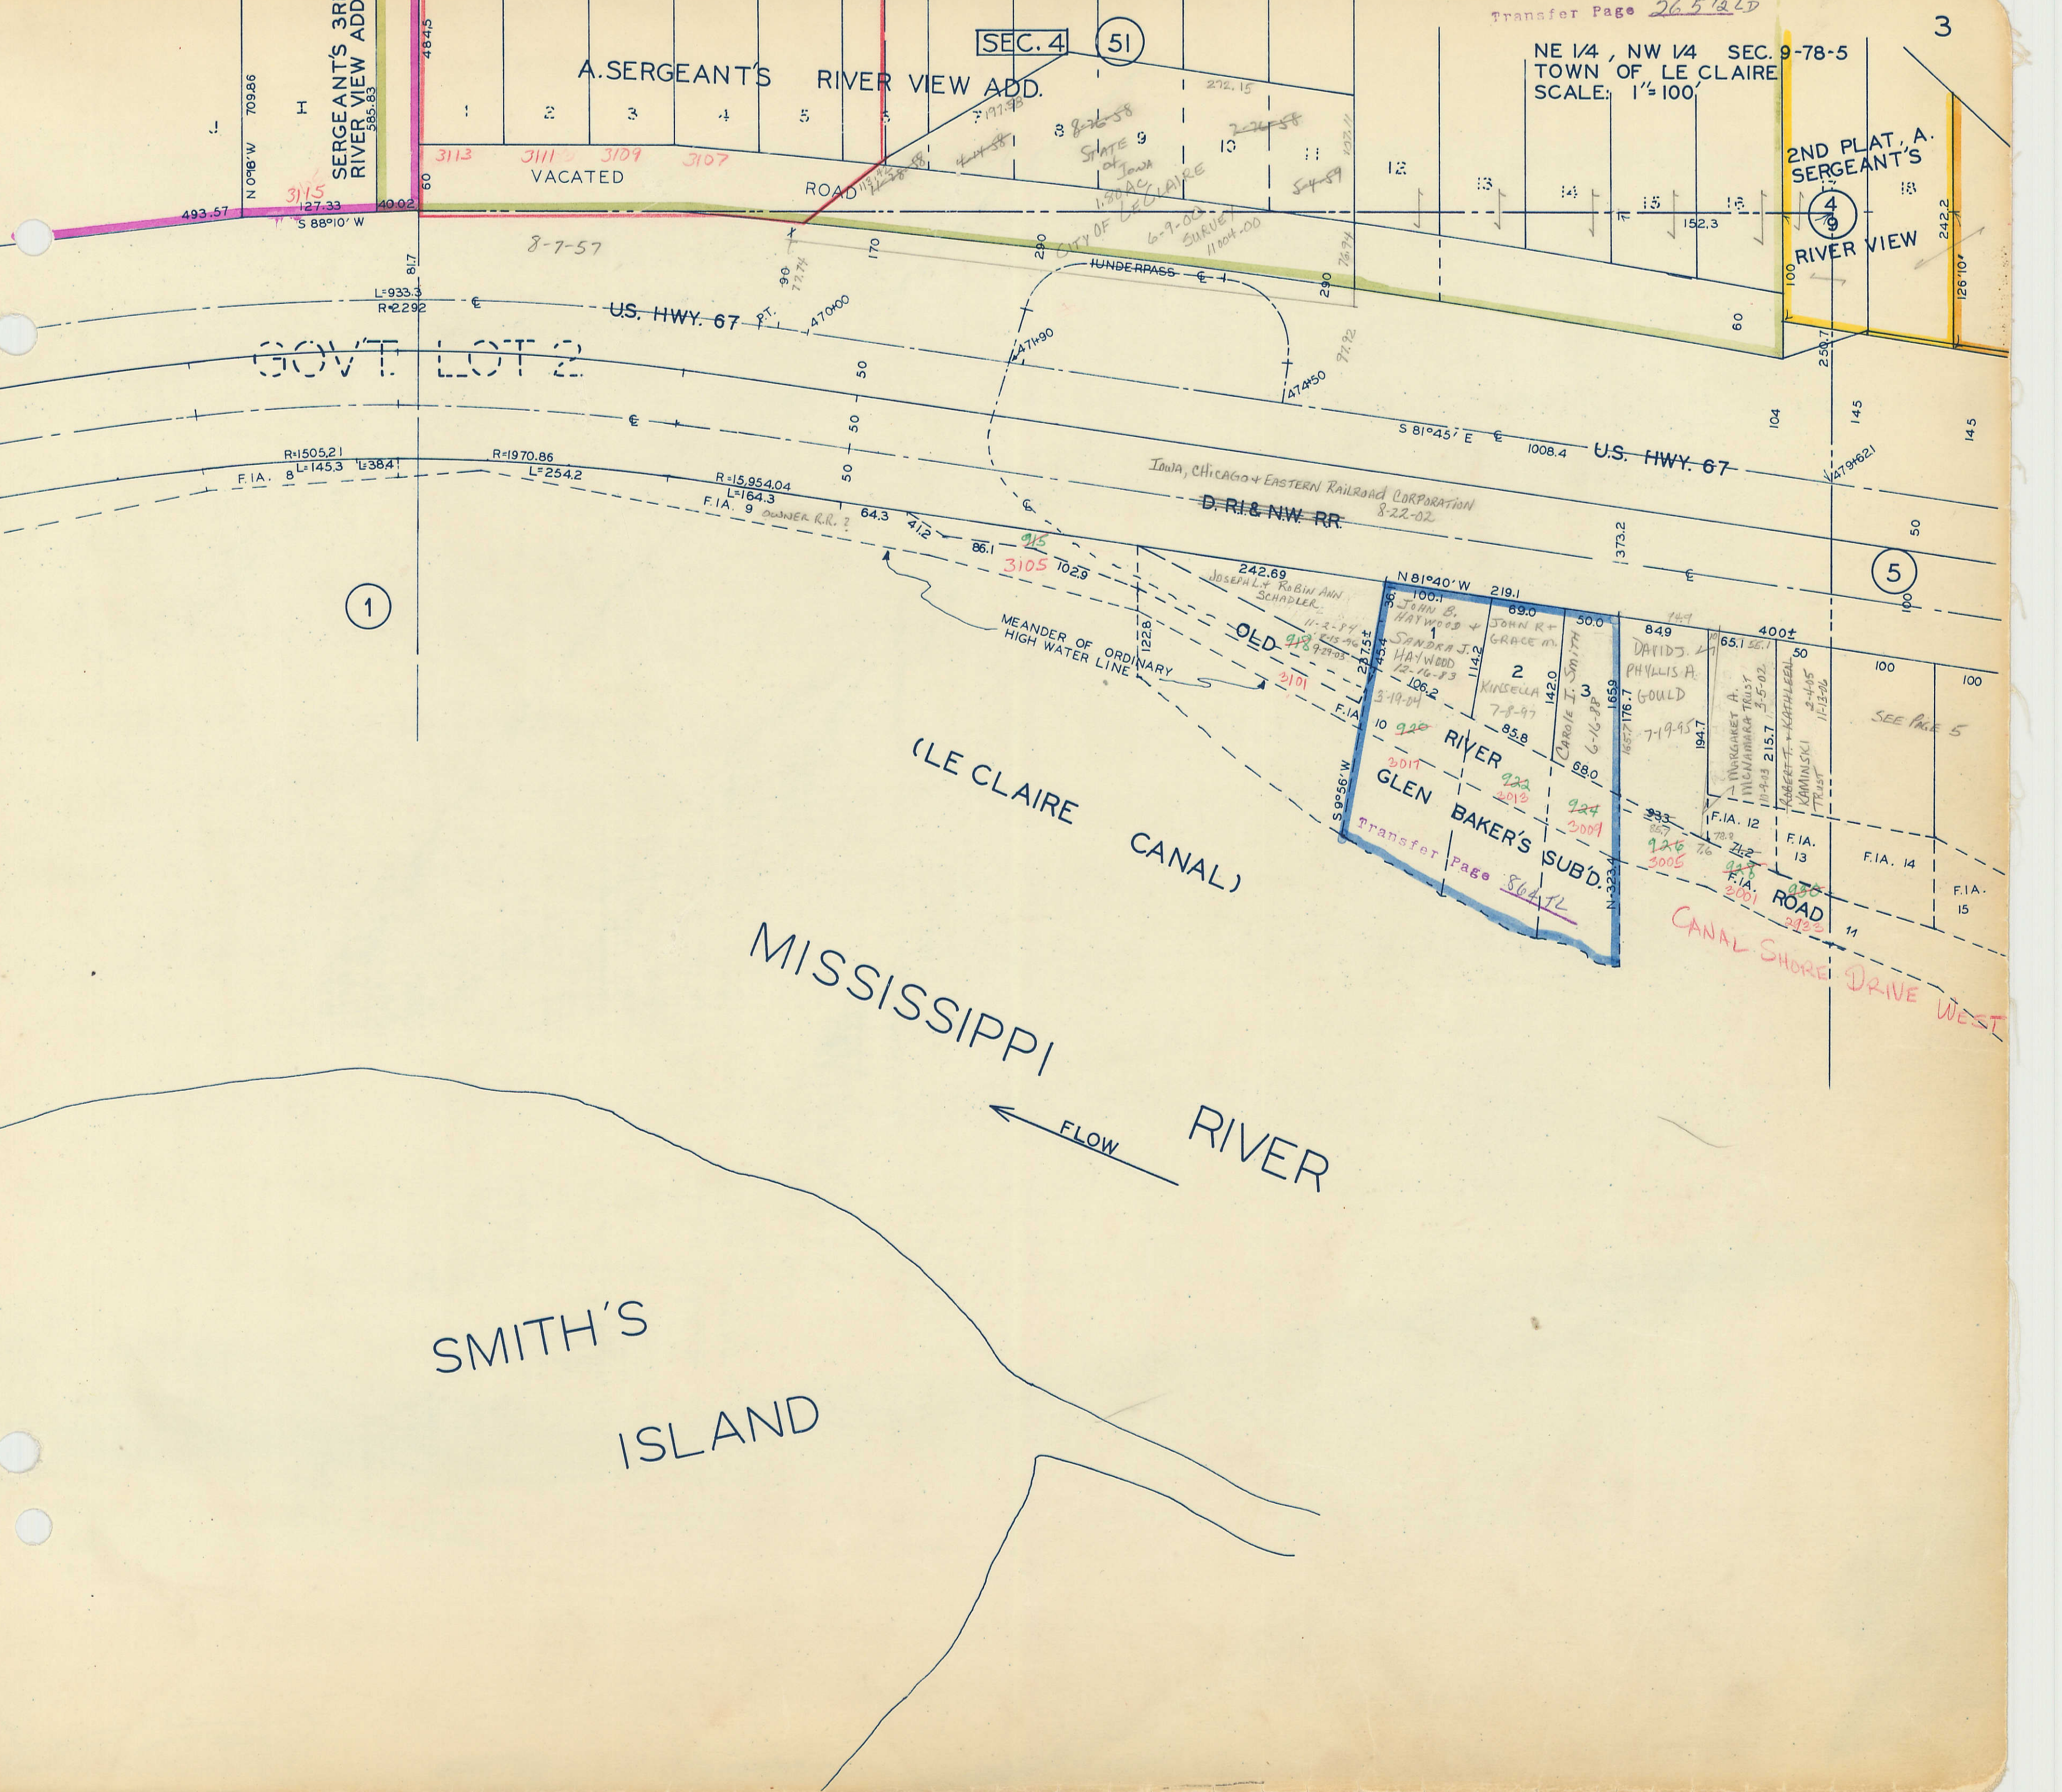

R=1505.21
F.I.A. 8 L=145.3 L=384.1

R=1970.86
L=254.2

R=15,954.04
L=164.3
F.I.A. 9 OWNER R.R.?

BAKER'S SUBD.
Transfer Page 86.4 TL

CANAL SHORE DRIVE WEST

SEE PAGE 5