

LIMITS

8-25-69

66 1504.07 2287 1140.17

66 Δ 623' R=1910 L=212.55

66 3334


R=1910 L=207.77 Δ 614'

CORPORATE

SEC. 34

33

LOUIS D. CLARK & SONS, INC
4-23-82

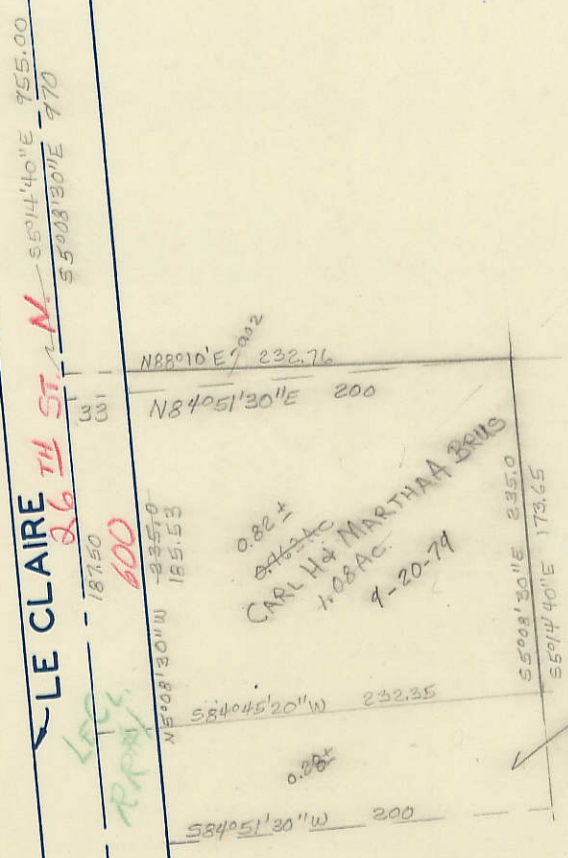

LE CLAIRE 1/4 ST

66

55

Sec 33-79-5