

NW 1/4, NW 1/4 SEC. 9-78-5
TOWN OF LE CLAIRE
SCALE: 1" = 100'

1

S. SERGEANT'S
HILL TOP ADD.

SERGEANT'S THIRD RIVERVIEW ADD.

SERGEANT'S
RIVERVIEW

SEC. 4

(49)

54
89


LIMITS

CORPORATE

U.S. HWY. 67

GOVT. LOT 2

(3)

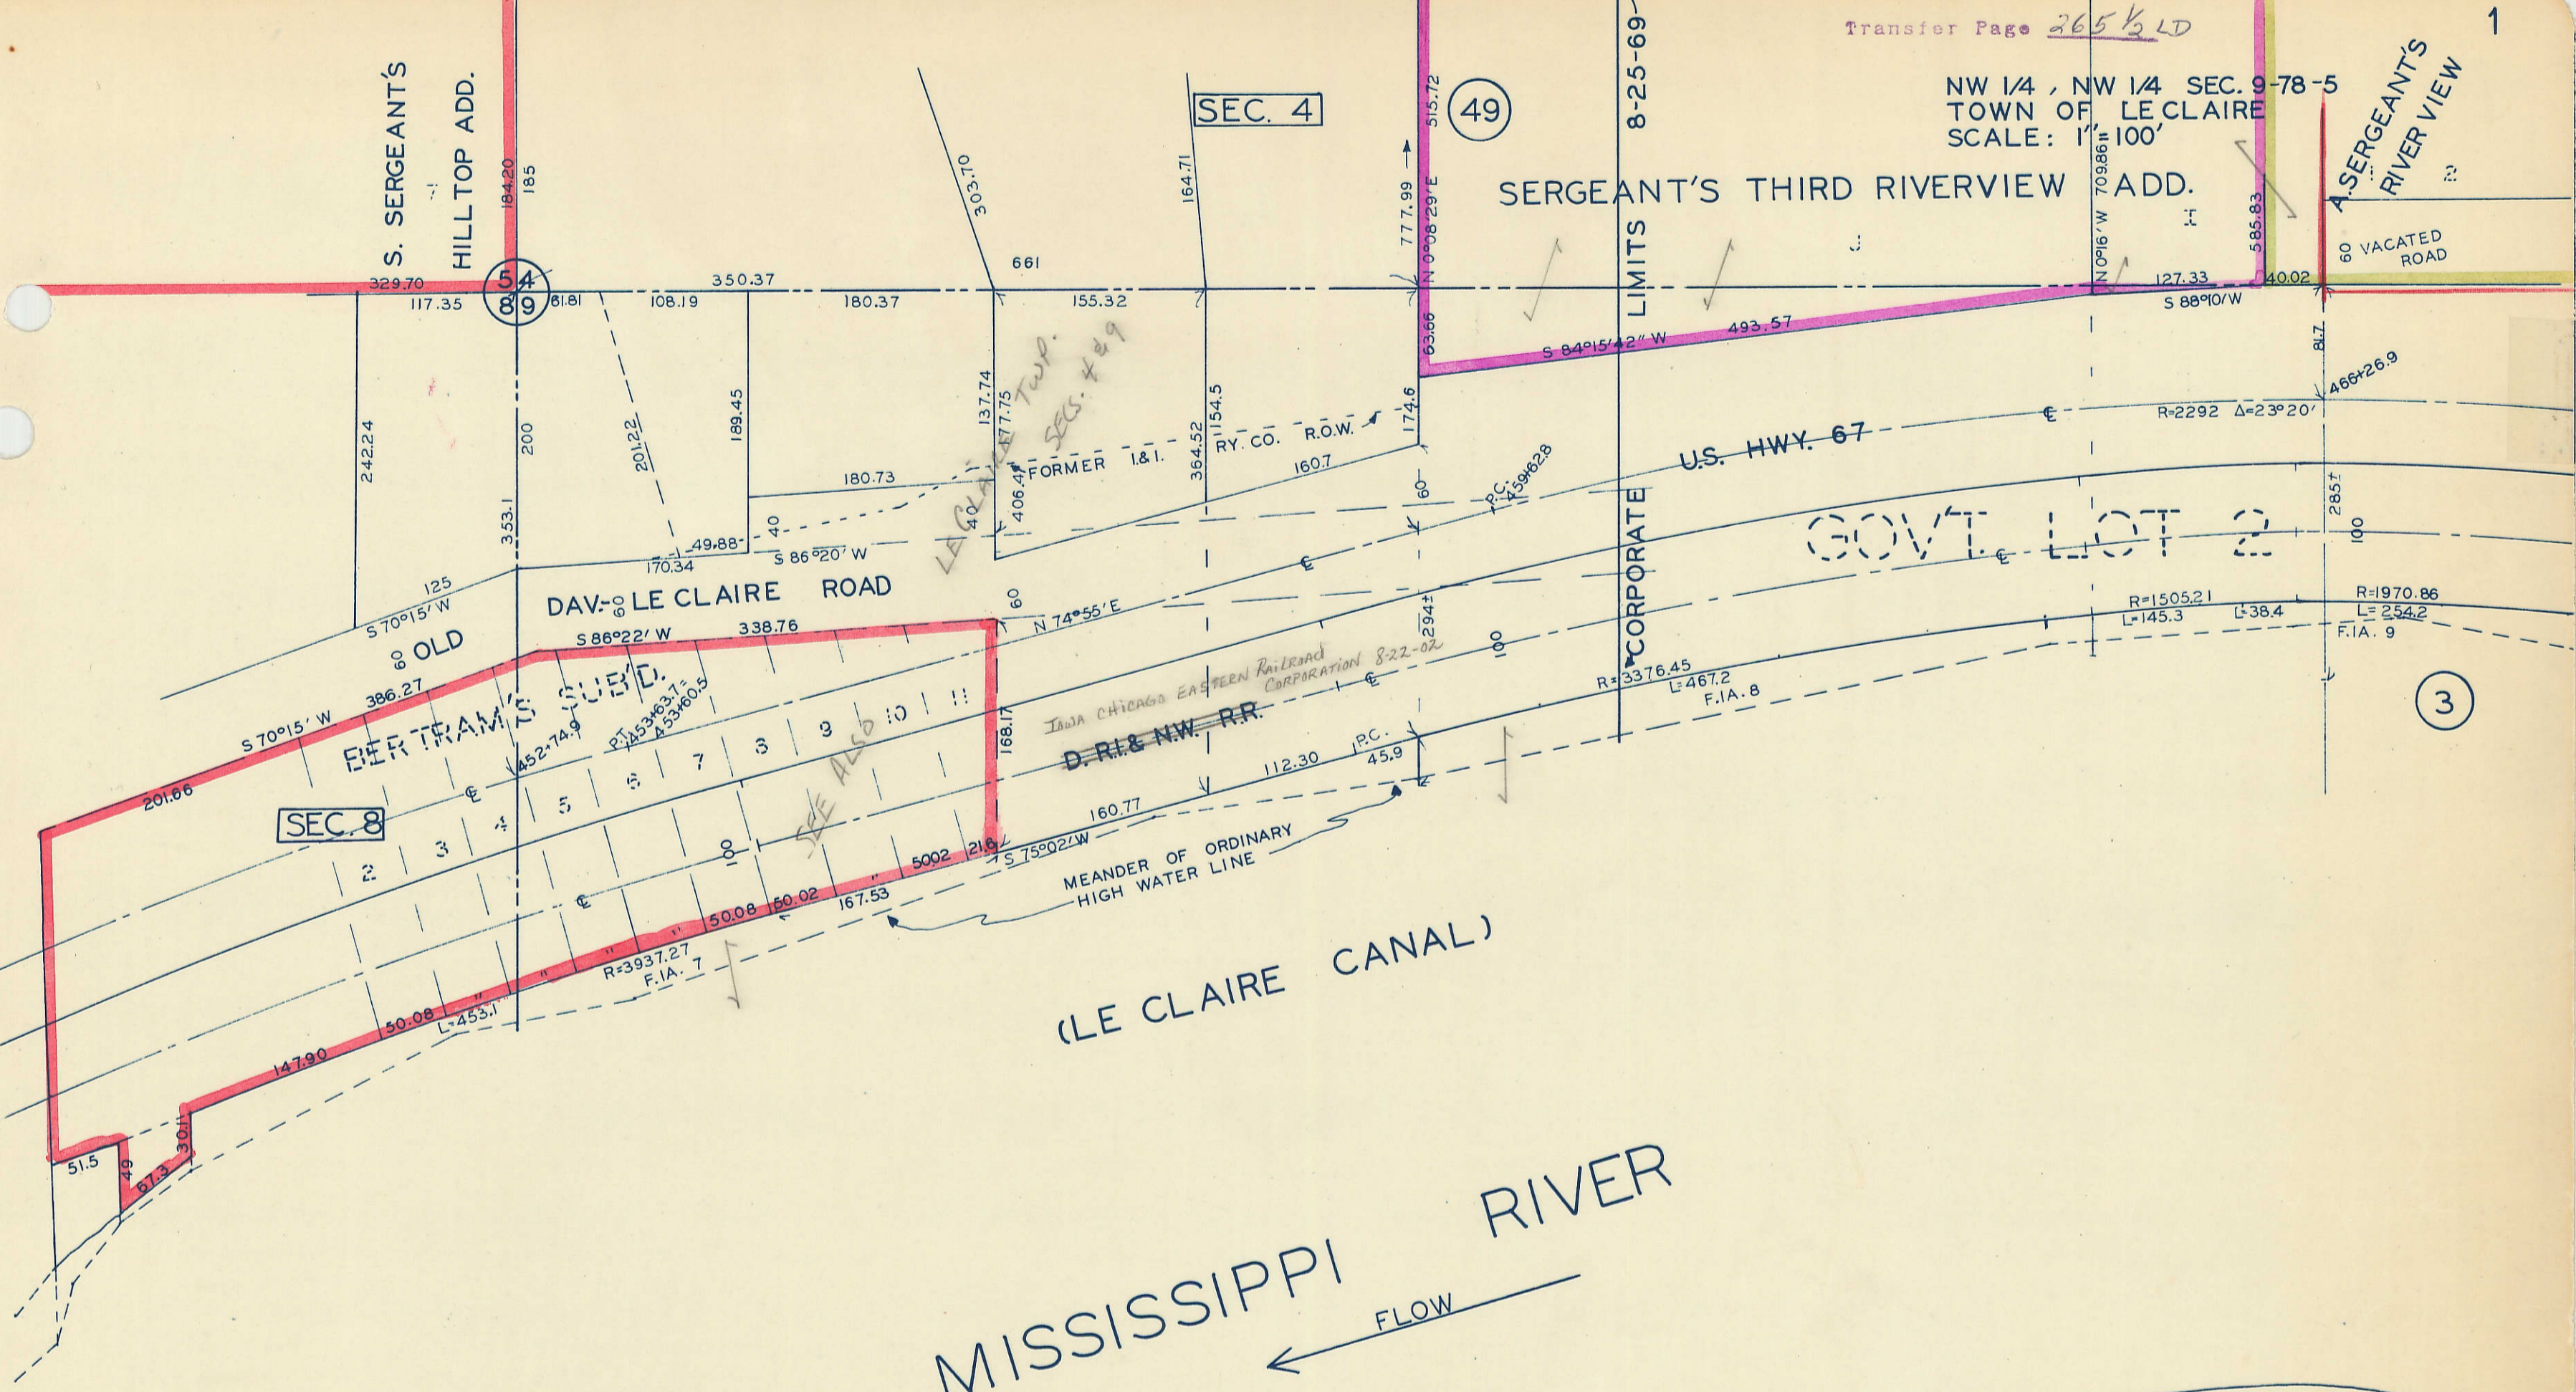

(LE CLAIRE CANAL)

MISSISSIPPI RIVER
← FLOW

SMITH'S ISLAND

10-6-36
8-14-40