


SW 1/4, NE 1/4 SEC. 2-78-5  
TOWN OF LE CLAIRE  
SCALE: 1" = 100'

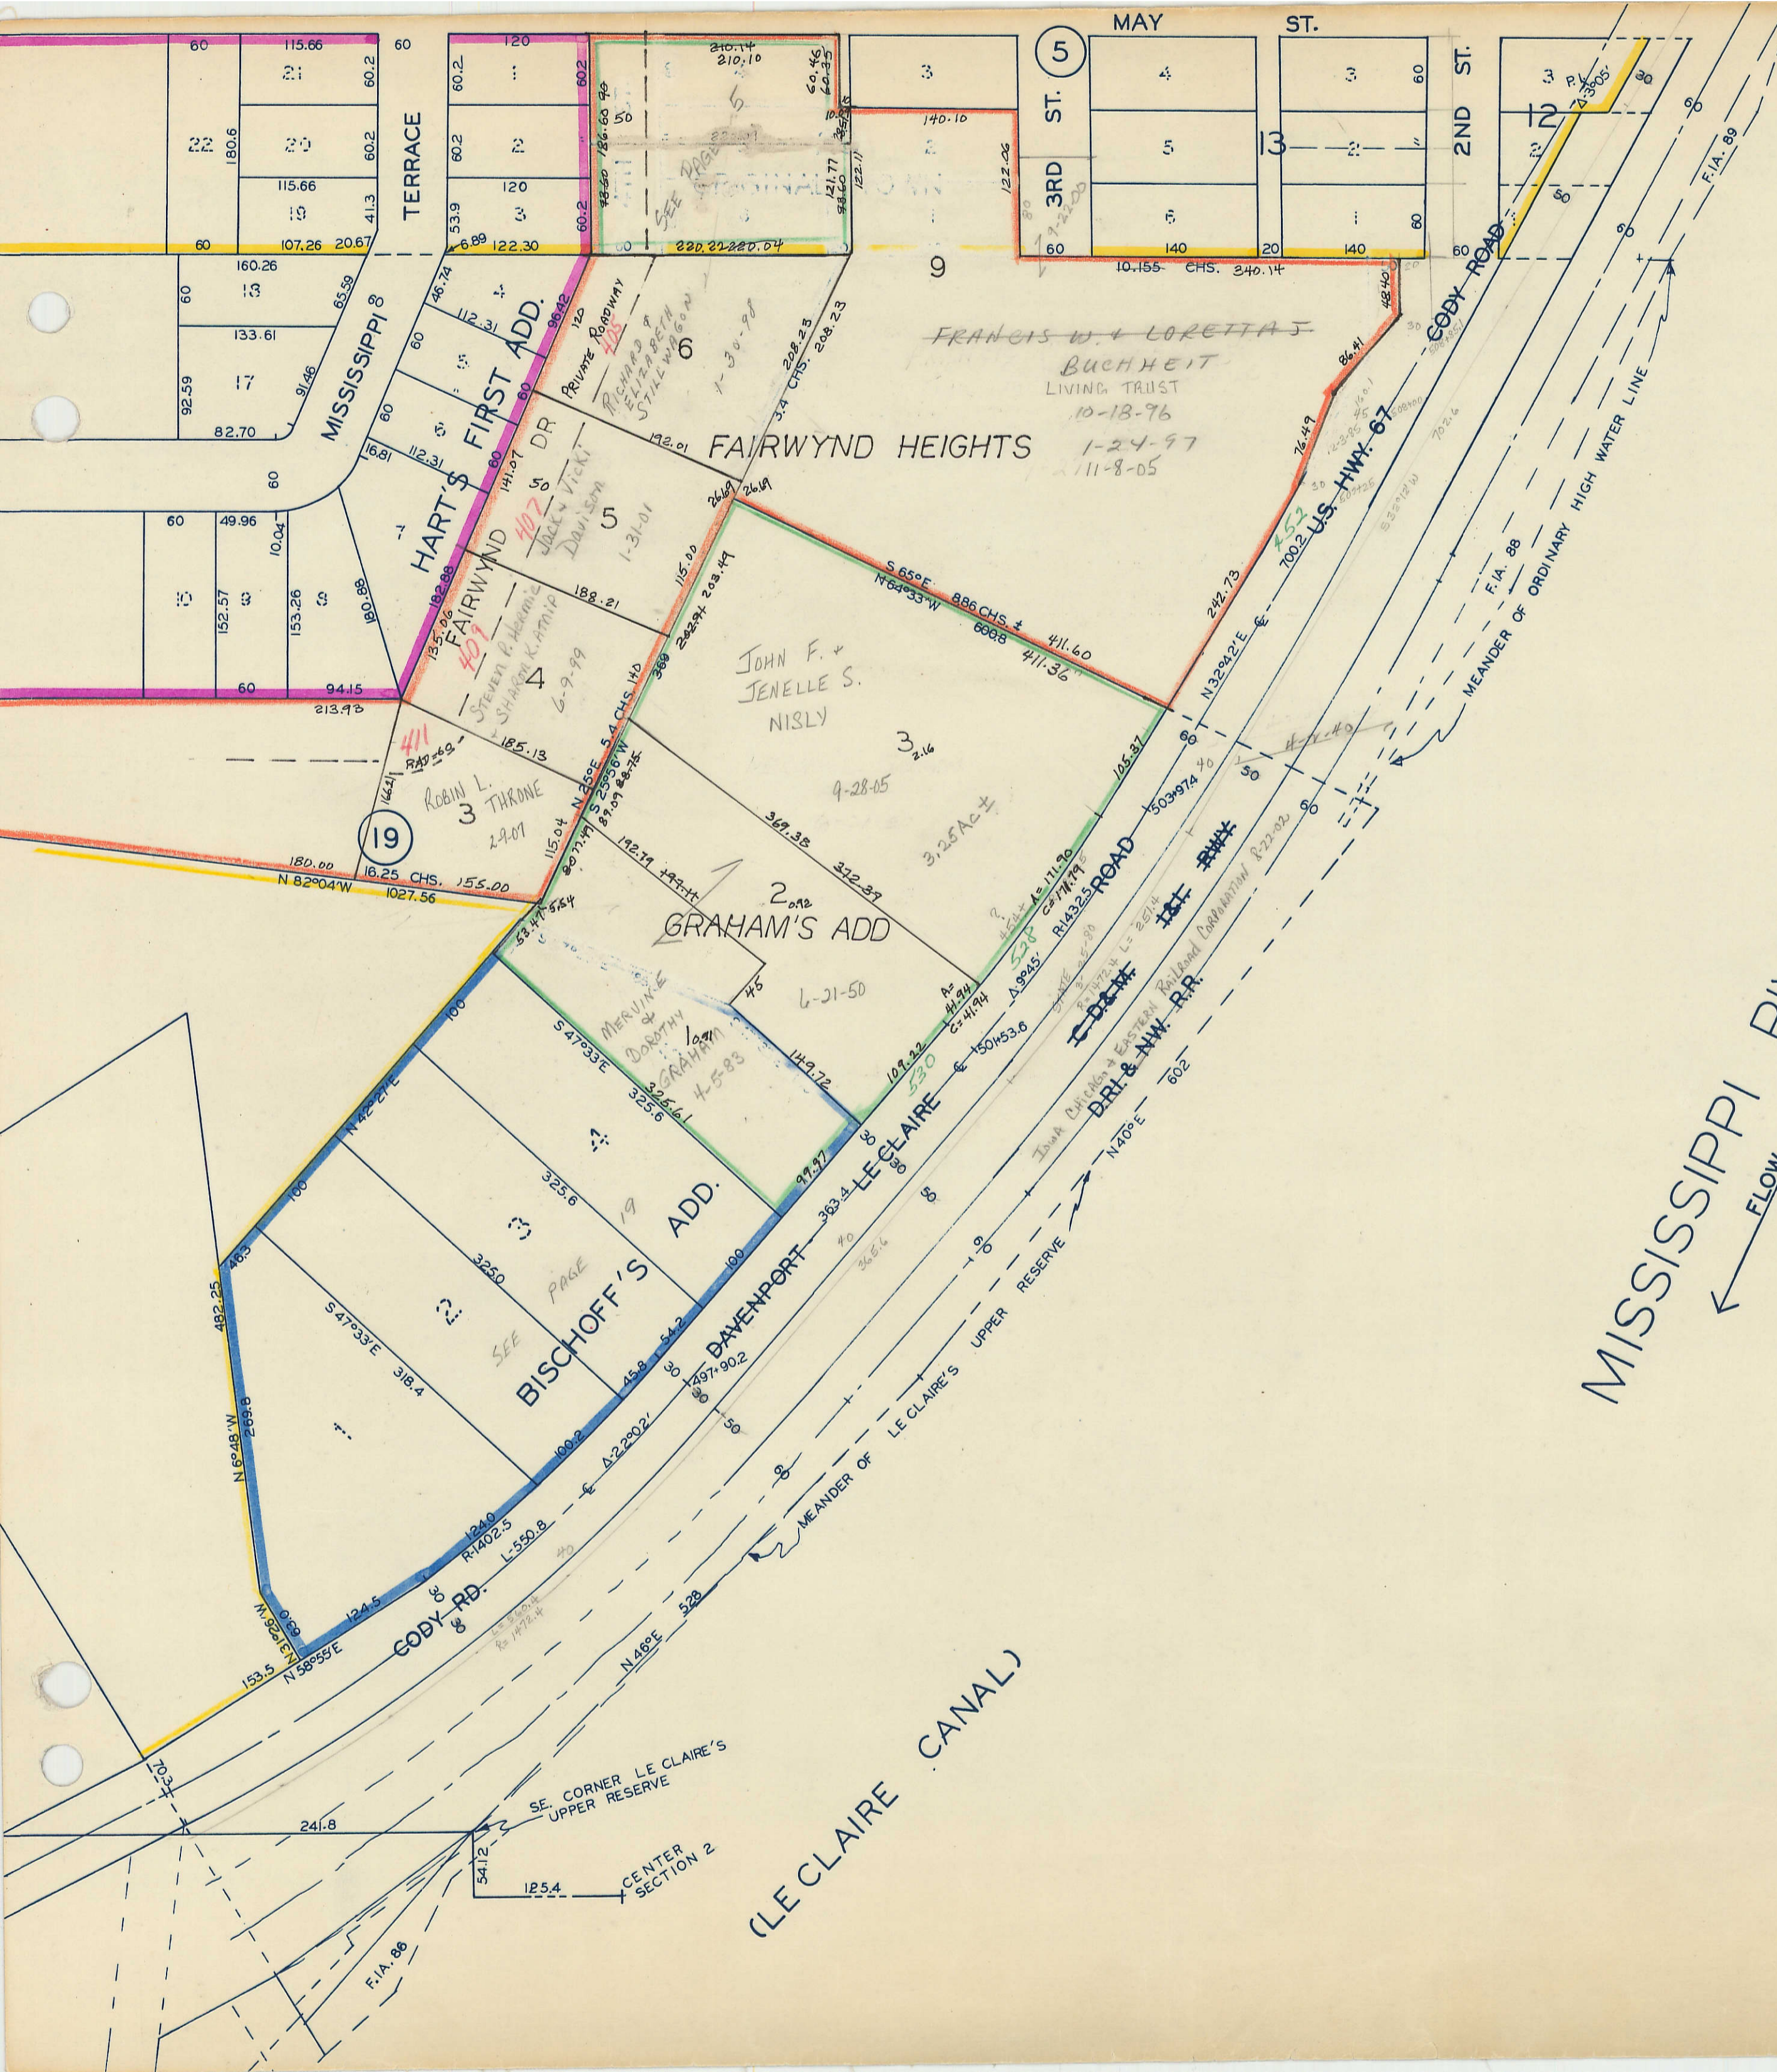

MISSISSIPPI RIVER  
← FLOW

(LE CLAIRE CANAL)