

SW 1/4, NE 1/4 SEC. 3-78-5
TOWN OF LE CLAIRE
SCALE: 1" = 100'

5

GOVT. LOT 3

64.05 AC.


14.88 AC.

18.9581
N 0° 08' 26" W

144.38
S 0° 08' 12" E

SEE PAGE 5

SEE PAGE 5

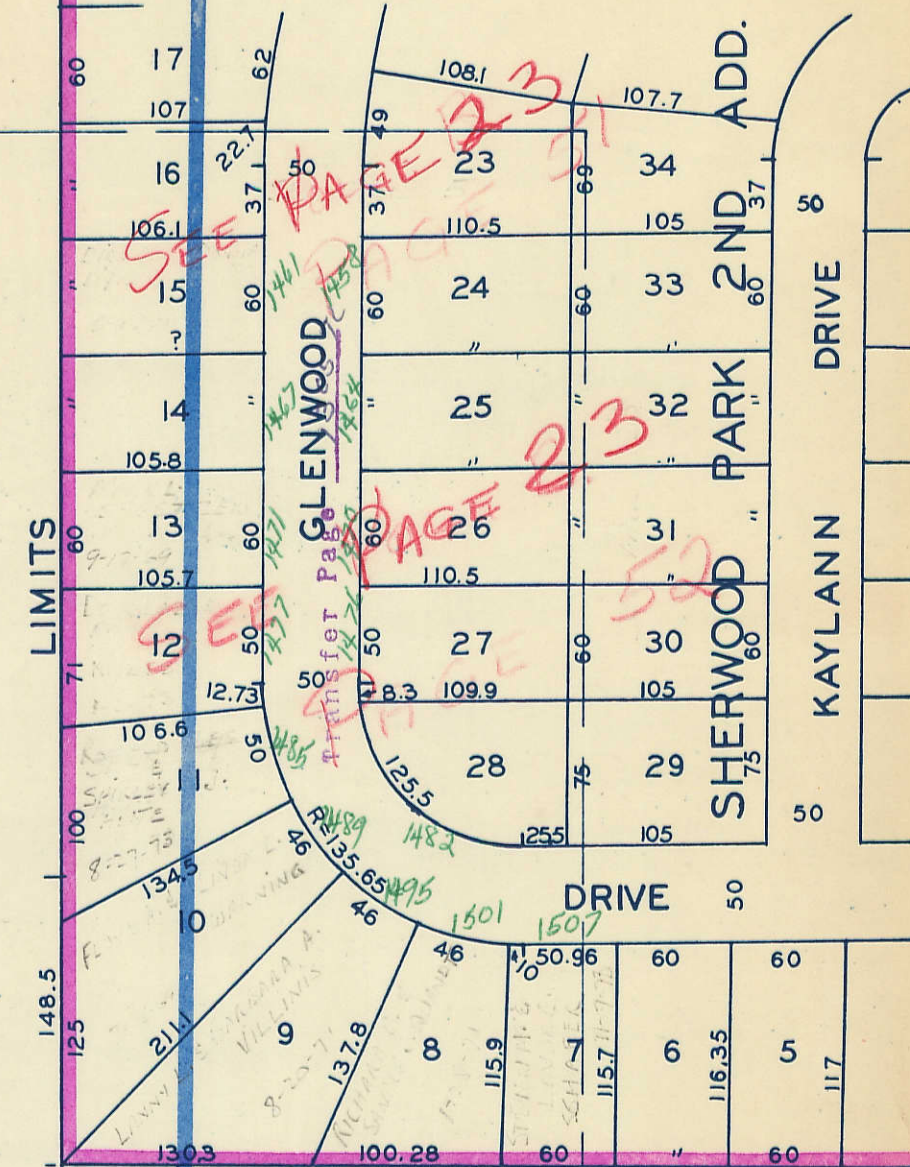

19

NEW LIFE COMMUNITY CHURCH OF LE CLAIRE
3
5.92
3-30-04

LE CLAIRE CEMETERY ASSOCIATION
7-17-74

NEW LIFE 2ND ADD
2
1.34
NEWBURY DEVELOPMENT CO.
11-24-04

PARK RUN ASSOCIATES OF LE CLAIRE LP
2.22
11-24-04

HUCKELBERRY LANE
CITY OF LE CLAIRE
LE CLAIRE, IOWA

ORIGINAL 30° 07' 30" E
W-LINE LE CLAIRE'S RESERVE
ST. 8-4-91
15TH

LE CLAIRE'S OUTLOTS
44
45
Transfer Page 477 LP

23

W-600.16
S 54° 06' 38" E 577.15
E-730.73
W-550.76

754.83
5 RODS

454.78
50° 08' 12" E

300.04
300.00

30.09
52.44
149.10
315.60

181.53
111.50
188.50

11-24-04

335.60

N 89° 45' 38" W

252.70

35.3

228.7

S 20° 57' E

269.90

1701
CITY OF LE CLAIRE
7-2-83

W-1057.71
S 22° 06' E

37

IOWA DR
318.40
1094.5

82 LKS.

60
506.22

S-LINE LE CLAIRE'S CORP.
4.07 CHS.

54.12

598 RESERVE

1320 LIMITS