


SW 1/4, NW 1/4 SEC. 3-78-5
TOWN OF LECLAIRE
SCALE: 1" = 100'

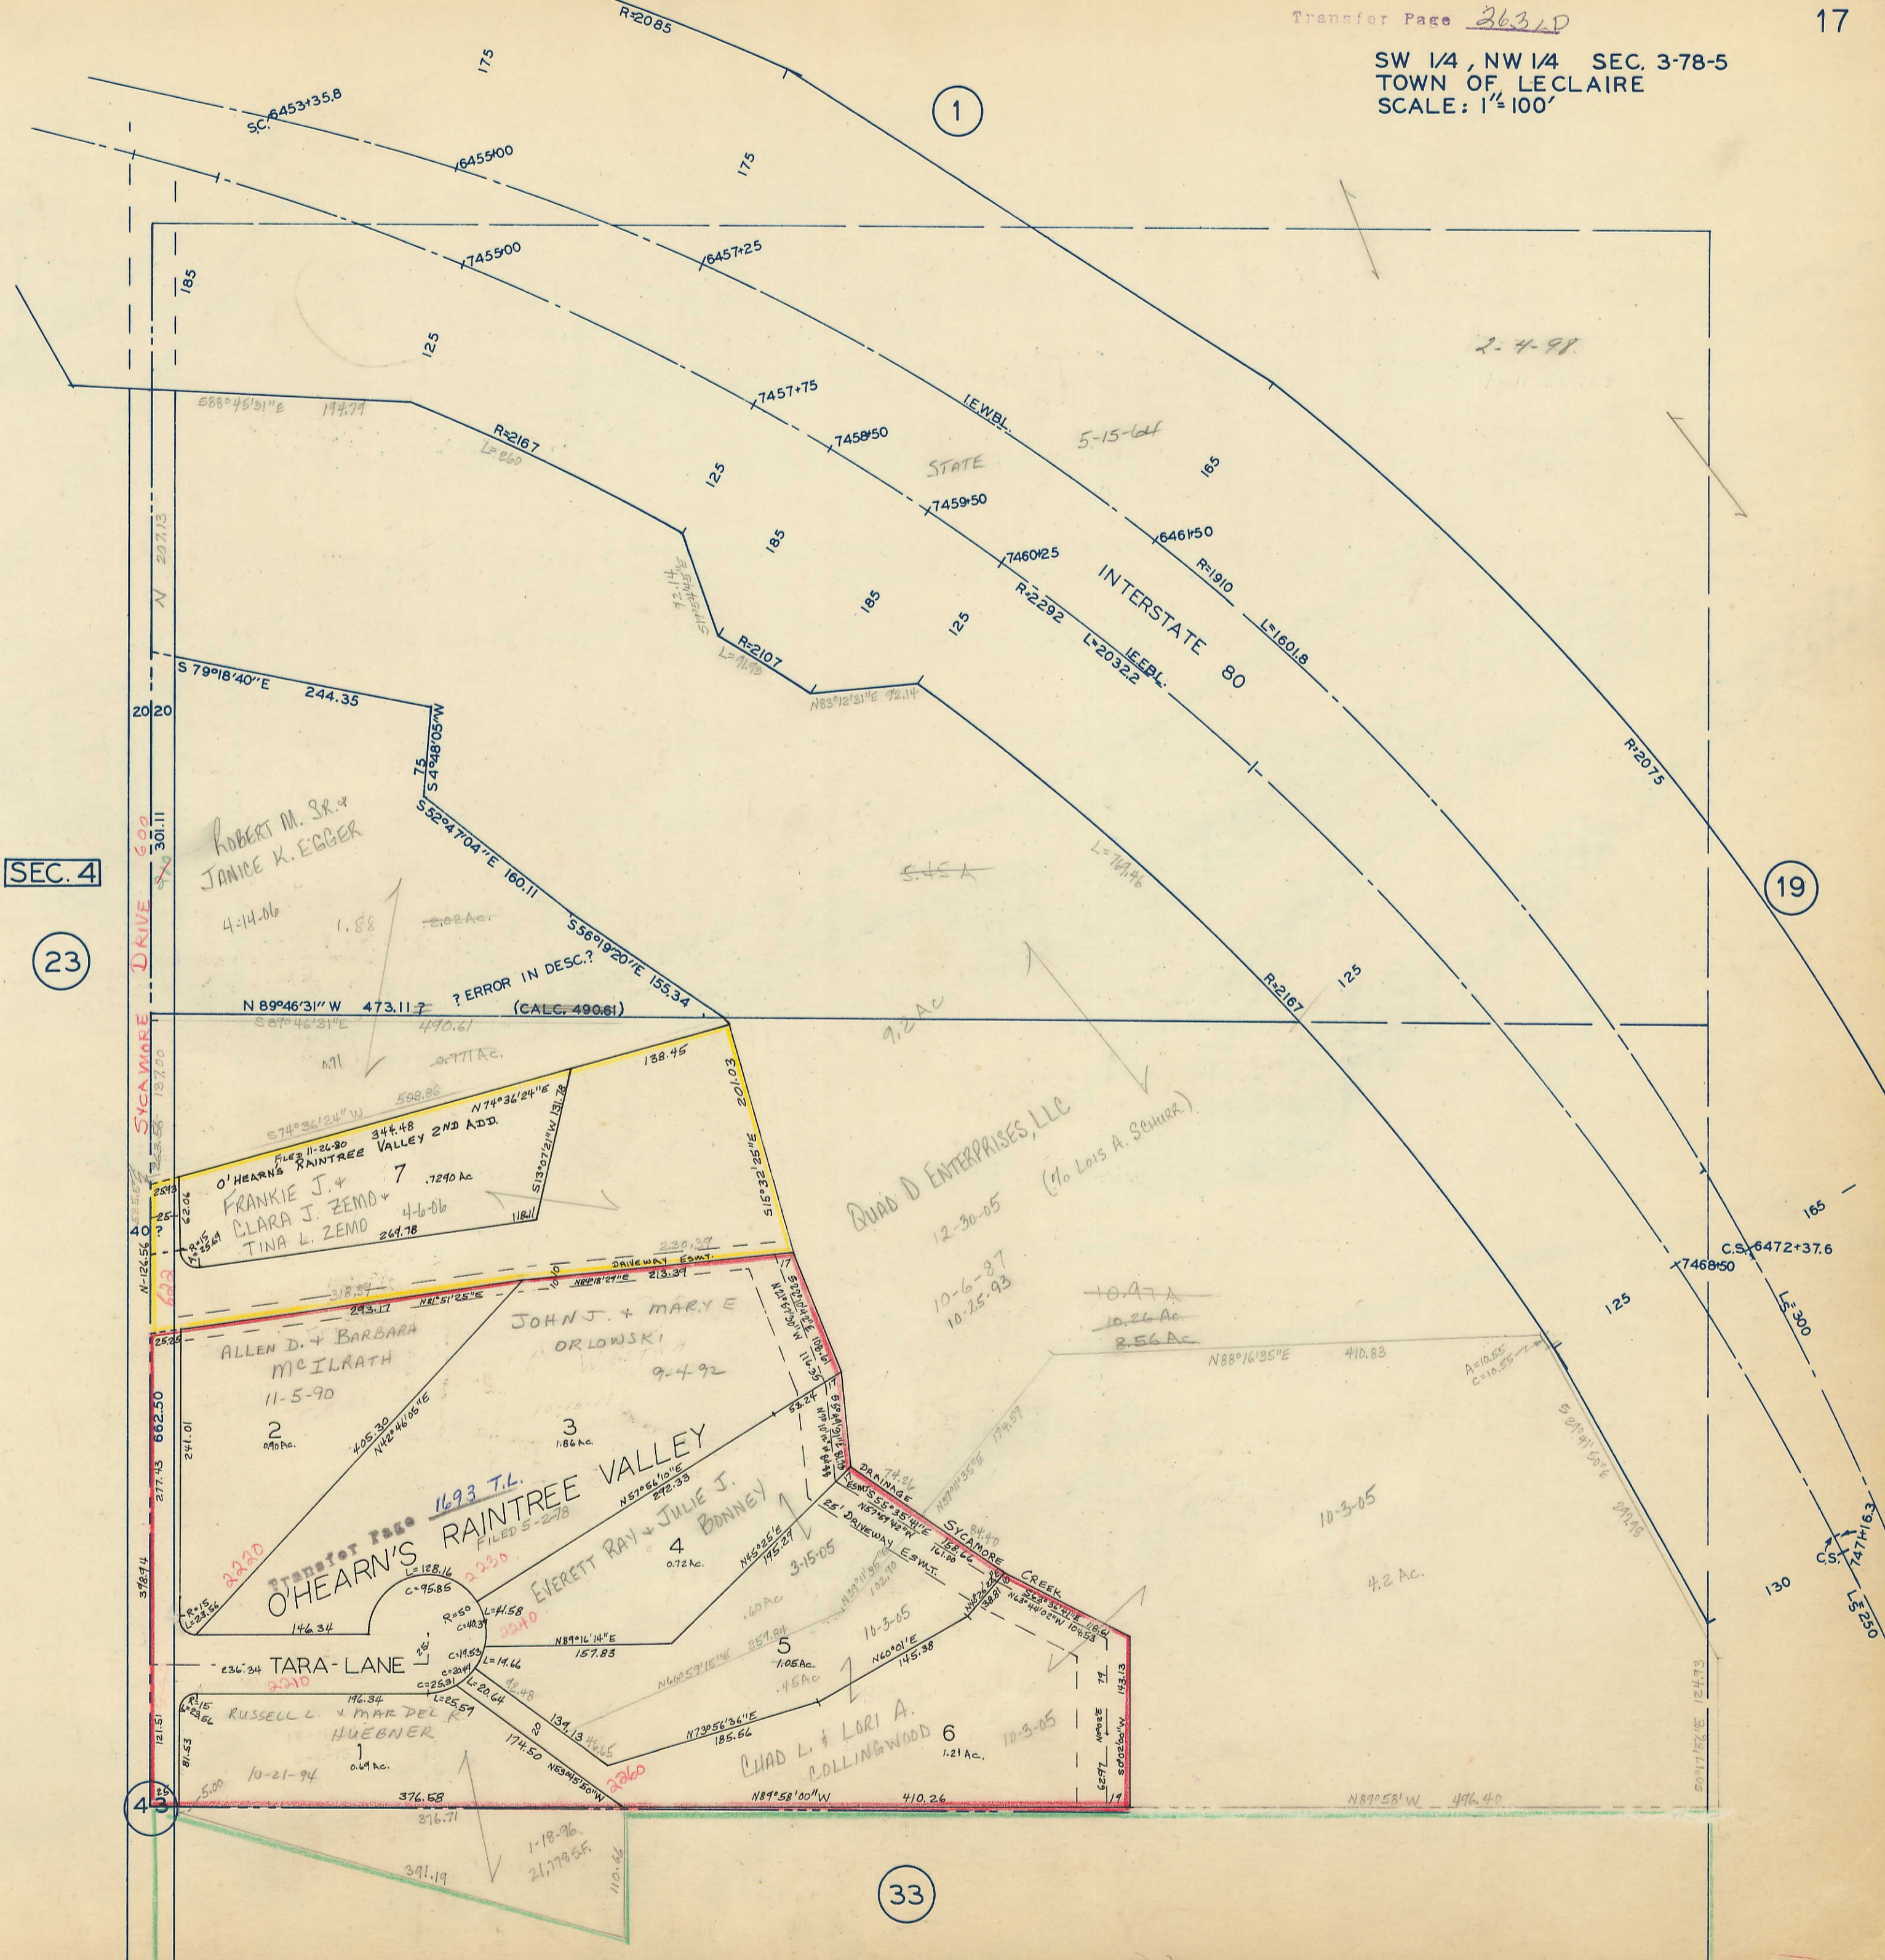

SEC. 4

23

19

33

SYCAMORE DRIVE 600

4

ROBERT M. SR. & JANICE K. EGGER
4-14-06

O'HEARN'S RAINTREE VALLEY 2ND ADD.
FRANKIE J. & CLARA J. ZEMO
TINA L. ZEMO

ALLEN D. & BARBARA MCILRATH
11-5-90

JOHN J. & MARY E. ORLOWSKI
9-4-92

O'HEARN'S RAINTREE VALLEY
EVERETT RAY & JULIE J. BONNEY

TARA-LANE
RUSSELL L. & MAR DEL HUEBNER

CHAD L. & LORI A. BOLLINGWOOD

QUAD D ENTERPRISES, LLC
12-30-05

10-6-87
10-25-93

10-3-05

10-3-05

2-4-98

5-15-04

588°45'31"E 174.77

S 79°18'40"E 244.35

S 52°47'04"E 160.11

N 89°46'31"W 473.11 ? ERROR IN DESC.?
(CALC. 490.81)

S 74°36'24"W 598.86

N 74°36'24"E 344.48

N 81°51'25"E 293.17

N 89°16'14"E 157.83

N 73°56'36"E 185.86

N 89°58'00"W 410.26

N 89°58'00"W 496.40






7457+75

7458+50

7459+50

7460+25

7461+50

















S. 45 A

9.2 AC

10.97 A

10.26 AC

2.56 AC

4.2 AC

C.S. 6472+37.6

7468+50










165

125

125

165

185

125

125

175

175

185

2020

30.11

137.00

25.50

25.50

25.50

25.50

277.43

378.74

121.51

376.58

376.71

391.19

391.19

R=216.7

L=260

R=210.7

L=117.2





















































































































































