


10-18-05
COUNTRY CLUB EAST LLC

PEBBLE CREEK NORTH 7TH SW 1/4, NW 1/4 SEC. 4-78-5
TOWN OF LE CLAIRE
SCALE: 1"=100'

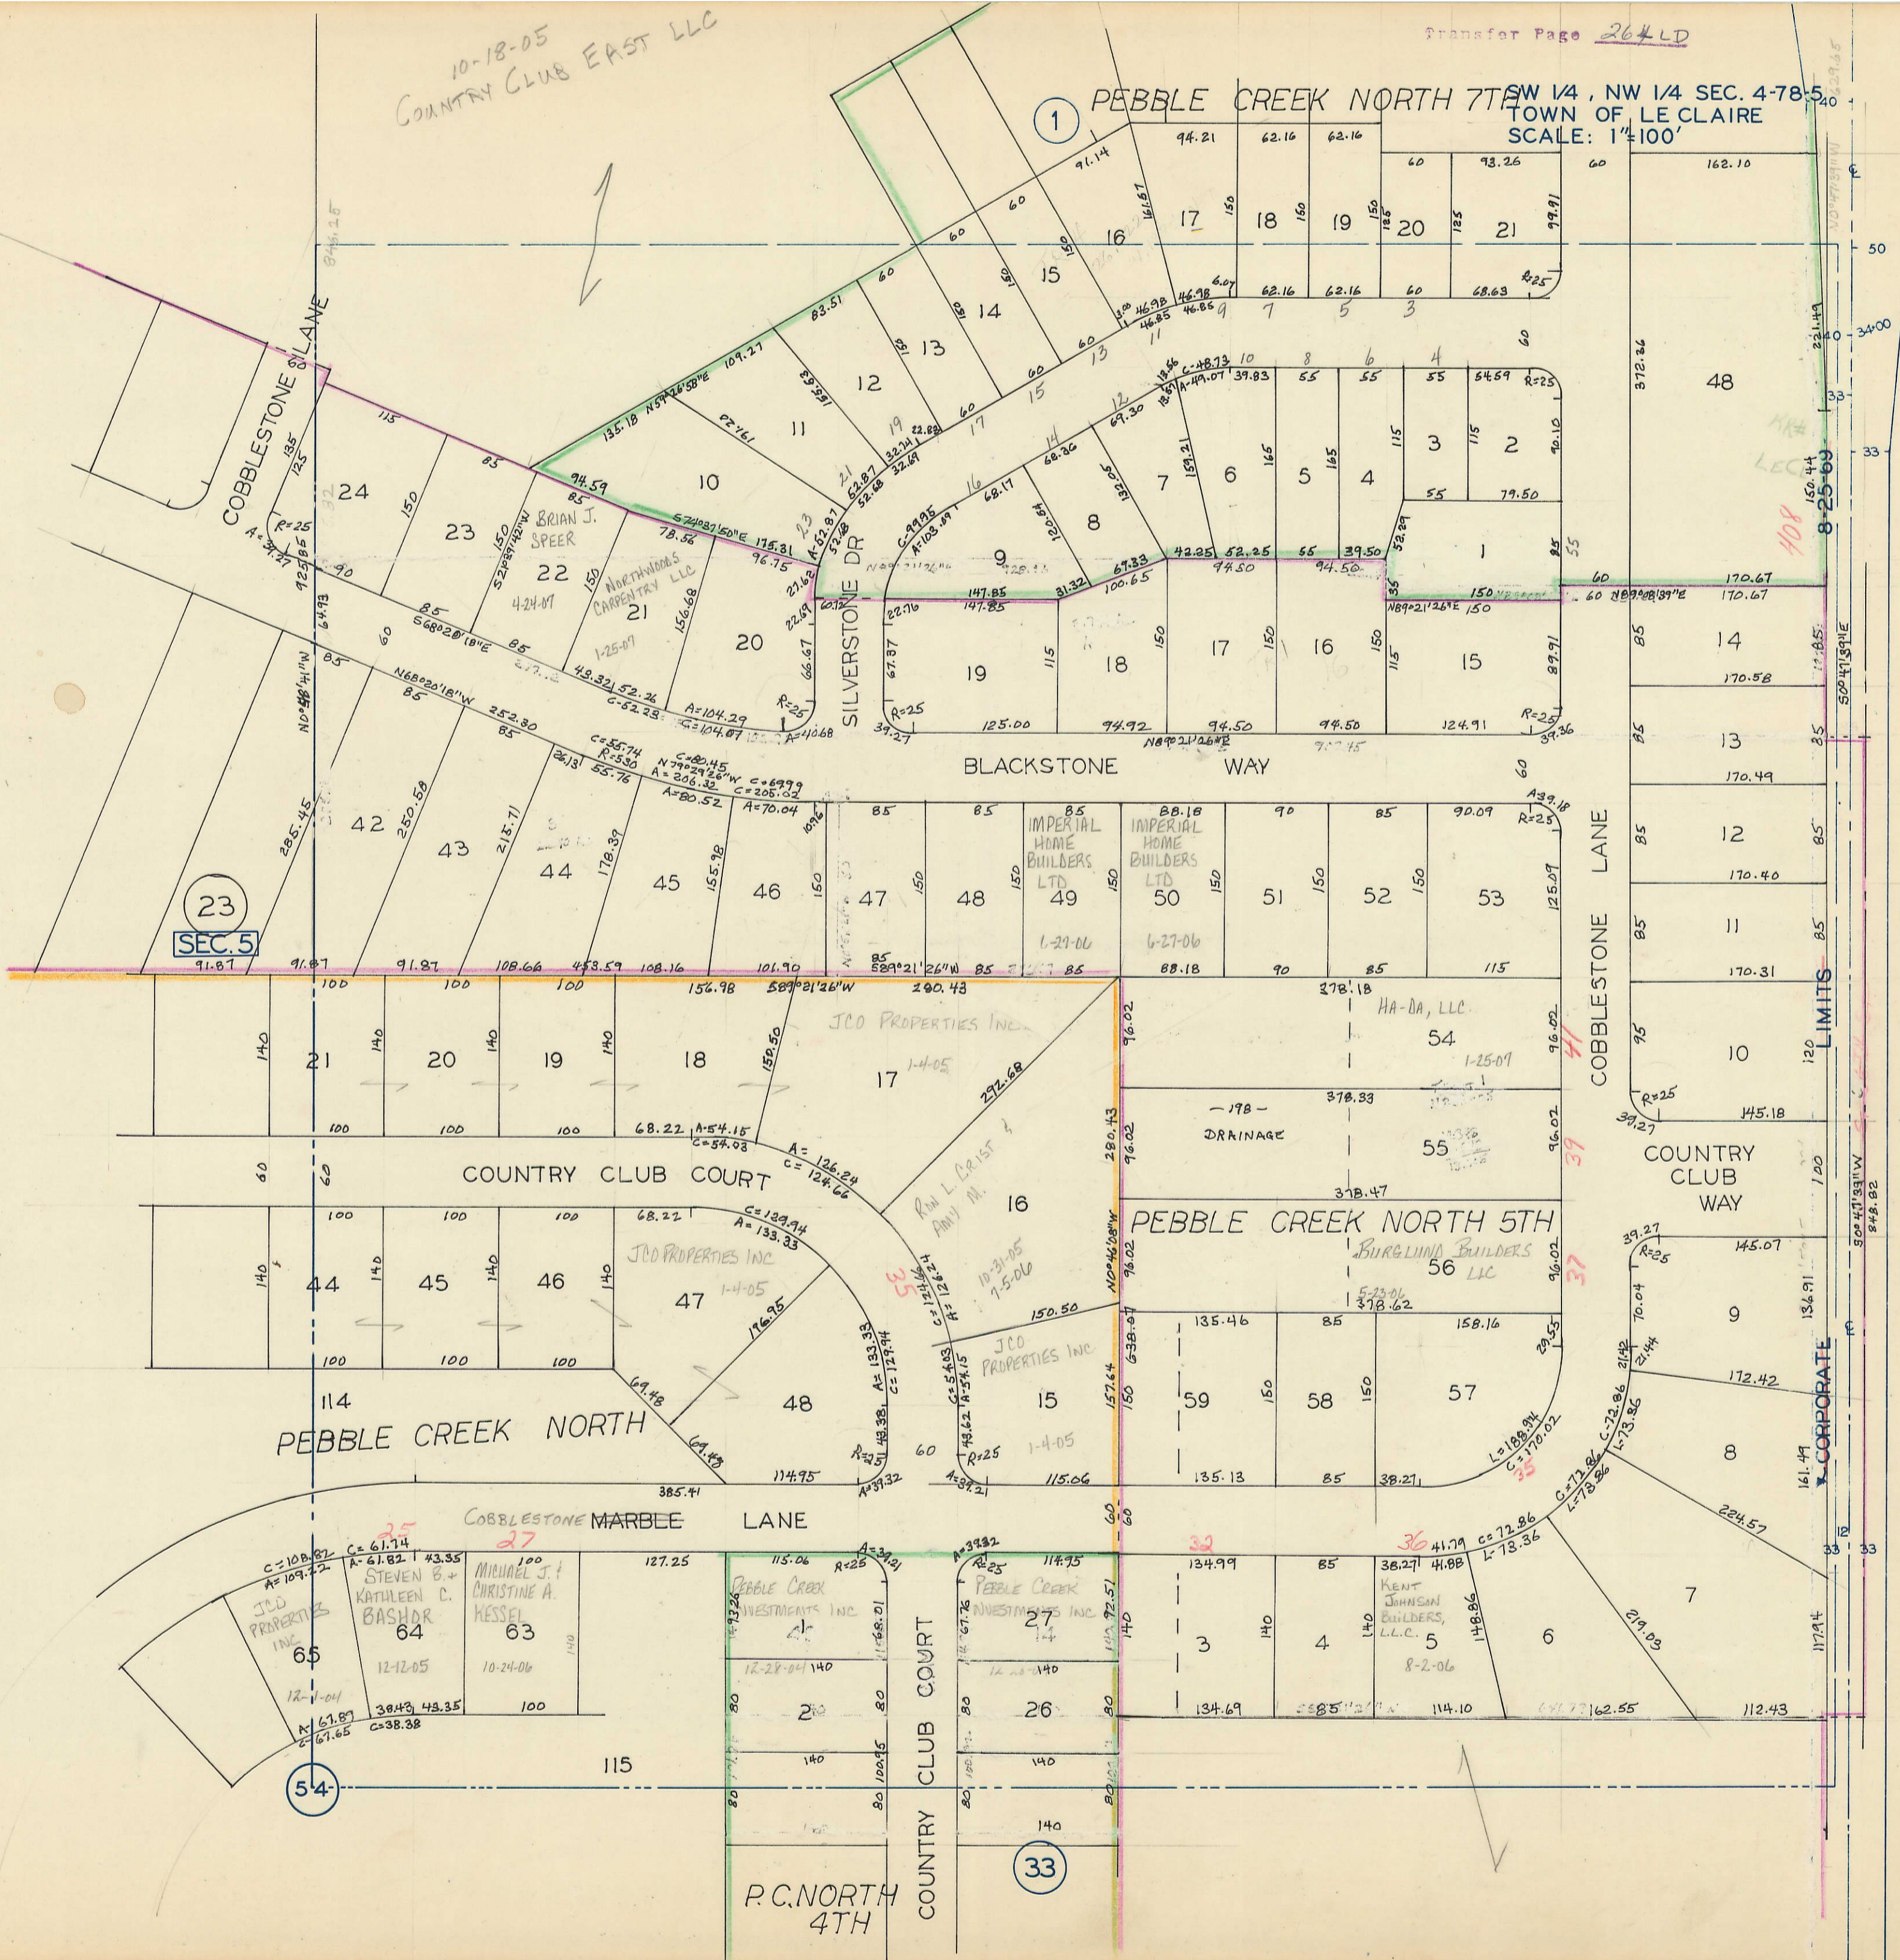

23
SEC. 5

19

54

33

P.C. NORTH
4TH

LIMITS
CORPORATE