

SW 1/4, SE 1/4 SEC. 34-79-5  
TOWN OF LE CLAIRE  
SCALE: 1" = 100'

(51)


GOV'T. LOT 4  
52.54 AC.

JOHNSON  
8-4-71  
9-2-71  
3-30-55  
10-15-86  
VERNON E. JOHNSON TRUST  
MARJORIE R.

CONT.  
MARK S MUSAL-  
58821-03.  
JENNIFER L. MUSAL  
3-8-06

SURVEY 54635-03  
2.20 AC  
95,659 SF


LIMITS  
CORPORATE  
W-LINE LE CLAIRE'S RESERVE  
STREET  
15TH  
Transfer Page 464 TL

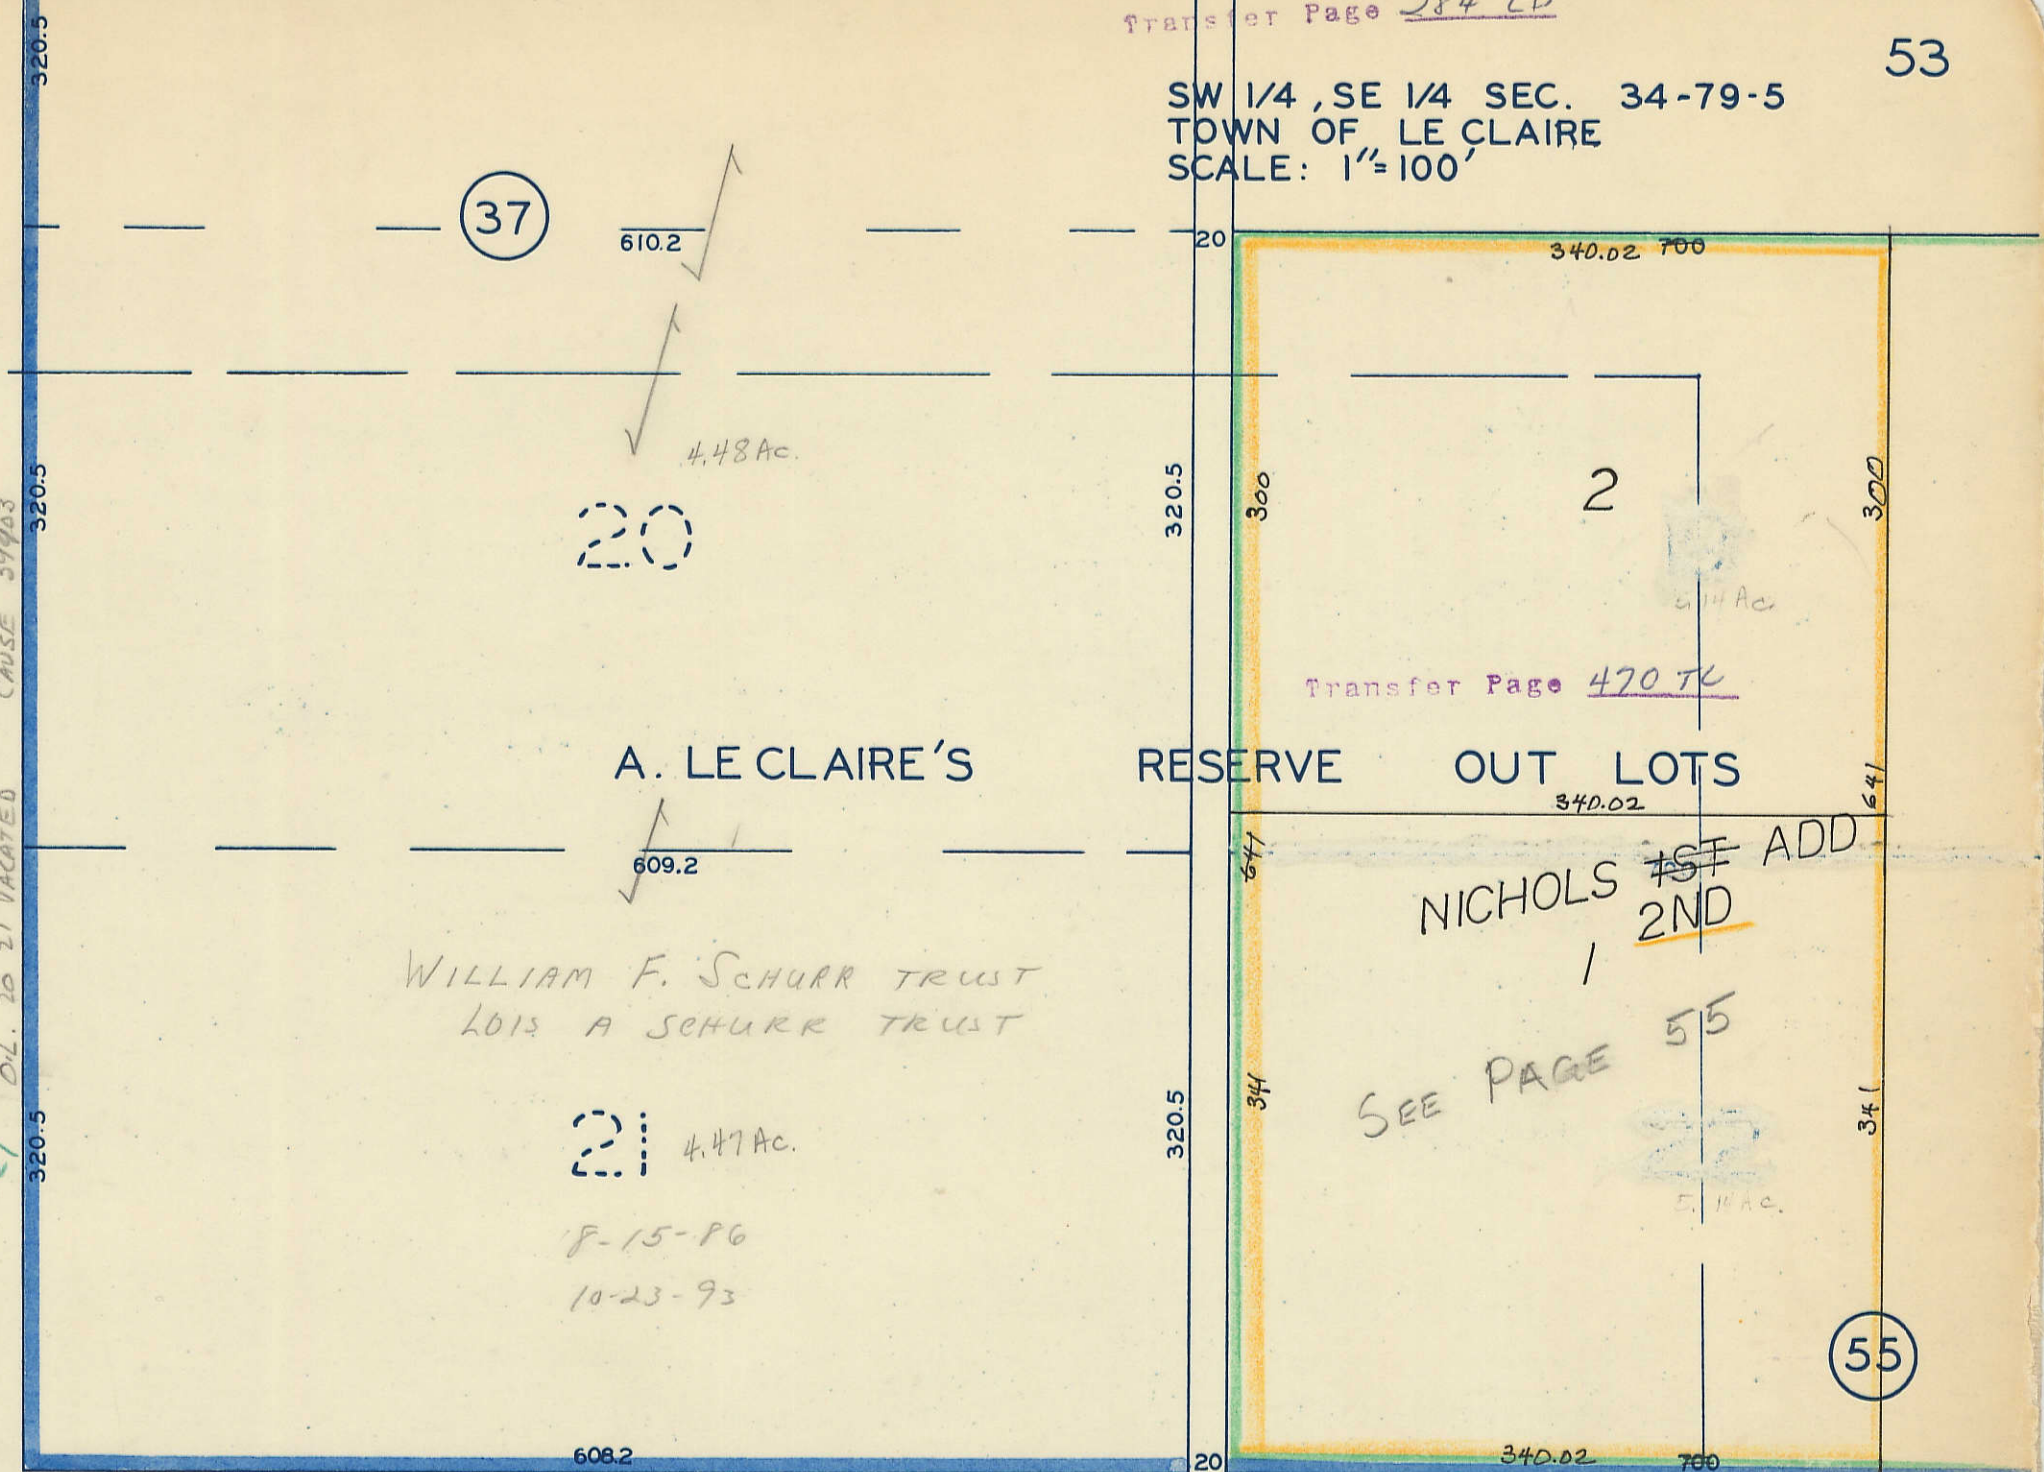


Transfer Page 470 TL

NICHOLS 1ST ADD  
2ND  
SEE PAGE 55


REYNOLDS

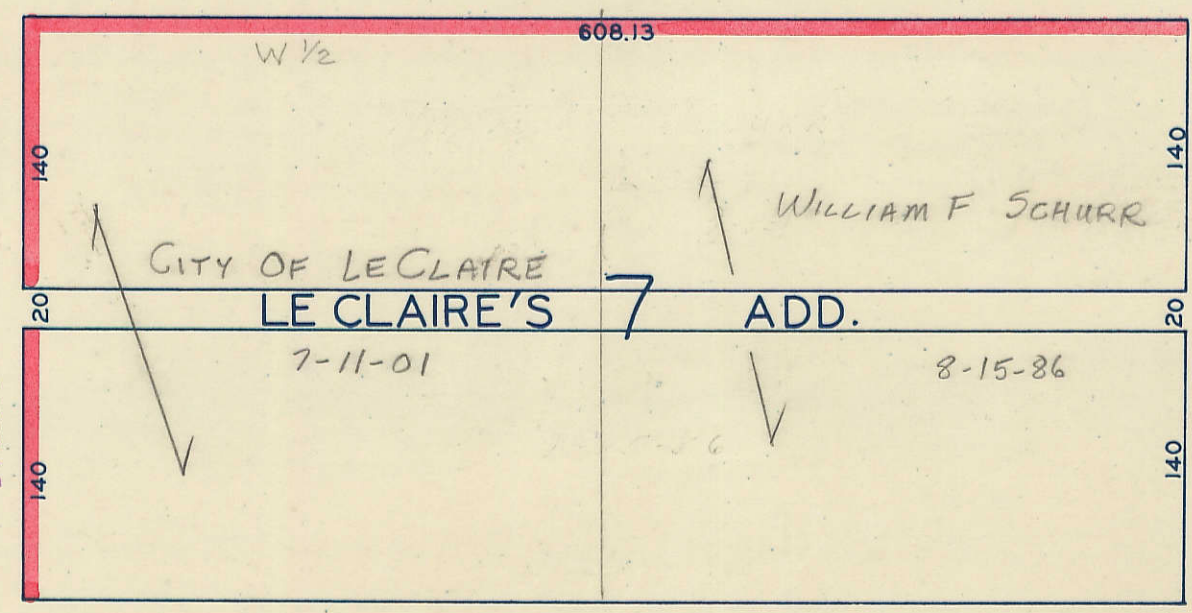

STREET

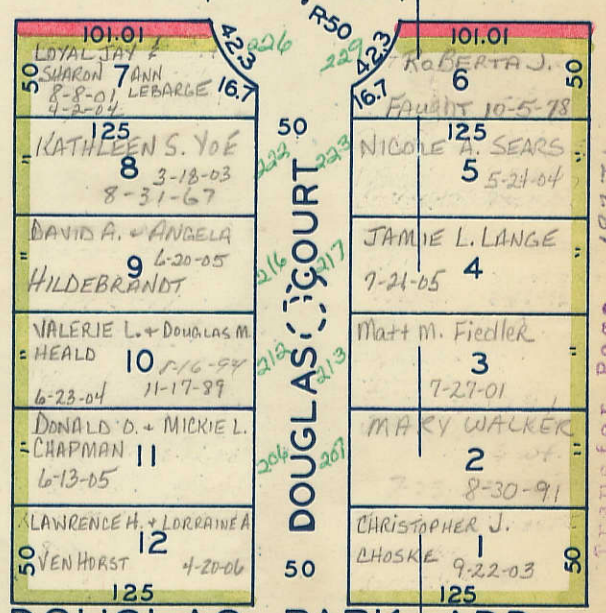


JONES

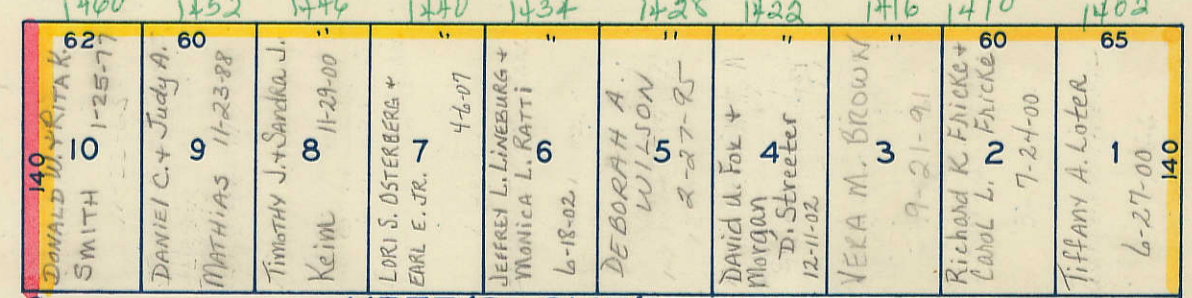


DOUGLAS PARK ADD.  
1321 STREET

KREB'S SUBD. BLK. 8

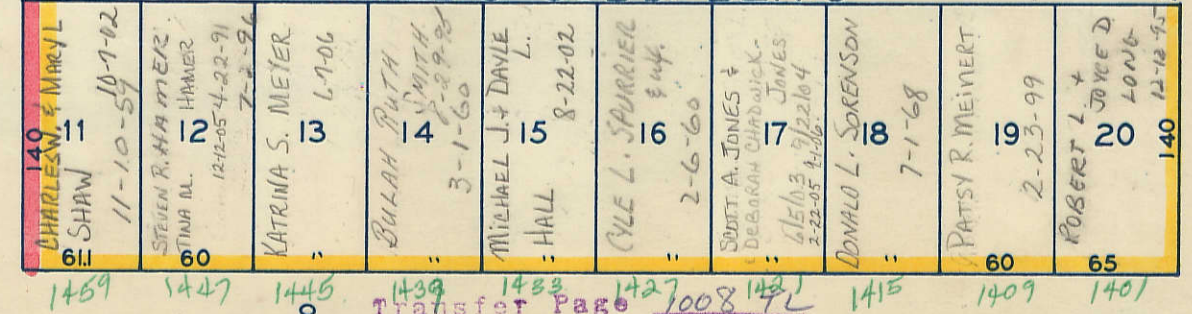

1326 75 300 100

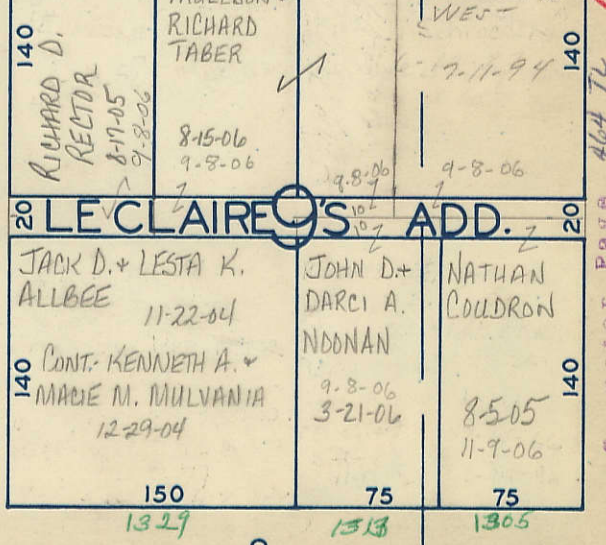

WISCONSIN

STREET

14TH

13TH

(5)

SEC. 3

BLK. 21

(7)

BLK. 20

LE CLAIRE'S ADD.

GREEN LAWN ADD.