


Transfer Page 275 LANDS

NE 1/4, NW 1/4 SEC. 23-79-5  
SCALE: 1"=100'

SECTION 14

PAGE 1

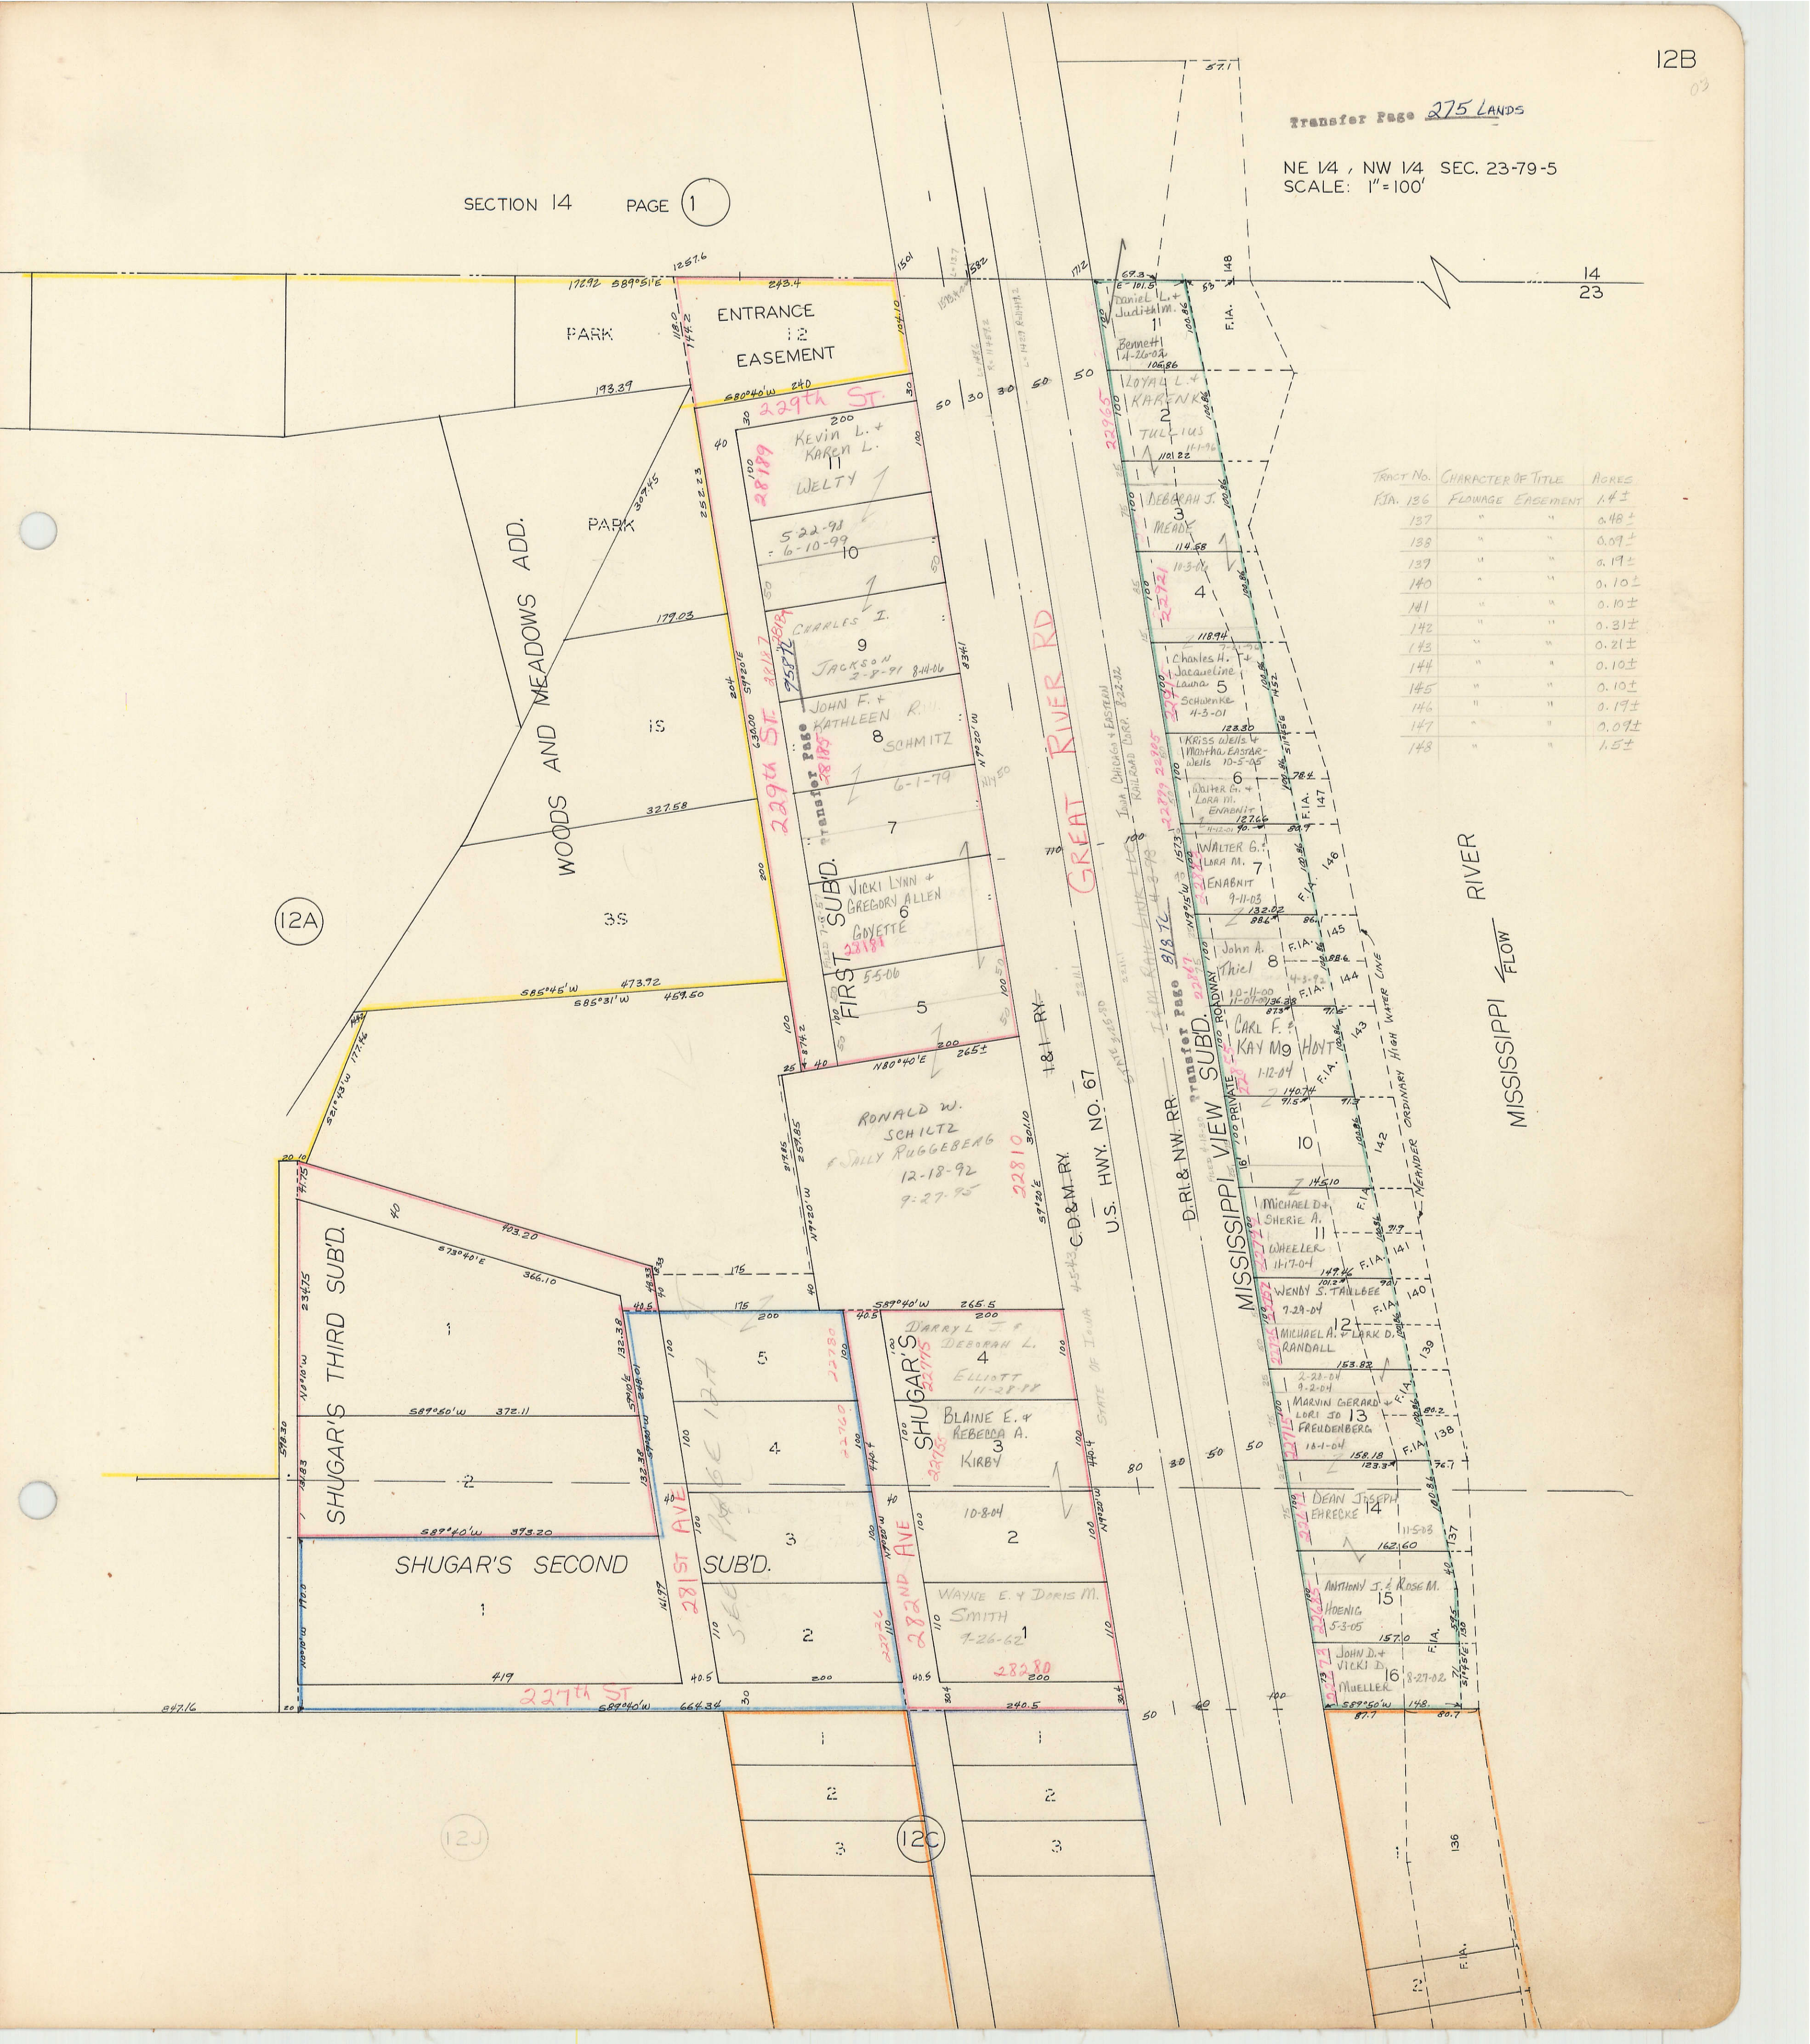

TRACT NO.	CHARACTER OF TITLE	ACRES
F.I.A. 136	FLOWAGE EASEMENT	1.4±
137	"	0.48±
138	"	0.09±
139	"	0.19±
140	"	0.10±
141	"	0.10±
142	"	0.31±
143	"	0.21±
144	"	0.10±
145	"	0.10±
146	"	0.19±
147	"	0.09±
148	"	1.5±

(12A)

(12J)

(12C)

MISSISSIPPI RIVER  
FLOW ←