


33, 35  
49, 51, 53

Transfer Page 276 LANDS  
SW 1/4 & SE 1/4 SEC. 26-79-5  
SCALE: 1"=200'

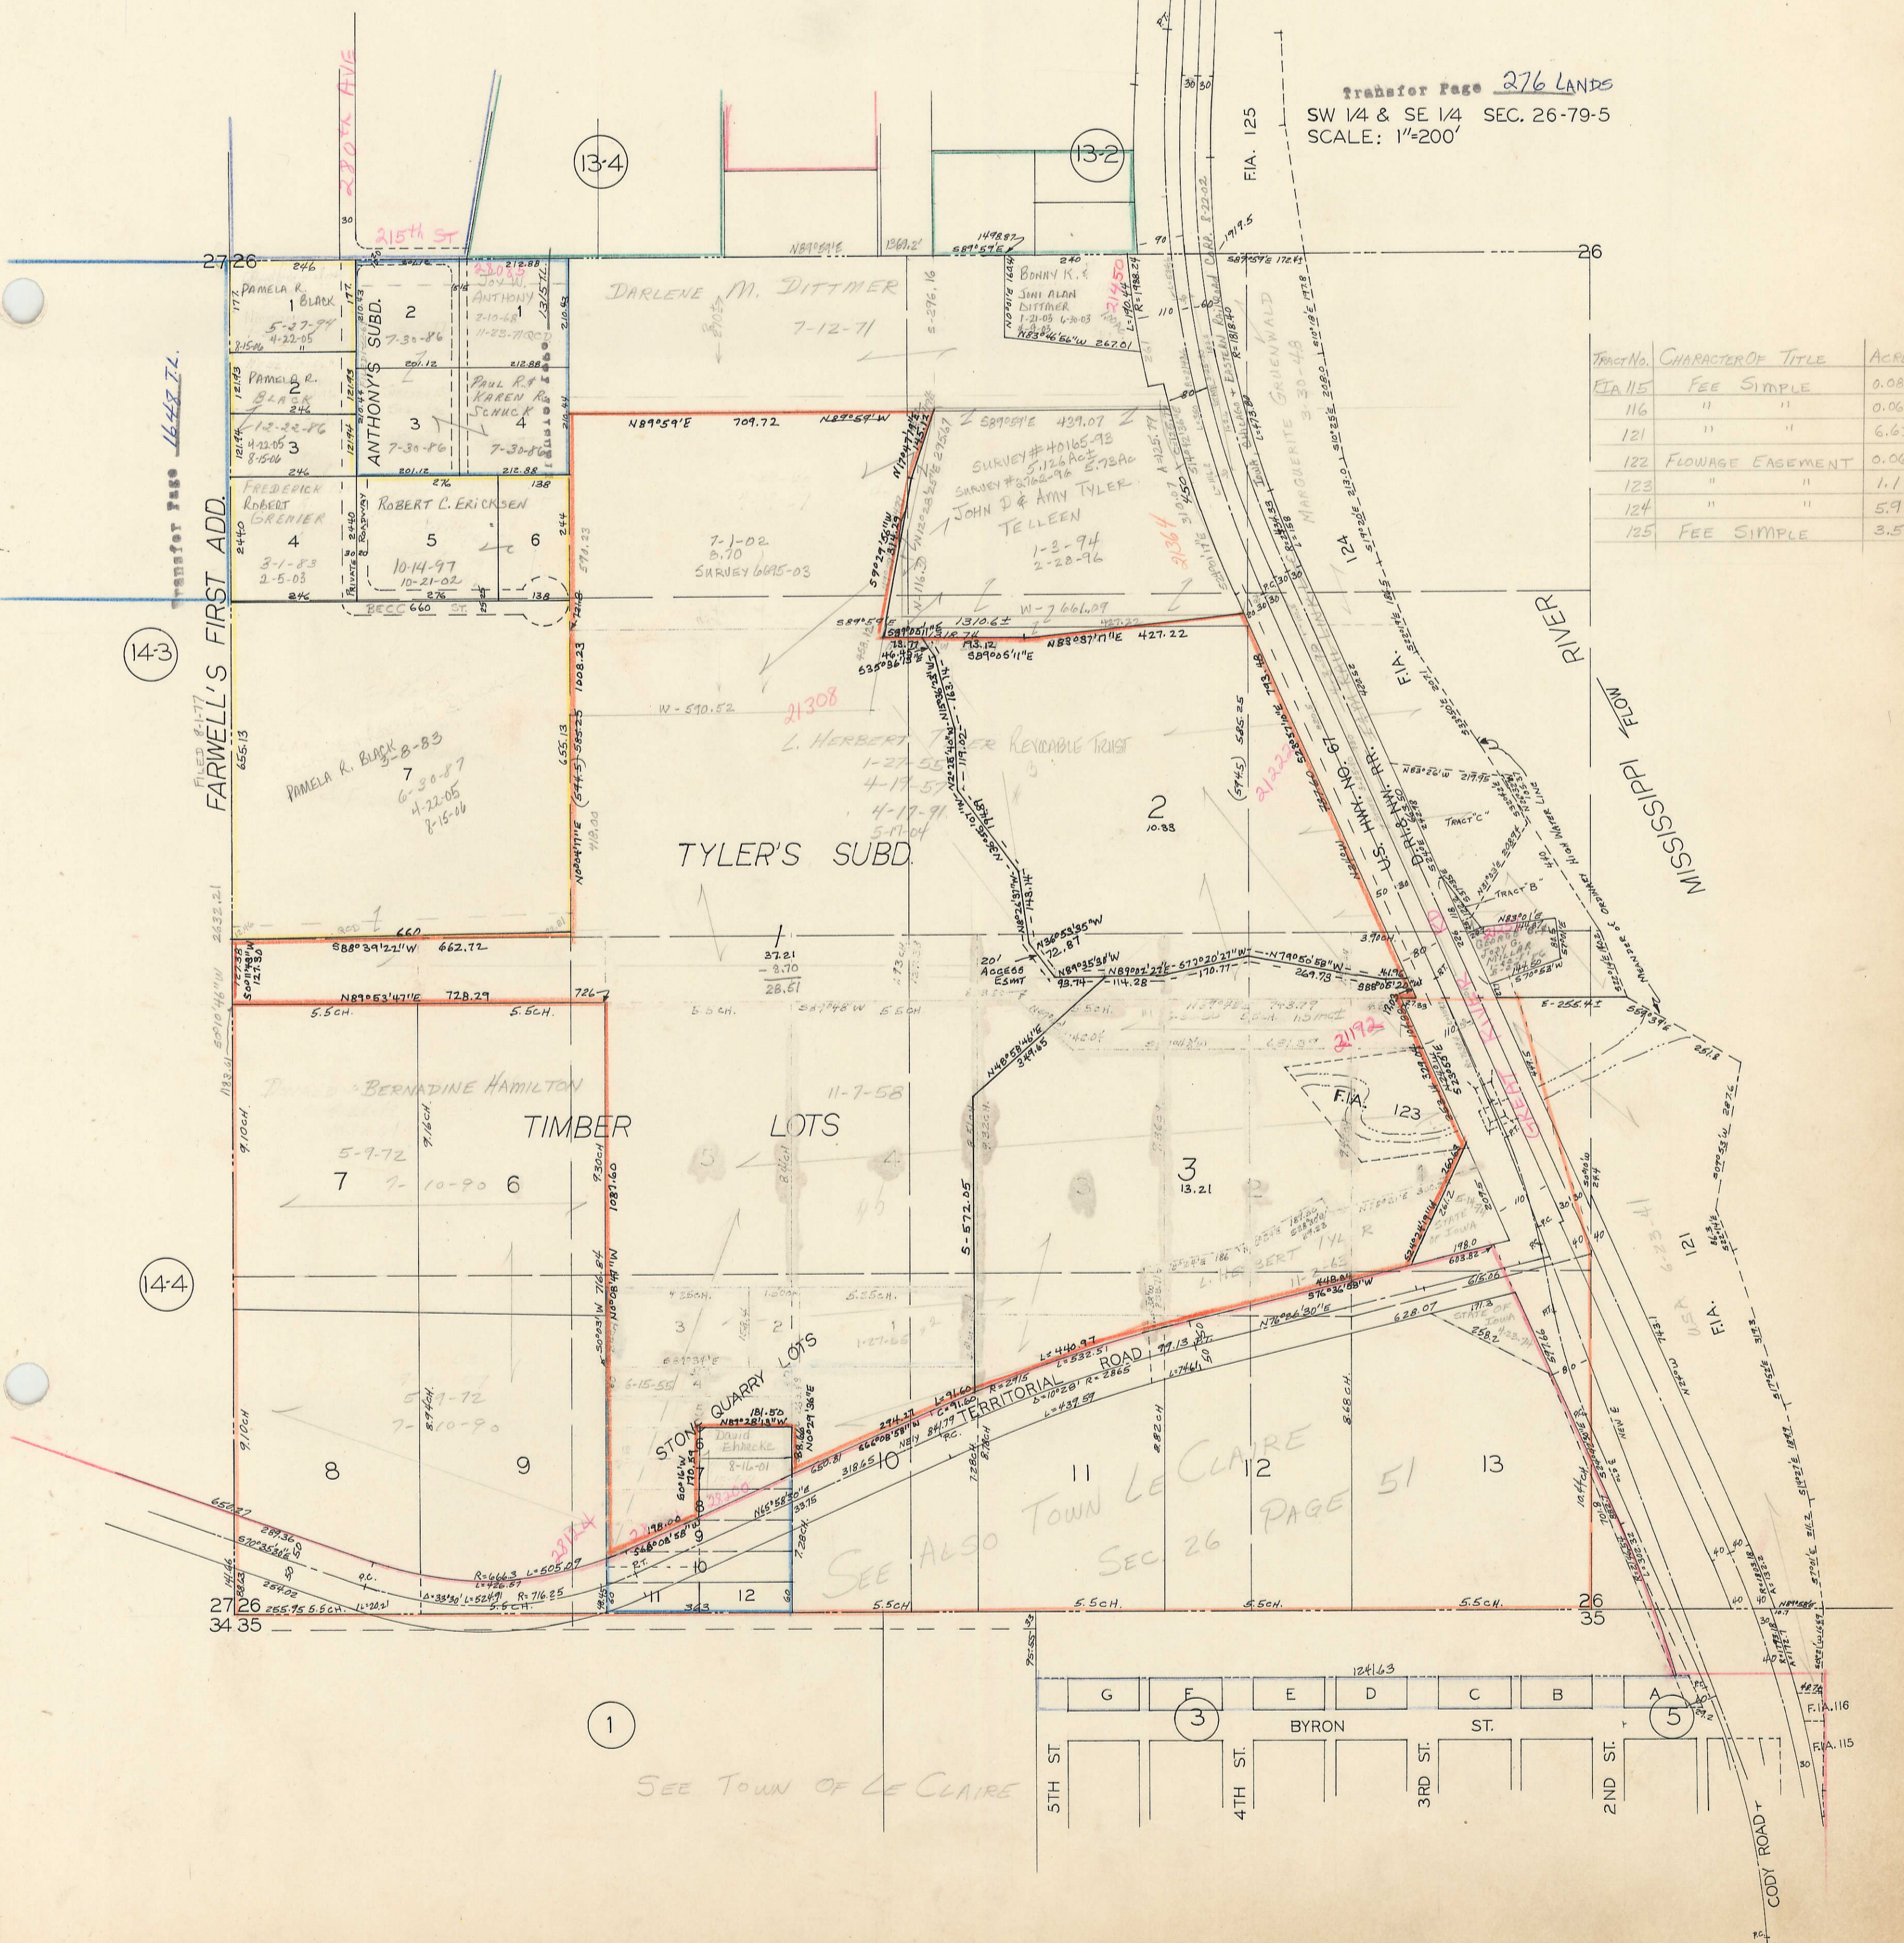

TRACT NO.	CHARACTER OF TITLE	ACRES
123	" "	1.1±
124	" "	5.9±
125	FEE SIMPLE	3.5±

SEE ALSO TOWN LE CLAIRE  
SEC 26 PAGE 51

SEE TOWN OF LE CLAIRE

