

Transfer Page 281 LANDS

SW 1/4, SW 1/4 SEC. 31-79-5  
SCALE: 1" = 100'

SEC. 30-79-4

BETTENDORF


BETT CORP. LIMITS

MARIE A. PAASKE'S SUBD.

INTERSTATE 80

PLEASANT VALLEY TOWNSHIP

SEC. 6-78-5

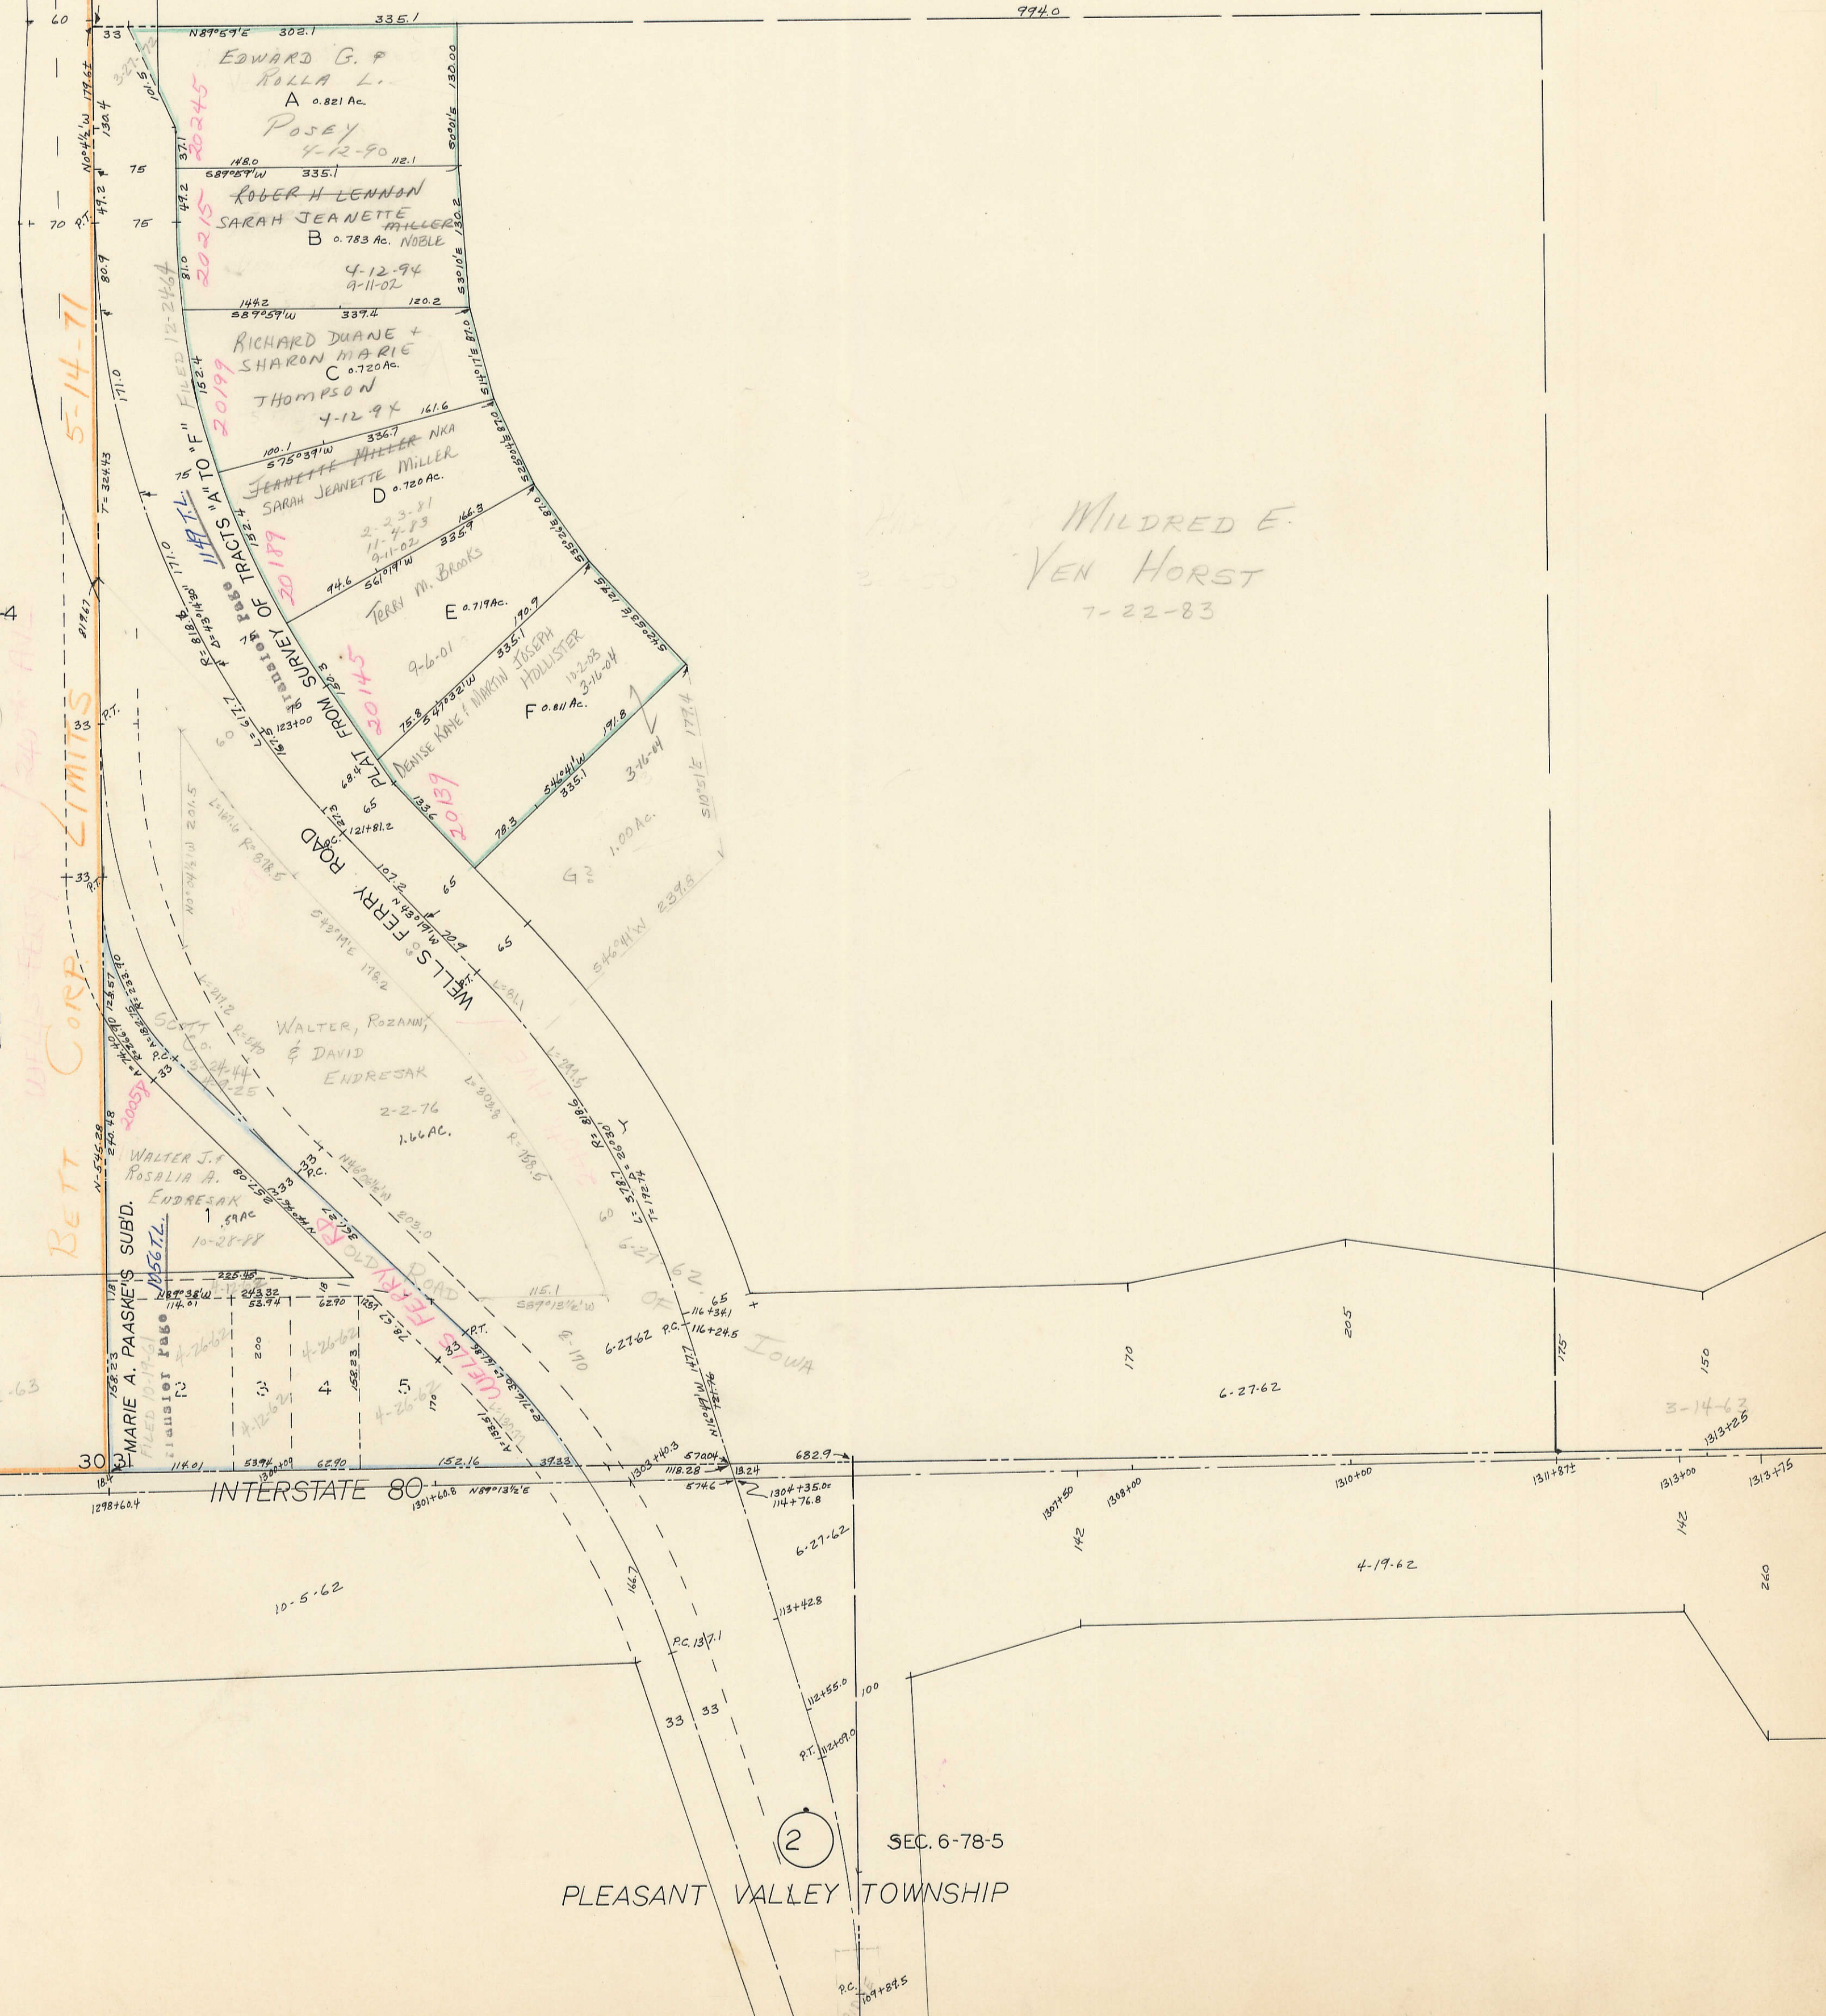

MILDRED E. VEN HORST  
7-22-83

19

2