


SW 1/4, SW 1/4 SEC. 4-78-5
SCALE: 1"=100'

Blank Lots: THE WOODS AT FOX HOLLOW, L.C.
2-11-99

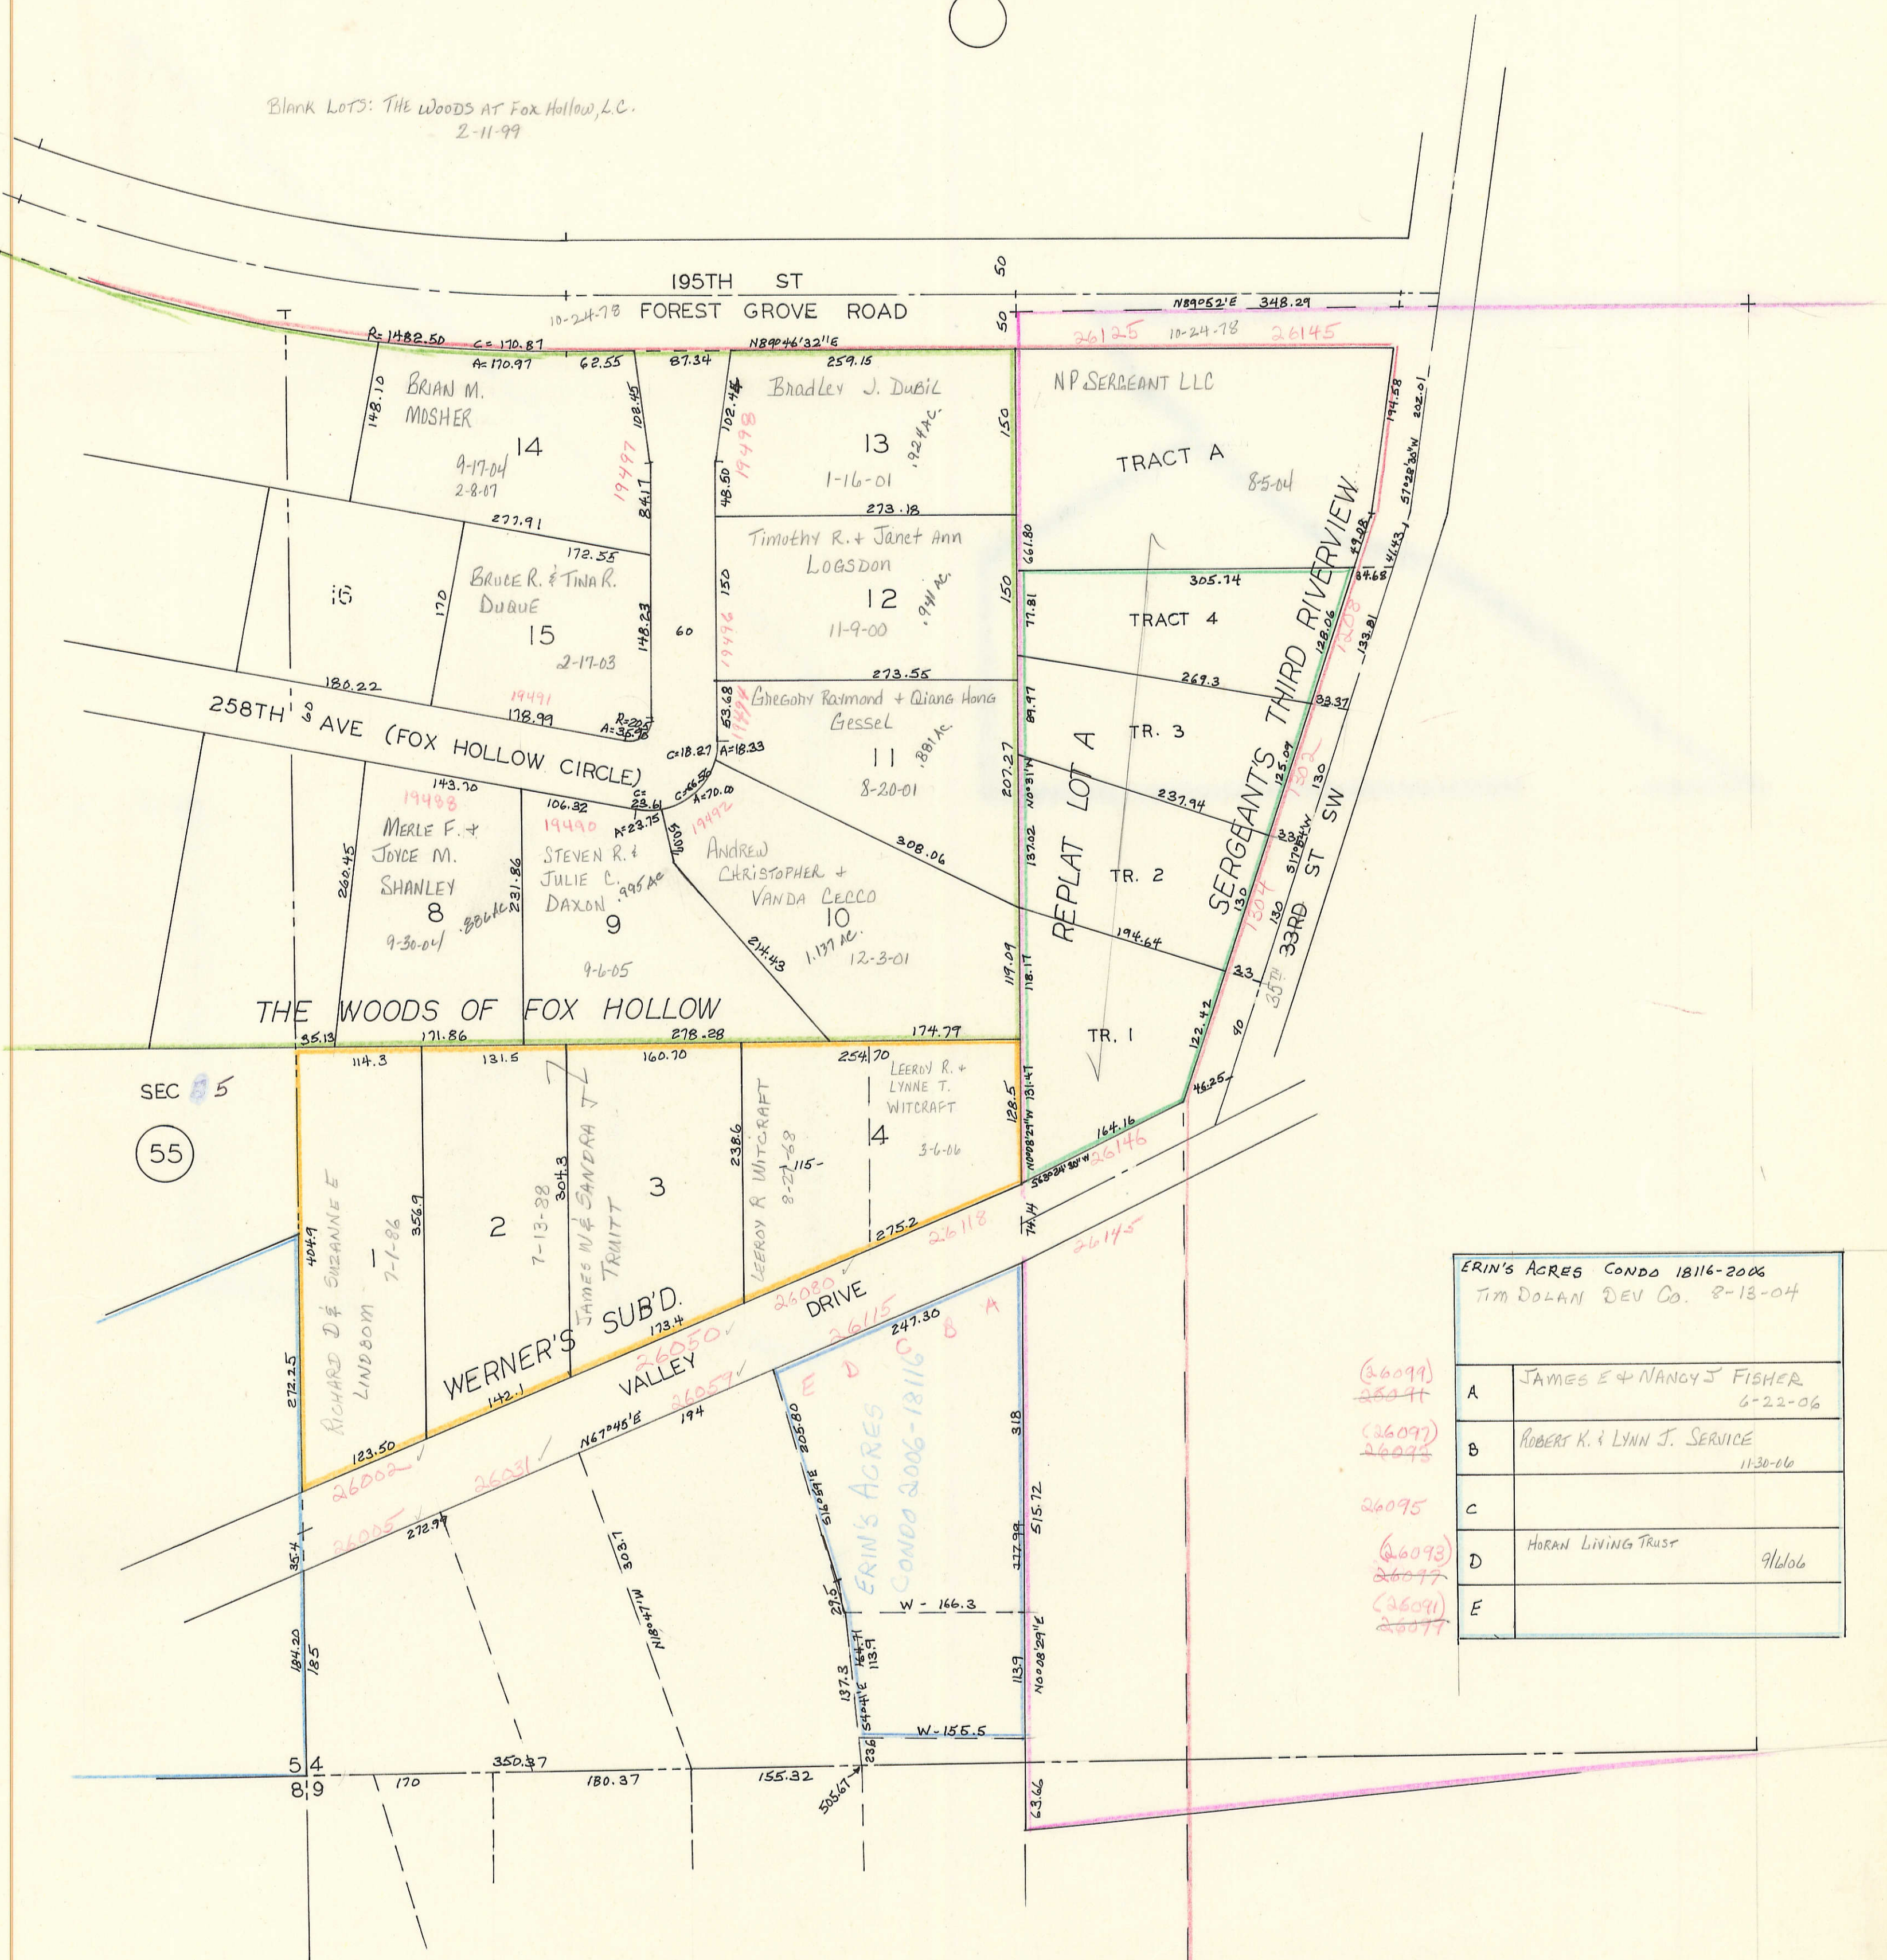

ERIN'S ACRES CONDO 18116-2006
TIM DOLAN DEV CO. 8-13-04

A	JAMES E + NANCY J FISHER 6-22-06
B	ROBERT K. + LYNN J. SERVICE 11-30-06
C	
D	HORAN LIVING TRUST 9/6/06
E	

(26099)
26077
(26097)
26095
26095
(26093)
26077
(26091)
26077