

FRACTIONAL SECTION 26

TOWNSHIP 79 NORTH, RANGE 5 EAST,

5TH PRINCIPAL MERIDIAN



LE CLAIRE TOWNSHIP

SCOTT COUNTY, IOWA

TRANSFER PAGE 276

SCALE: 1 INCH = 330 FEET

SECTION 23 PAGE 12

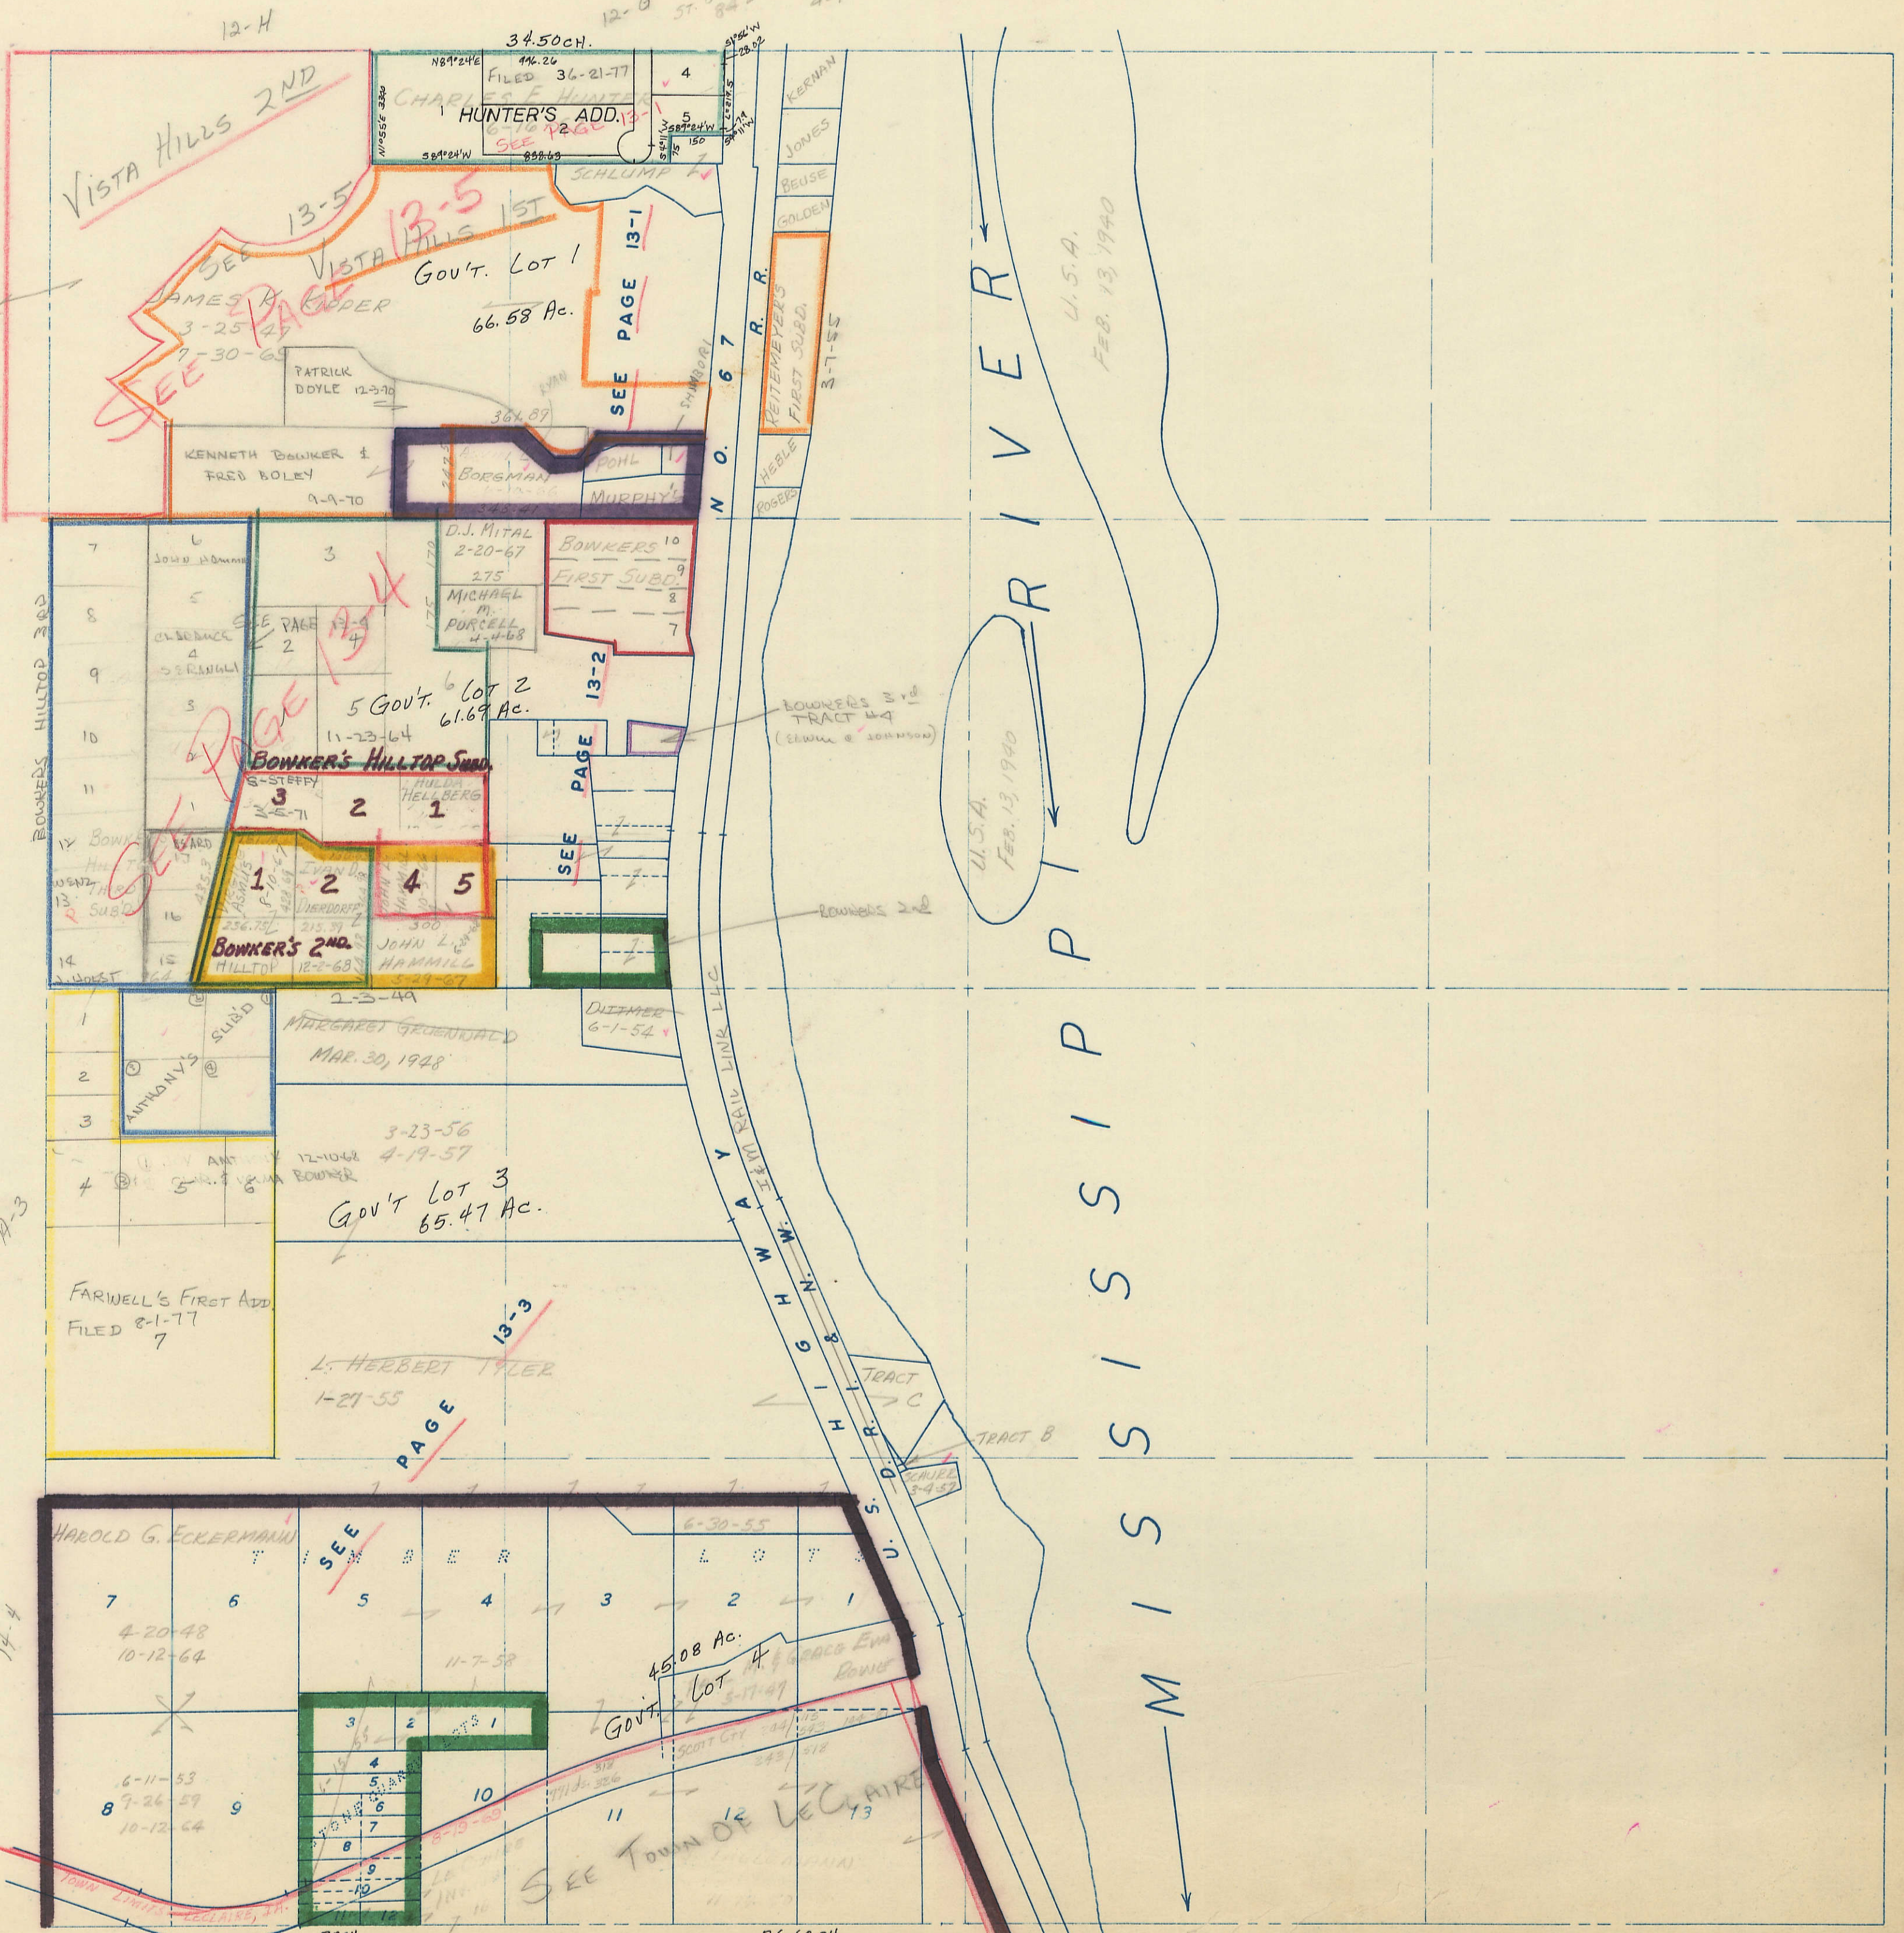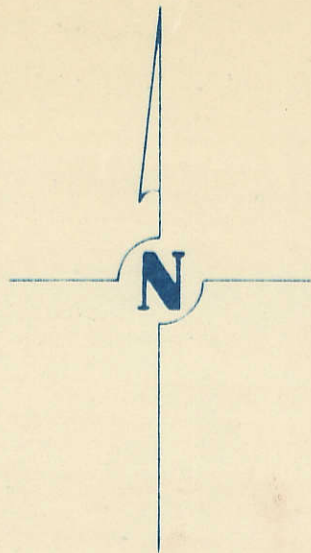

PAGE 14

SECTION 27

PAGE

SECTION

26

SECTION 35 PAGE 24