

SECTION
30

Township 79-North; Range 4

EAST OF THE FIFTH PRINCIPAL MERIDIAN

SCOTT COUNTY, IOWA
LINCOLN TOWNSHIP

SCALE IN CHAINS





SCALE IN FEET



Transfer Page 346

NORTH

220th ST

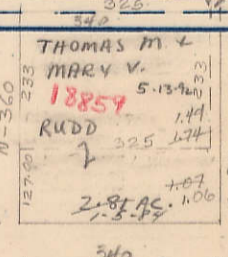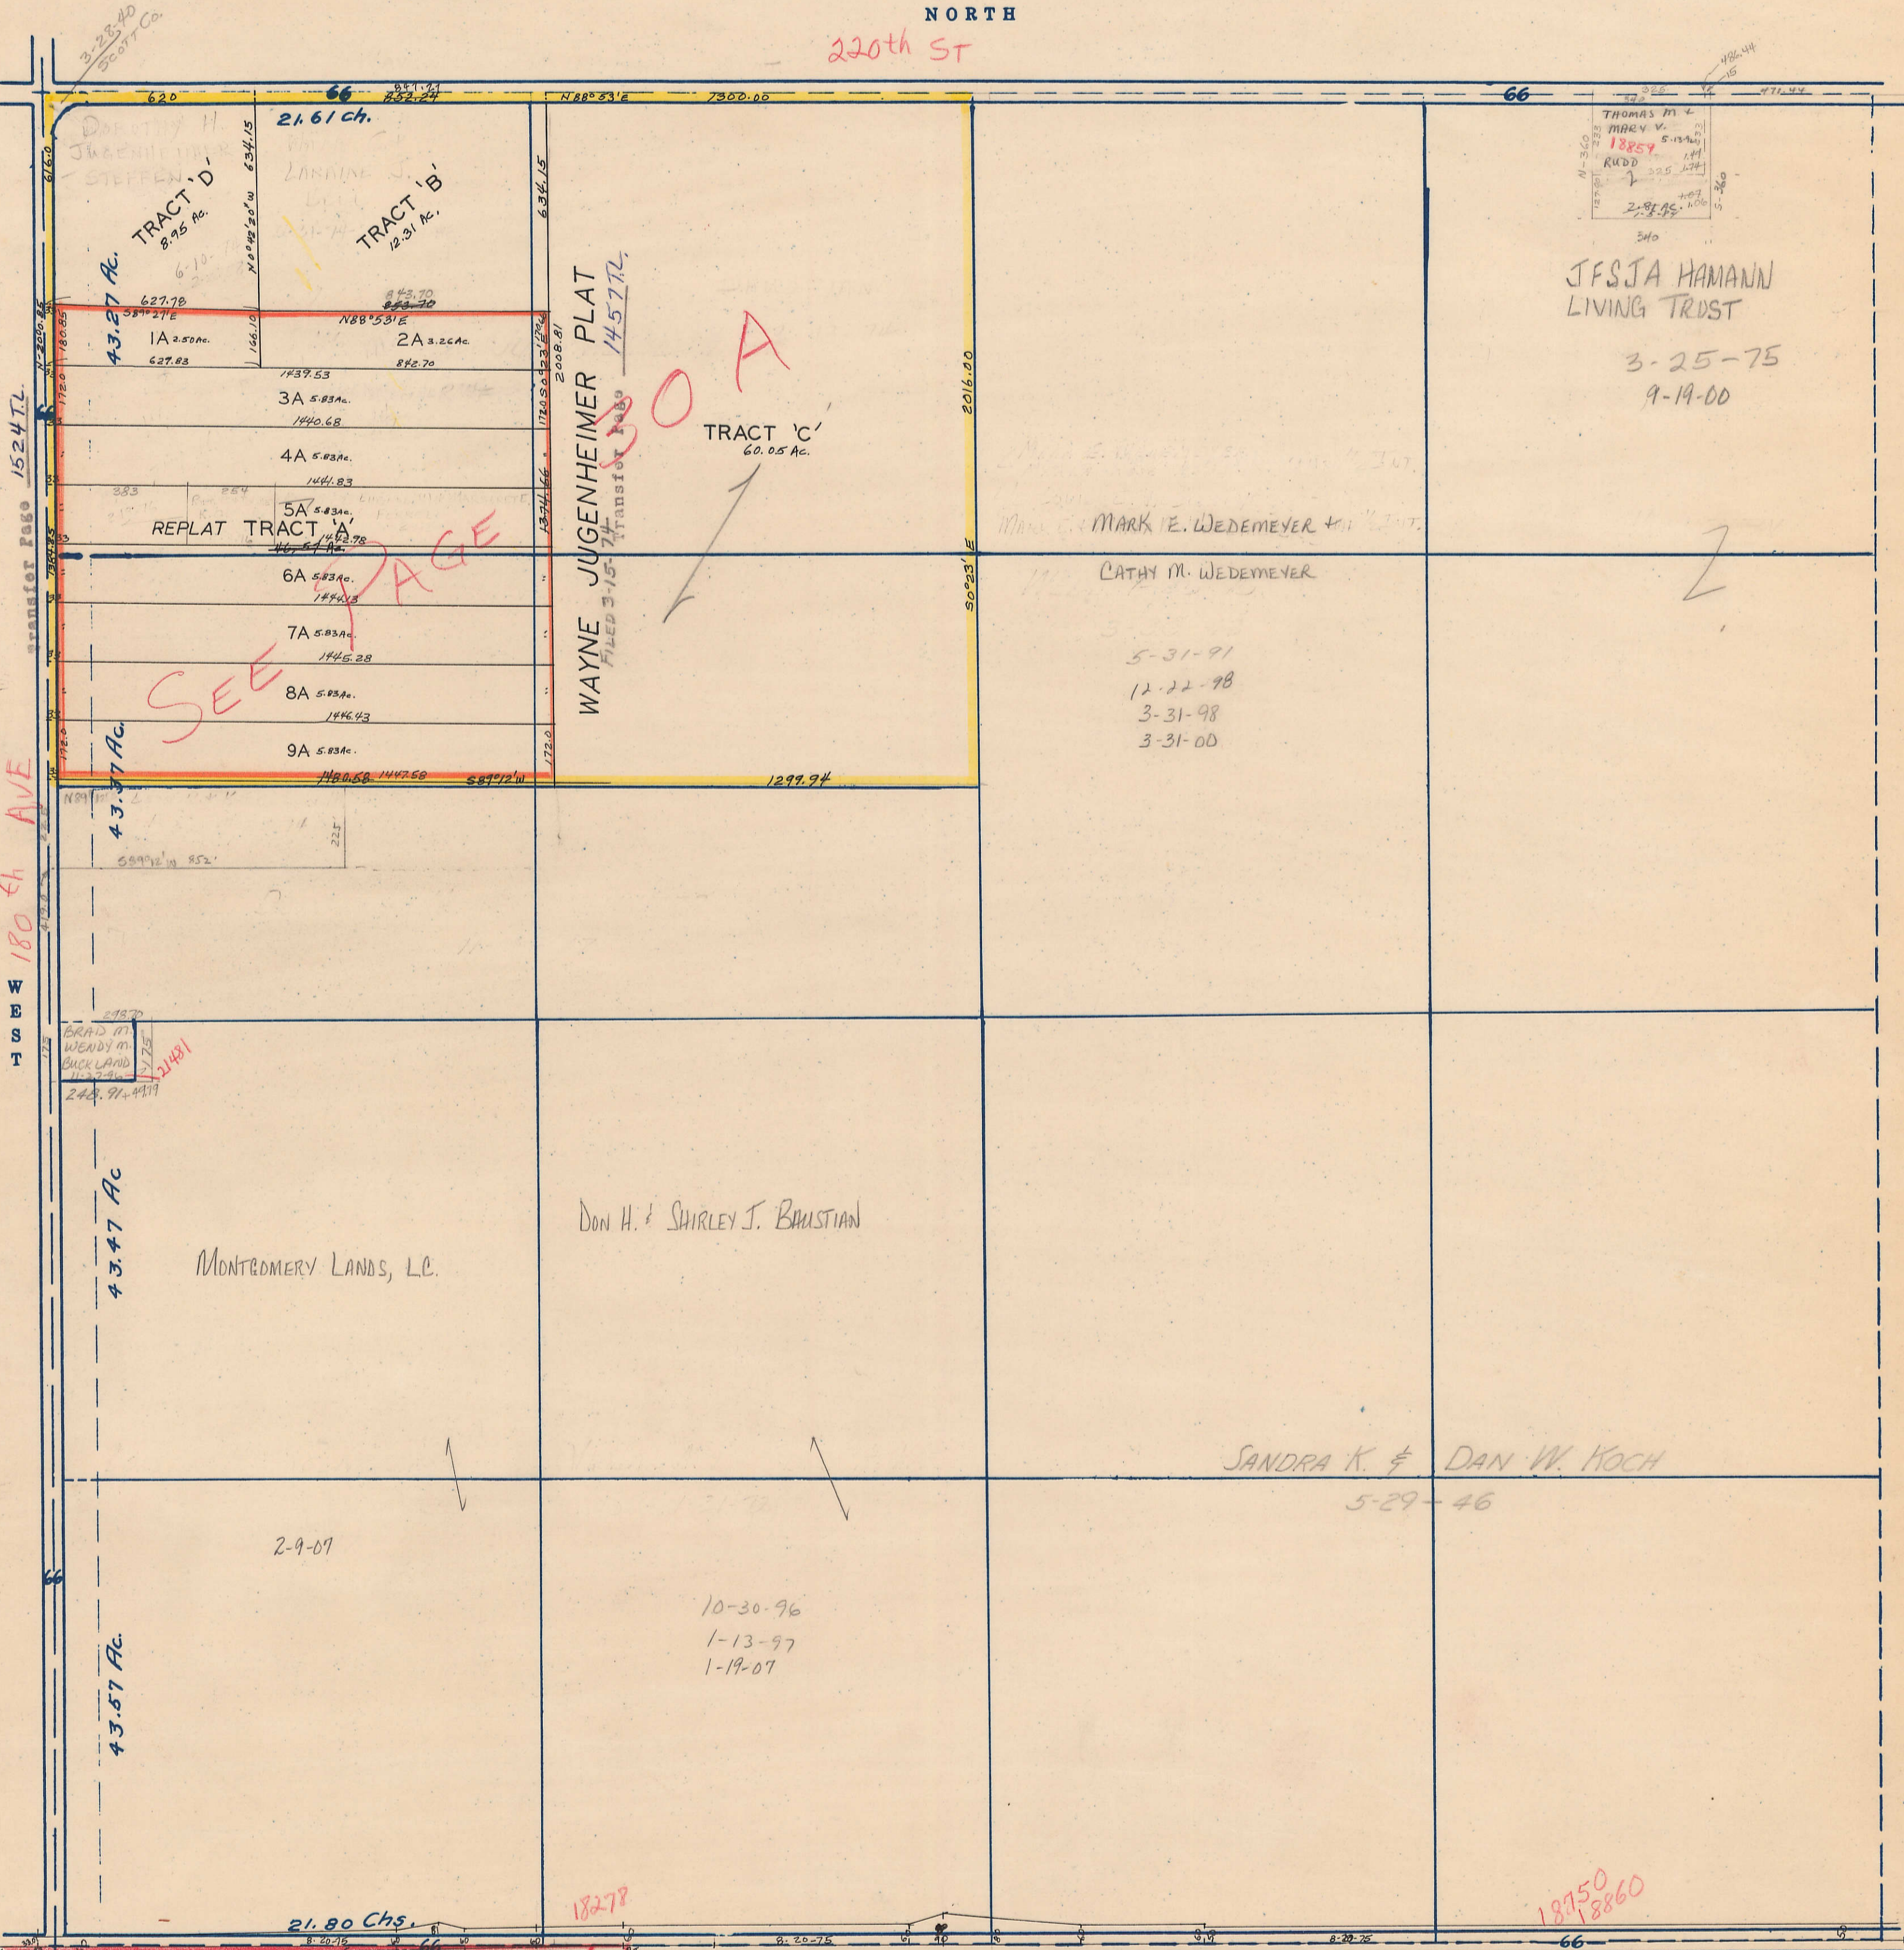

JFSJA HAMANN
LIVING TRUST

3-25-75
9-19-00

MARK E. WEDEMEYER & J. J. J. J.

CATHY M. WEDEMEYER

5-31-91
12-22-98
3-31-98
3-31-00

DON H. & SHIRLEY J. BAUSTIAN

MONTGOMERY LANDS, LC.

SANDRA K. & DAN W. KOCH

5-29-46

2-9-07

10-30-96
1-13-97
1-19-07

Transfer Page 1524 TL

WEST 180th AVE

EAST

CITY OF DAVENPORT

SOUTH

210th ST

18750
18860

18278

21.80 Chs.

4071
L
241