


03 10

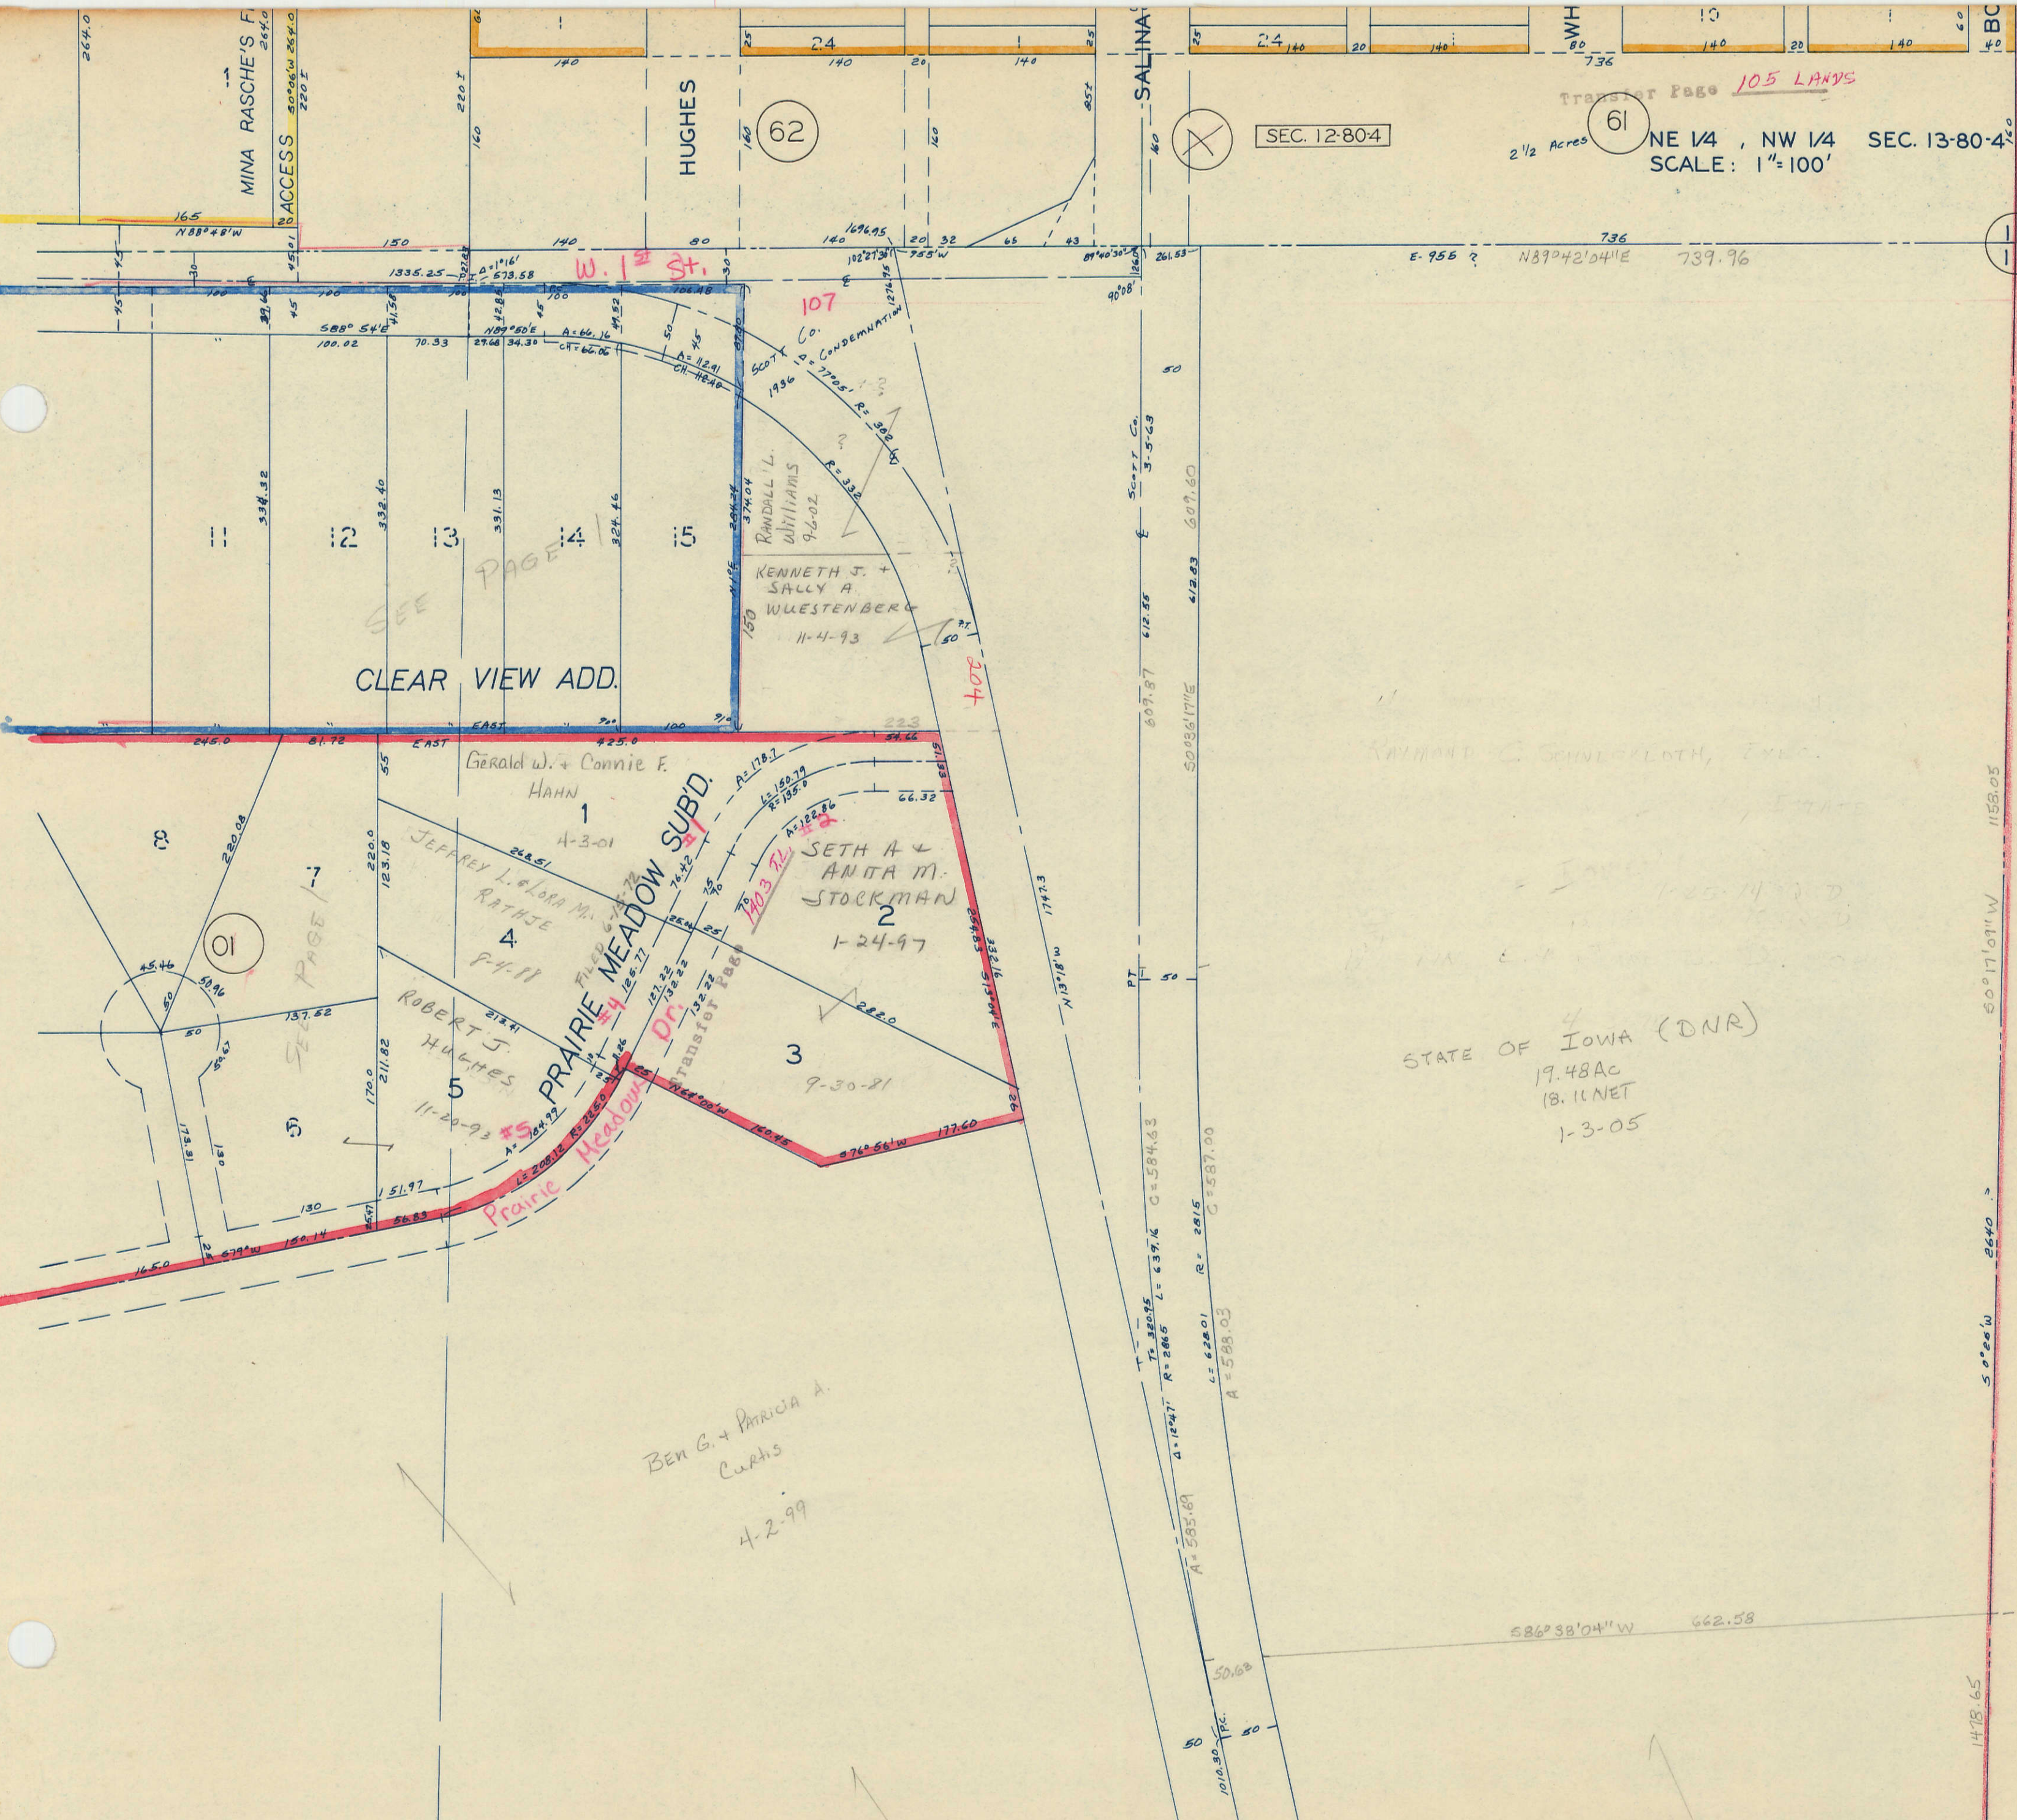

Transfer Page 105 LANDS

SEC. 12-80-4

61

NE 1/4, NW 1/4 SEC. 13-80-4
SCALE: 1"=100'

2 1/2 Acres

12
13

CLEAR VIEW ADD.

SEE PAGE 14

PRAIRIE MEADOW SUBD.

STATE OF IOWA (DNR)
19.48 AC
18.11 NET
1-3-05

BEN G. + PATRICIA A.
CURTIS
4-2-99

19

1478.65