


NE 1/4, NW 1/4 SEC. 35-80-3
SCALE: 1"=100'

SEC. 26

51

26
35

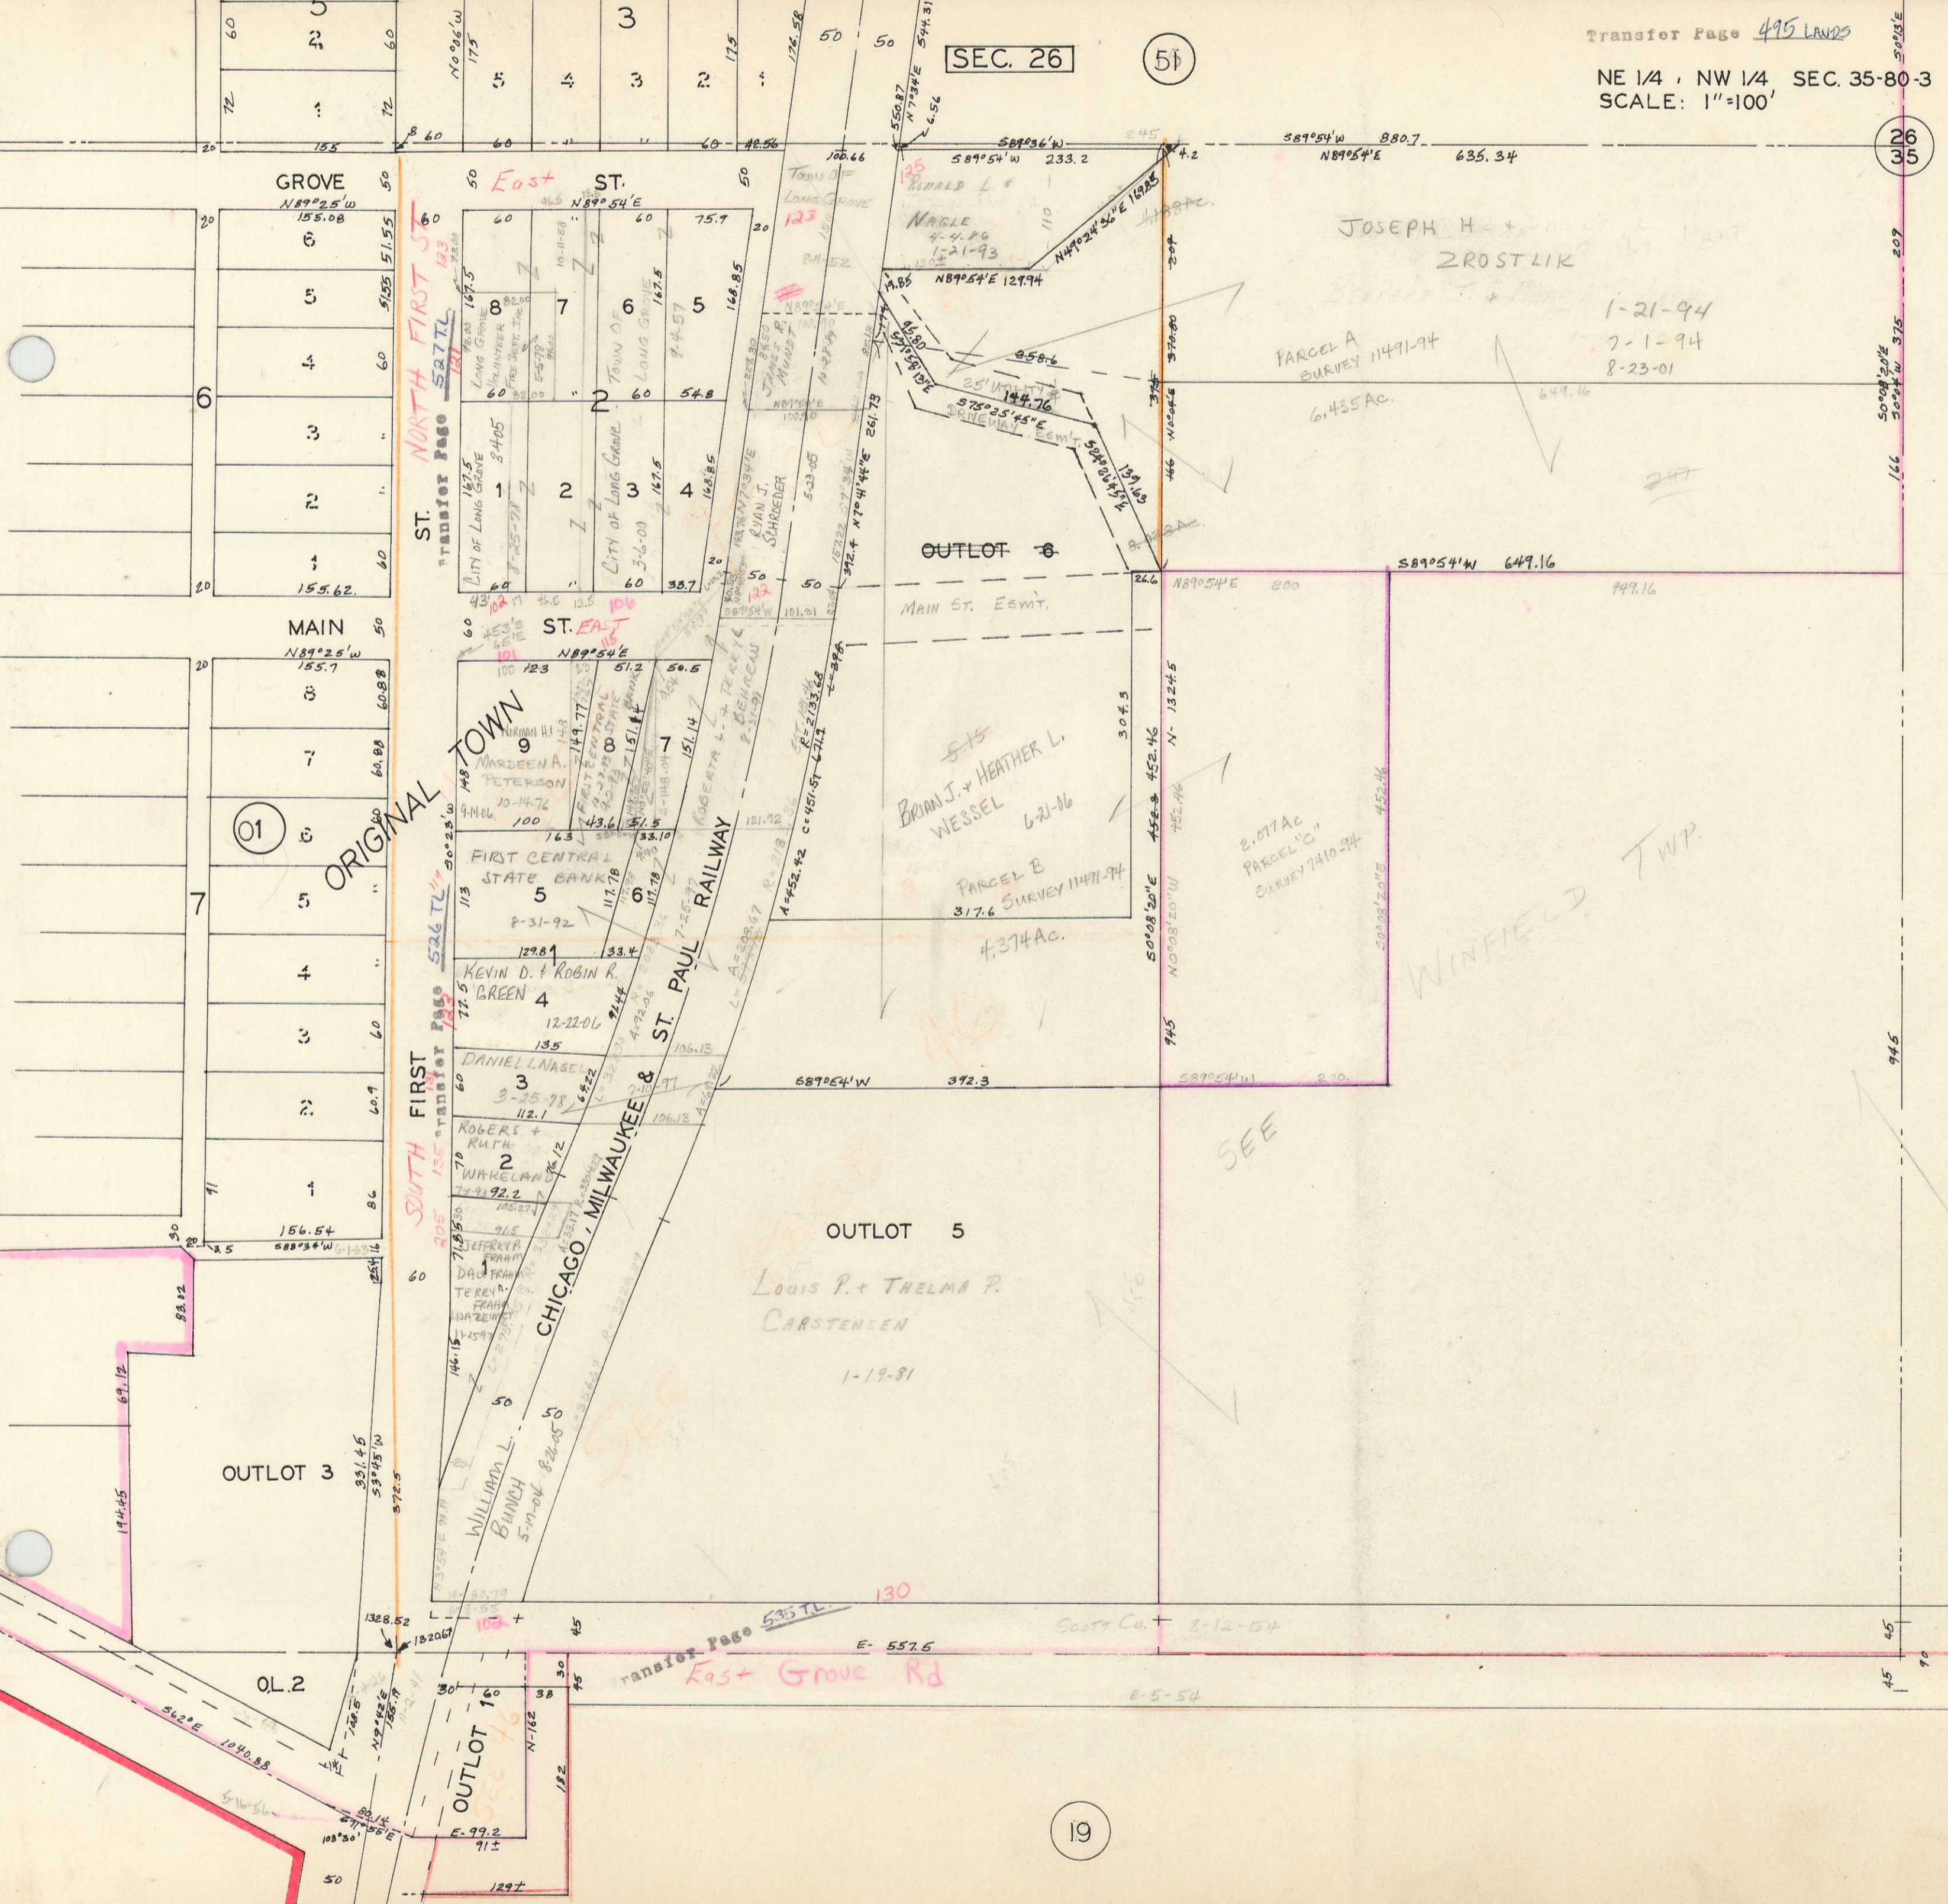

01

19

207
209
375
166
945
70