

NE 1/4, SE 1/4 SEC. 19-801  
SCALE: 1"=100'

SEE LIBERTY TOWNSHIP SECTION 19

1920

50 50

10TH AVE



765 PIKE ST

FIRE STATION

CITY OF NEW LIBERTY  
8-27-91

PARK

33

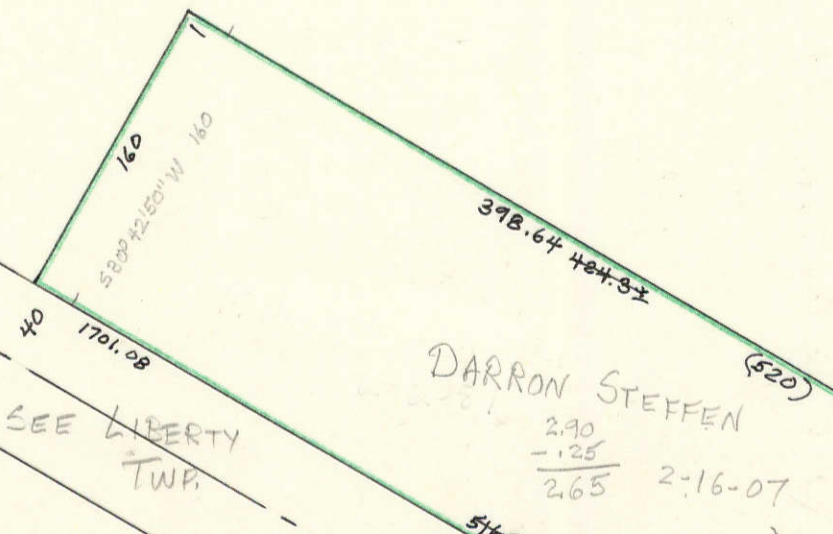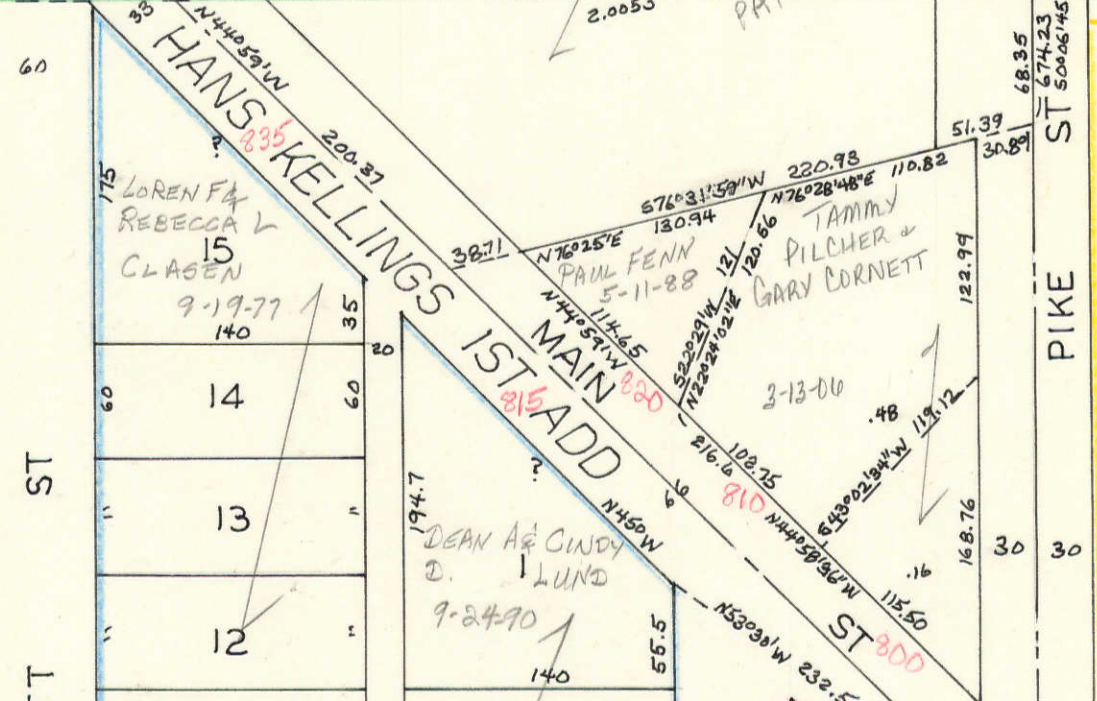


W-850.44

SEE LIBERTY TWP.

DARRON STEFFEN  
2.90  
-1.25  
2.65 2-16-07

SCOTT ST

RAILROAD

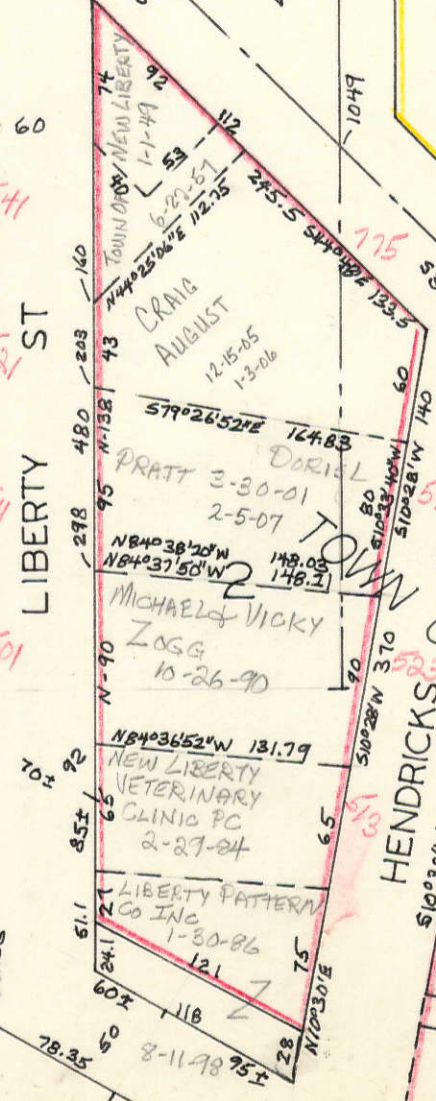

775

TOWN OF NEW LIBERTY  
HENDRICKS ST

SEE PAGE 55

SEE PAGE 55

55