



MINA RASCHE'S FIRST ADD.

SEC. 12-80-4

Transfer Page 105 LANDS

HUGHES

01

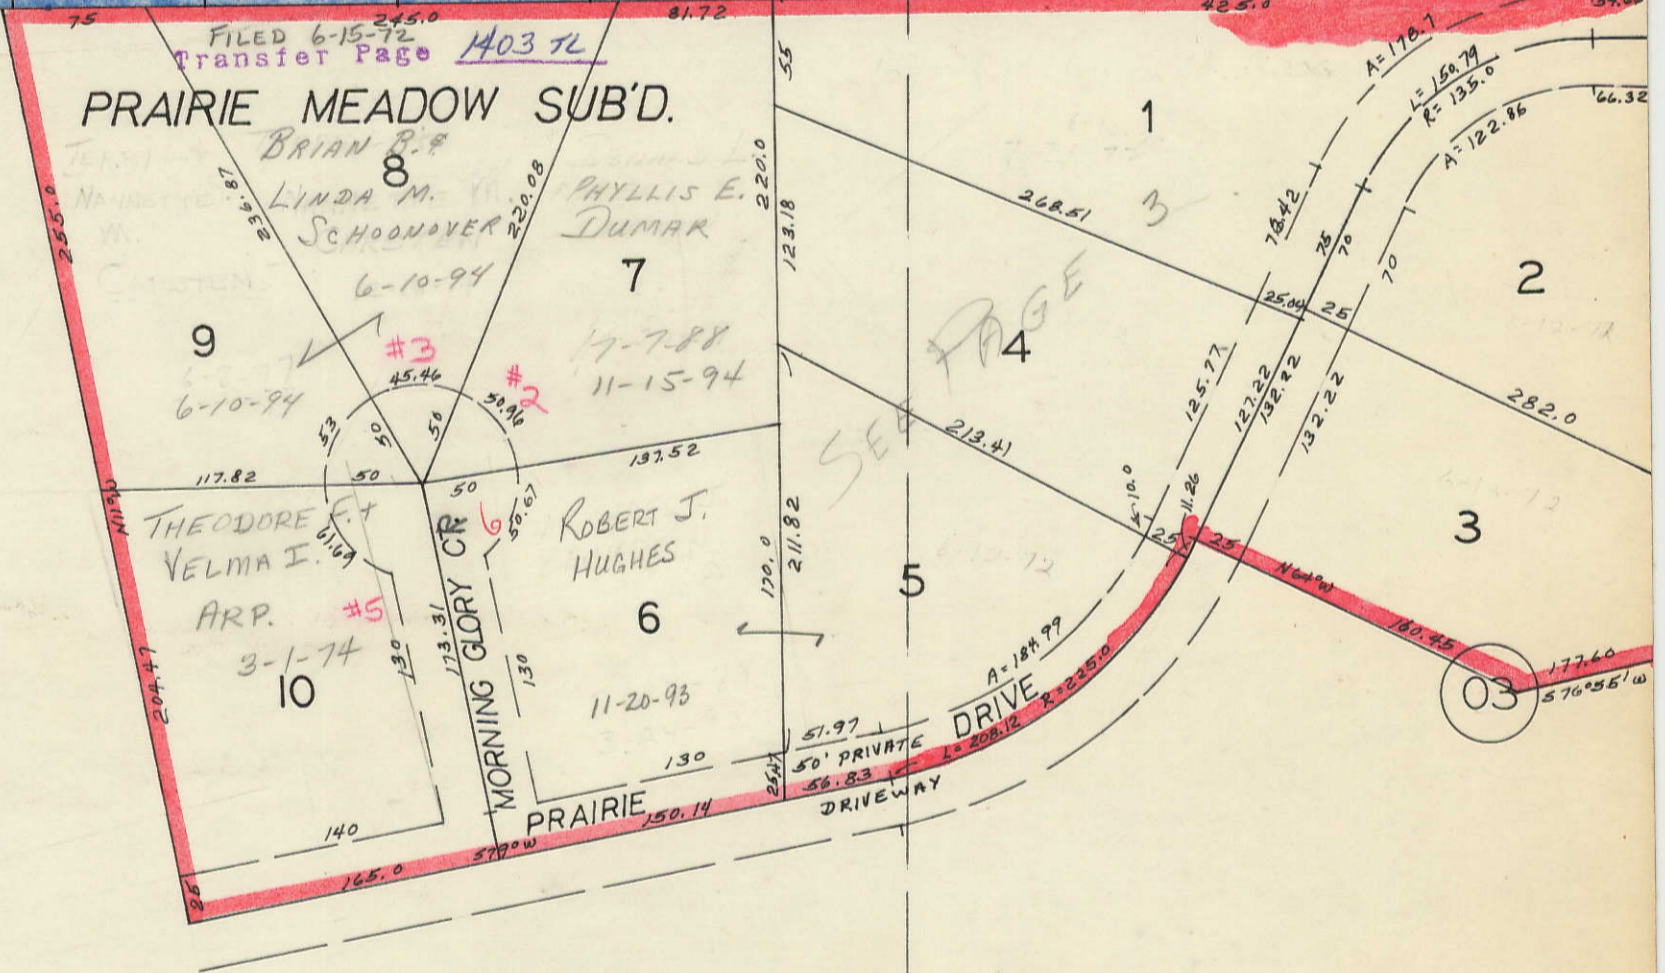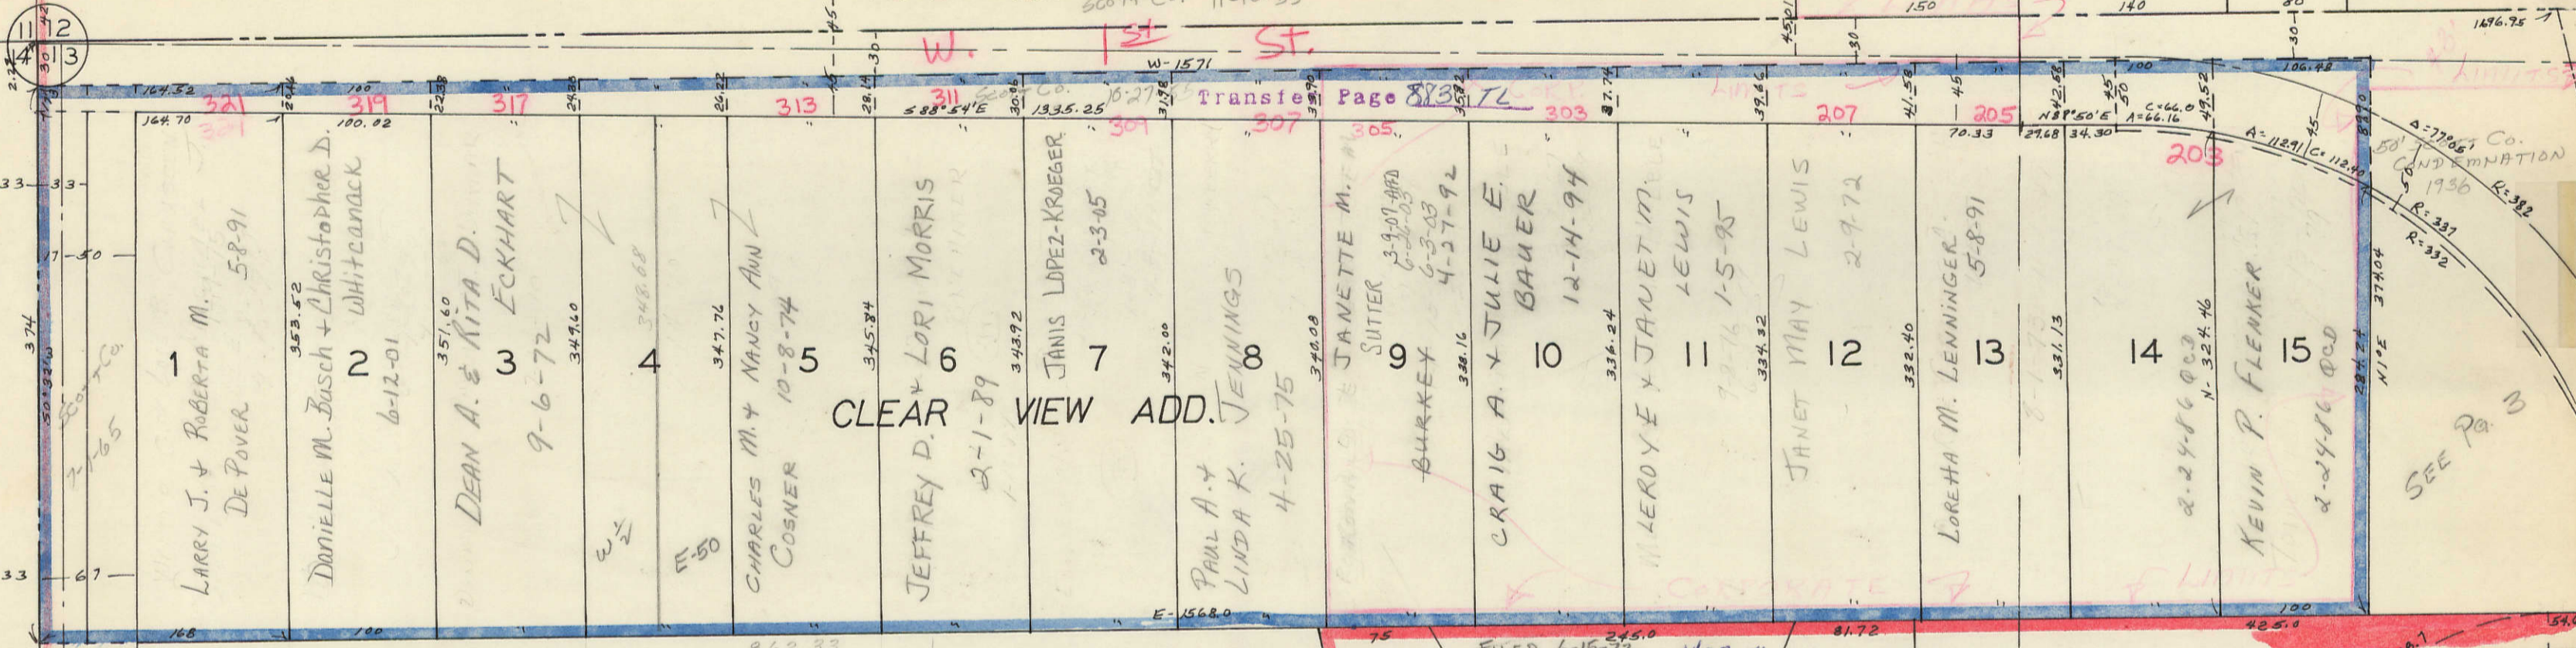

BEN G. + PATRICIA A. CURTIS

3-2-87
4-2-99

SEC. 14-80-4

Sec 13-80-4