


SE 1/4, NW 1/4 SEC. 15-79-2
SCALE: 1"=100'

33 03

TRACT "F"

CHESTER WAMPFLER
3-21-62

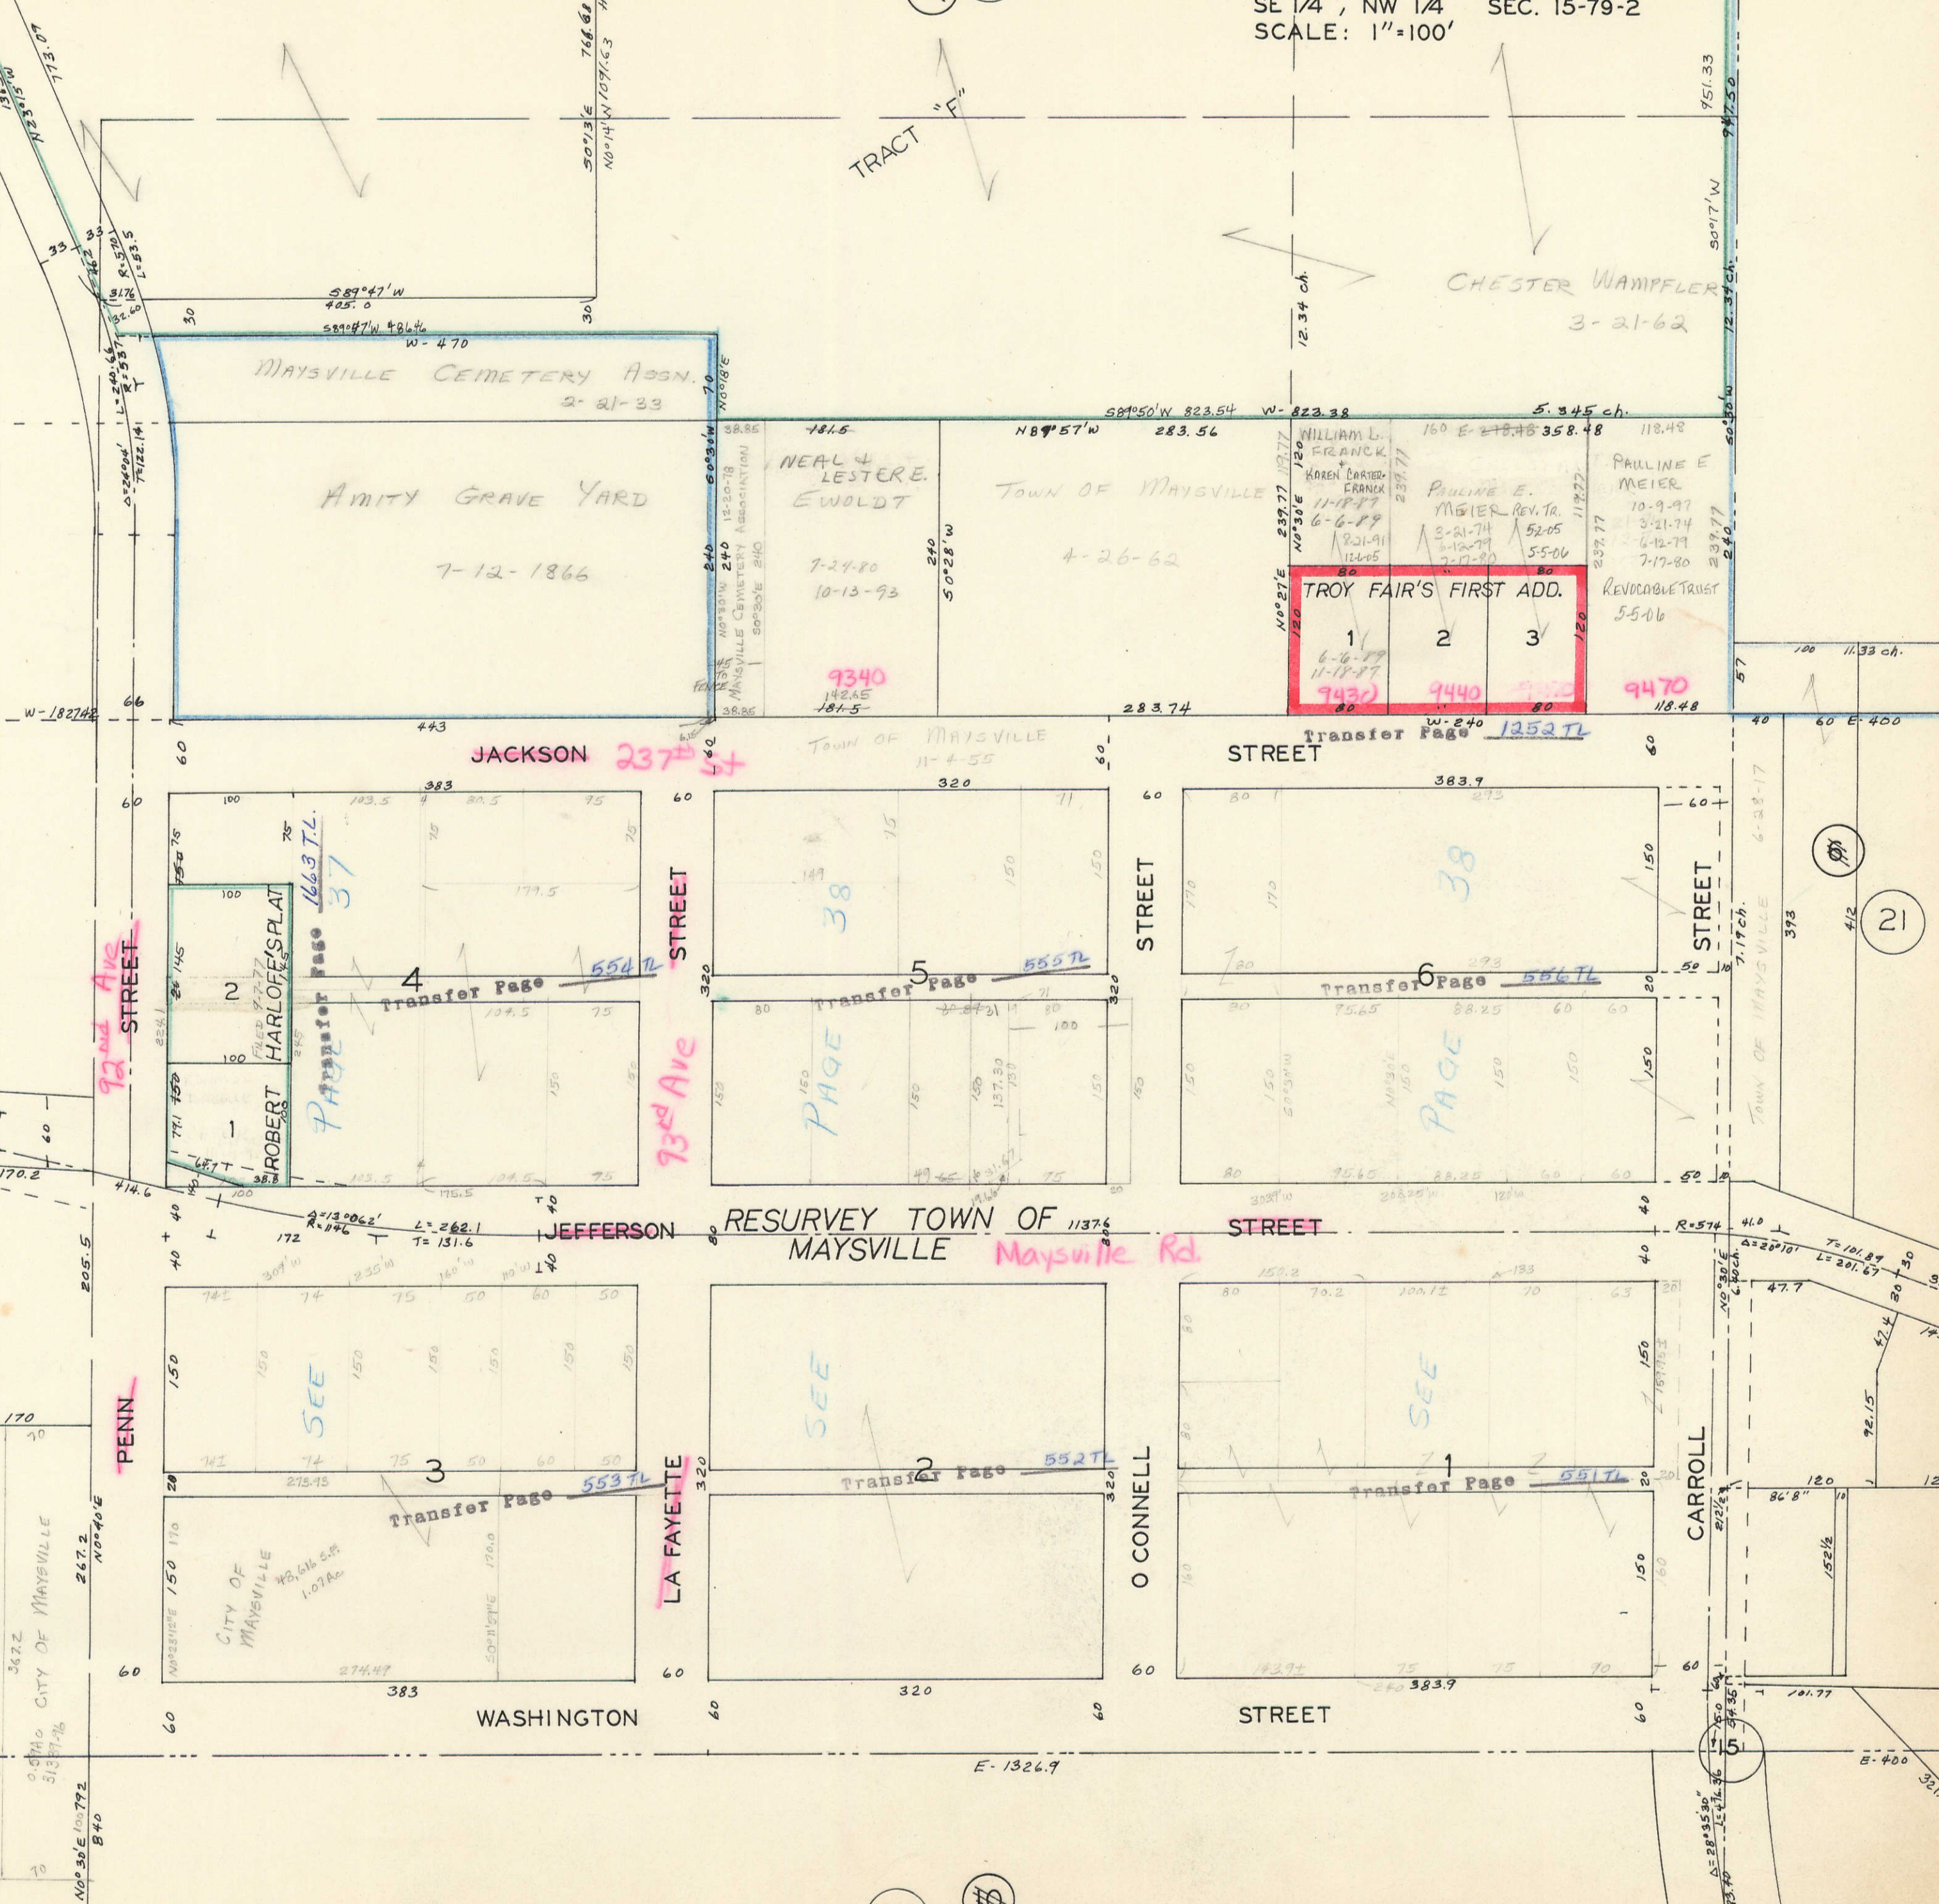

MAYSVILLE CEMETERY ASSN.
2-21-33

AMITY GRAVE YARD
7-12-1866

NEAL & LESTERE
EWOLDT
7-24-80
10-13-93

TOWN OF MAYSVILLE
4-26-62

WILLIAM L. FRANK
KAREN CARTEER FRANK
11-18-77
6-6-89
8-21-91
12-4-05

PAULINE E. MEIER REV. TR.
3-21-74
6-12-79
7-17-80
5-5-06

PAULINE E. MEIER
10-9-97
3-21-74
6-12-79
7-17-80

REVOCABLE TRUST
5-5-06

TROY FAIR'S FIRST ADD.
1
2
3

6-6-79
11-18-77
9430

9440

9470

ROBERT HARLOFF SPILAT
1
2

Transfer Page 554 TL

Transfer Page 555 TL

PAGE 38

Transfer Page 556 TL

PAGE 38

CITY OF MAYSVILLE
1.07 AC

Transfer Page 553 TL

SEE

Transfer Page 552 TL

SEE

Transfer Page 551 TL

SEE

17

21

35

5