

39

55

SE 1/4, SE 1/4 SEC. 19-80-1  
SCALE: 1"=100'


SEE PAGE 39

SEE LIBERTY TWP.

SEE PAGE 39

NEW LIBERTY LIVESTOCK  
AUCTION INC.  
10-9-84  
SURVEY 06-31138

SEE LIBERTY TOWNSHIP  
SECTION 19

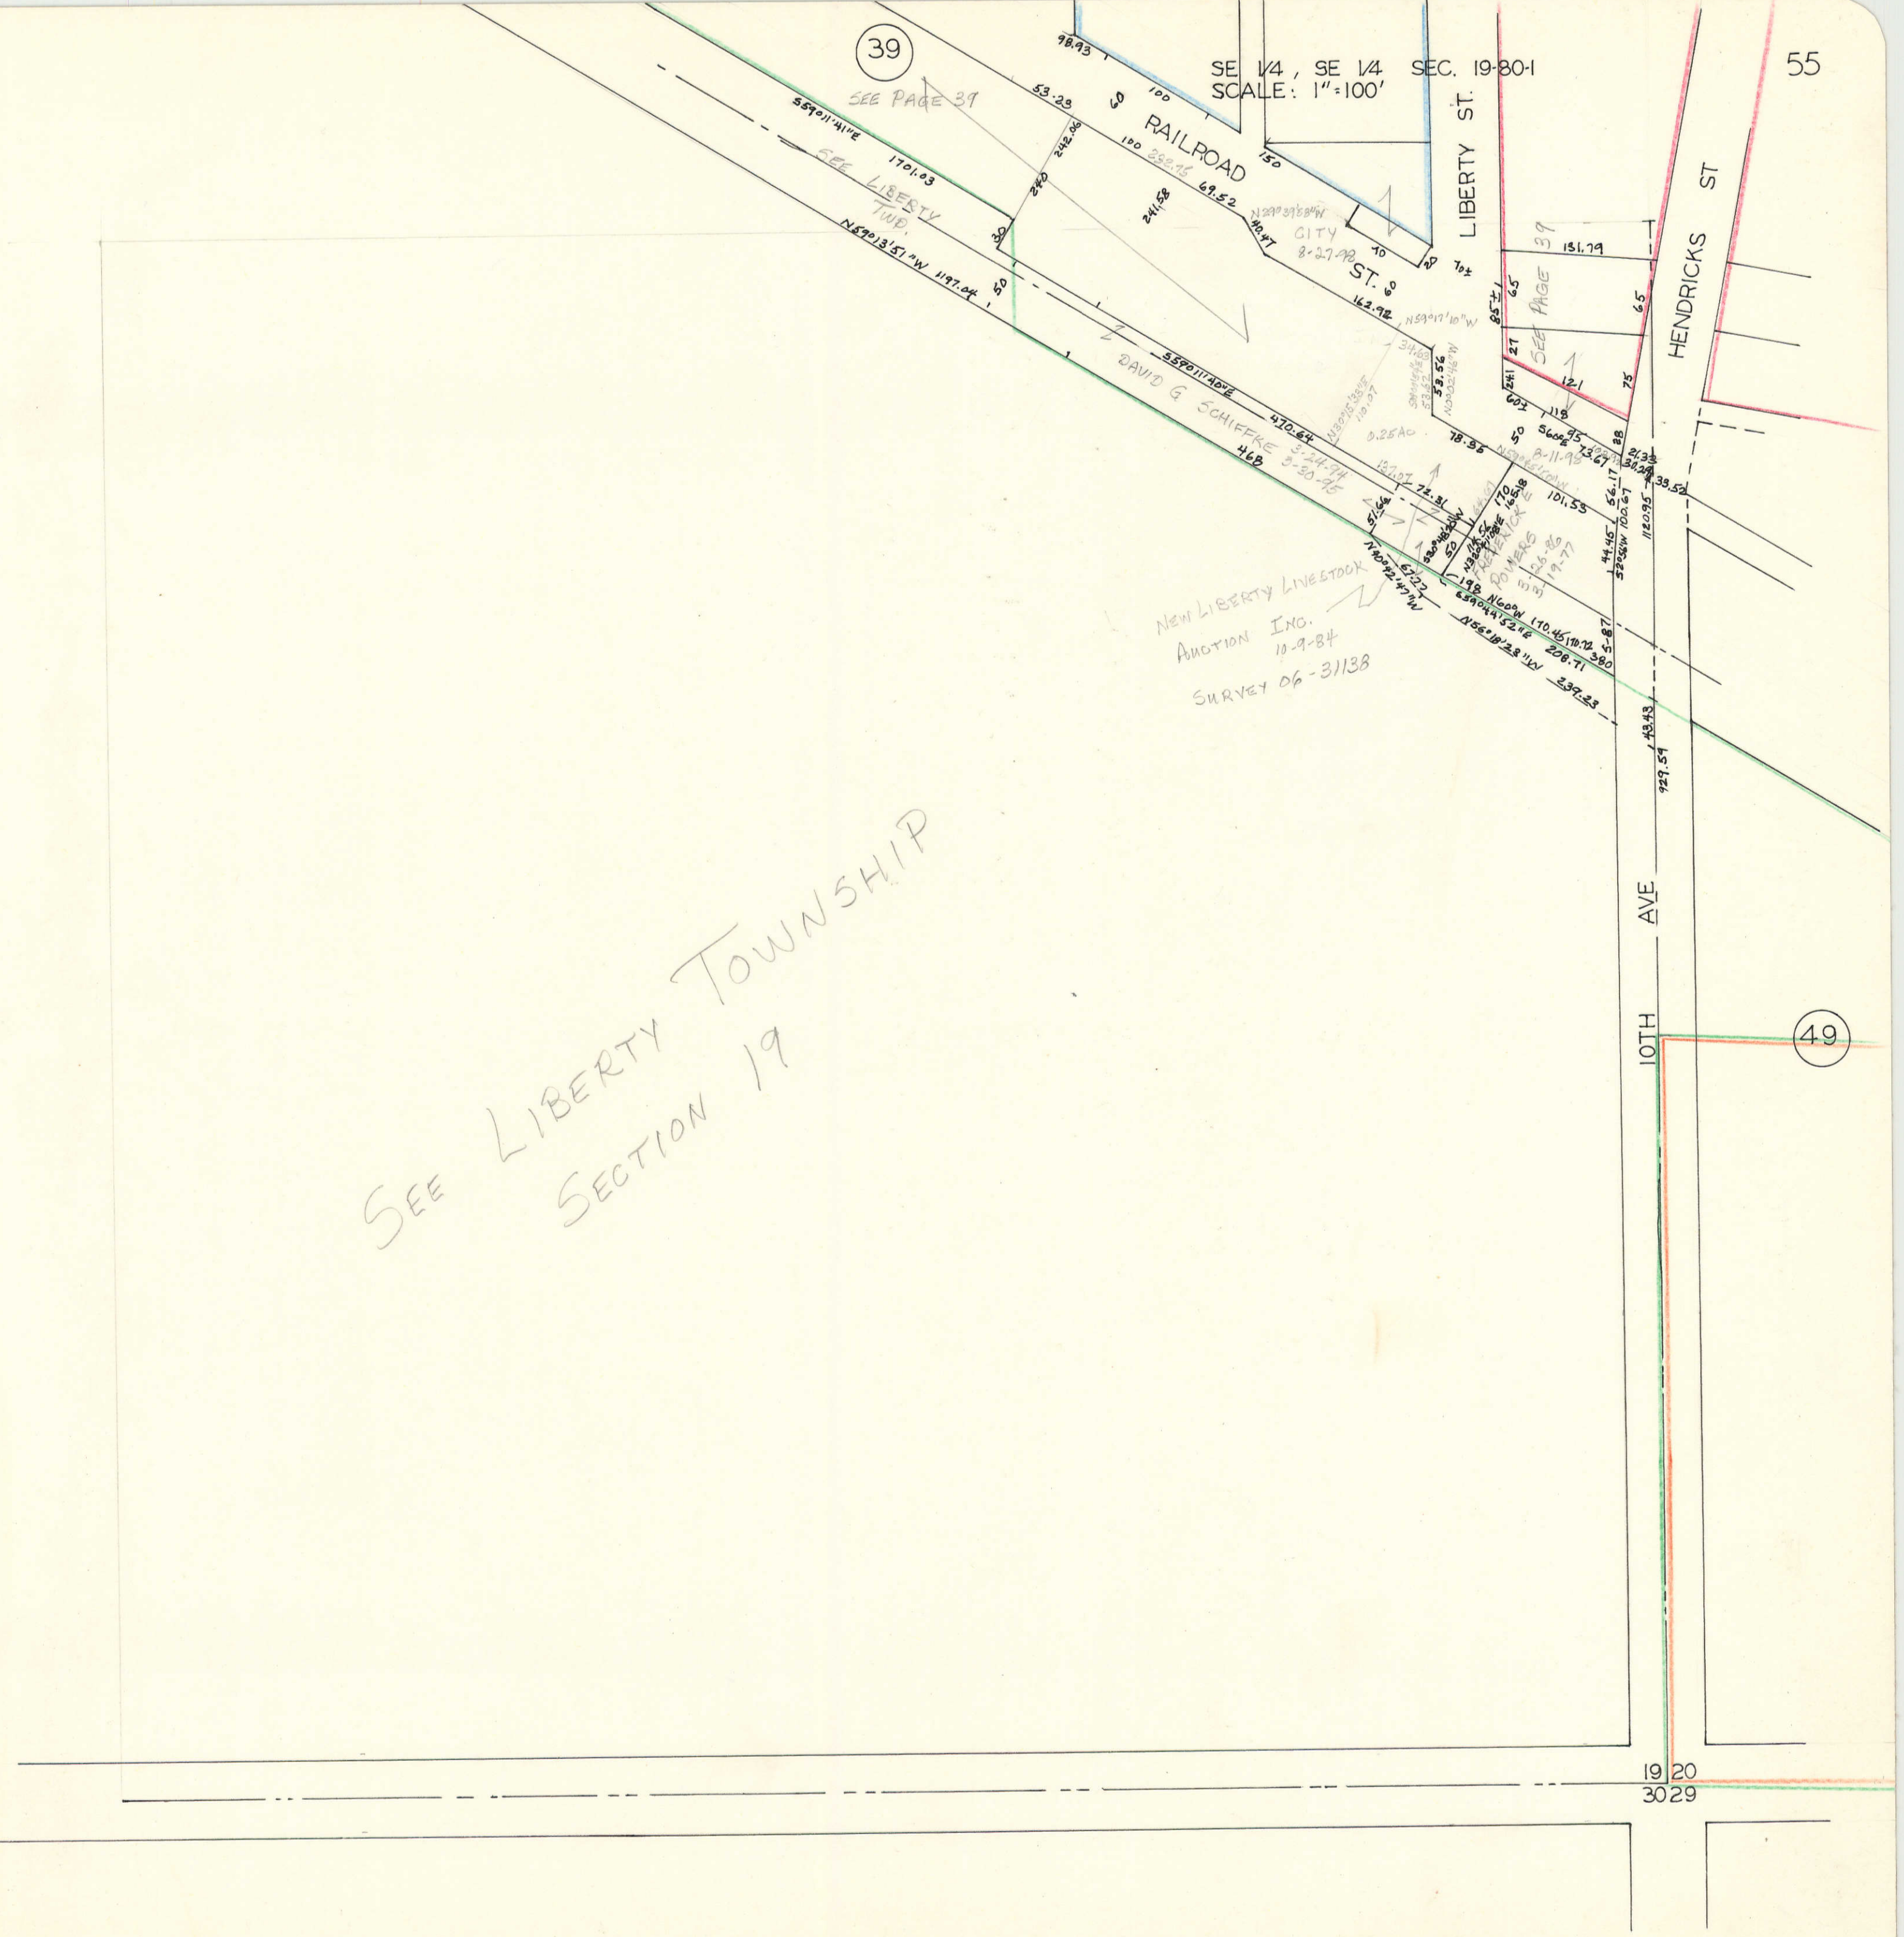

19 20  
30 29

49