


Transfer Page 374 LANDS

NW 1/4, SE 1/4 SEC. 18-78-5  
SCALE: 1"=100'

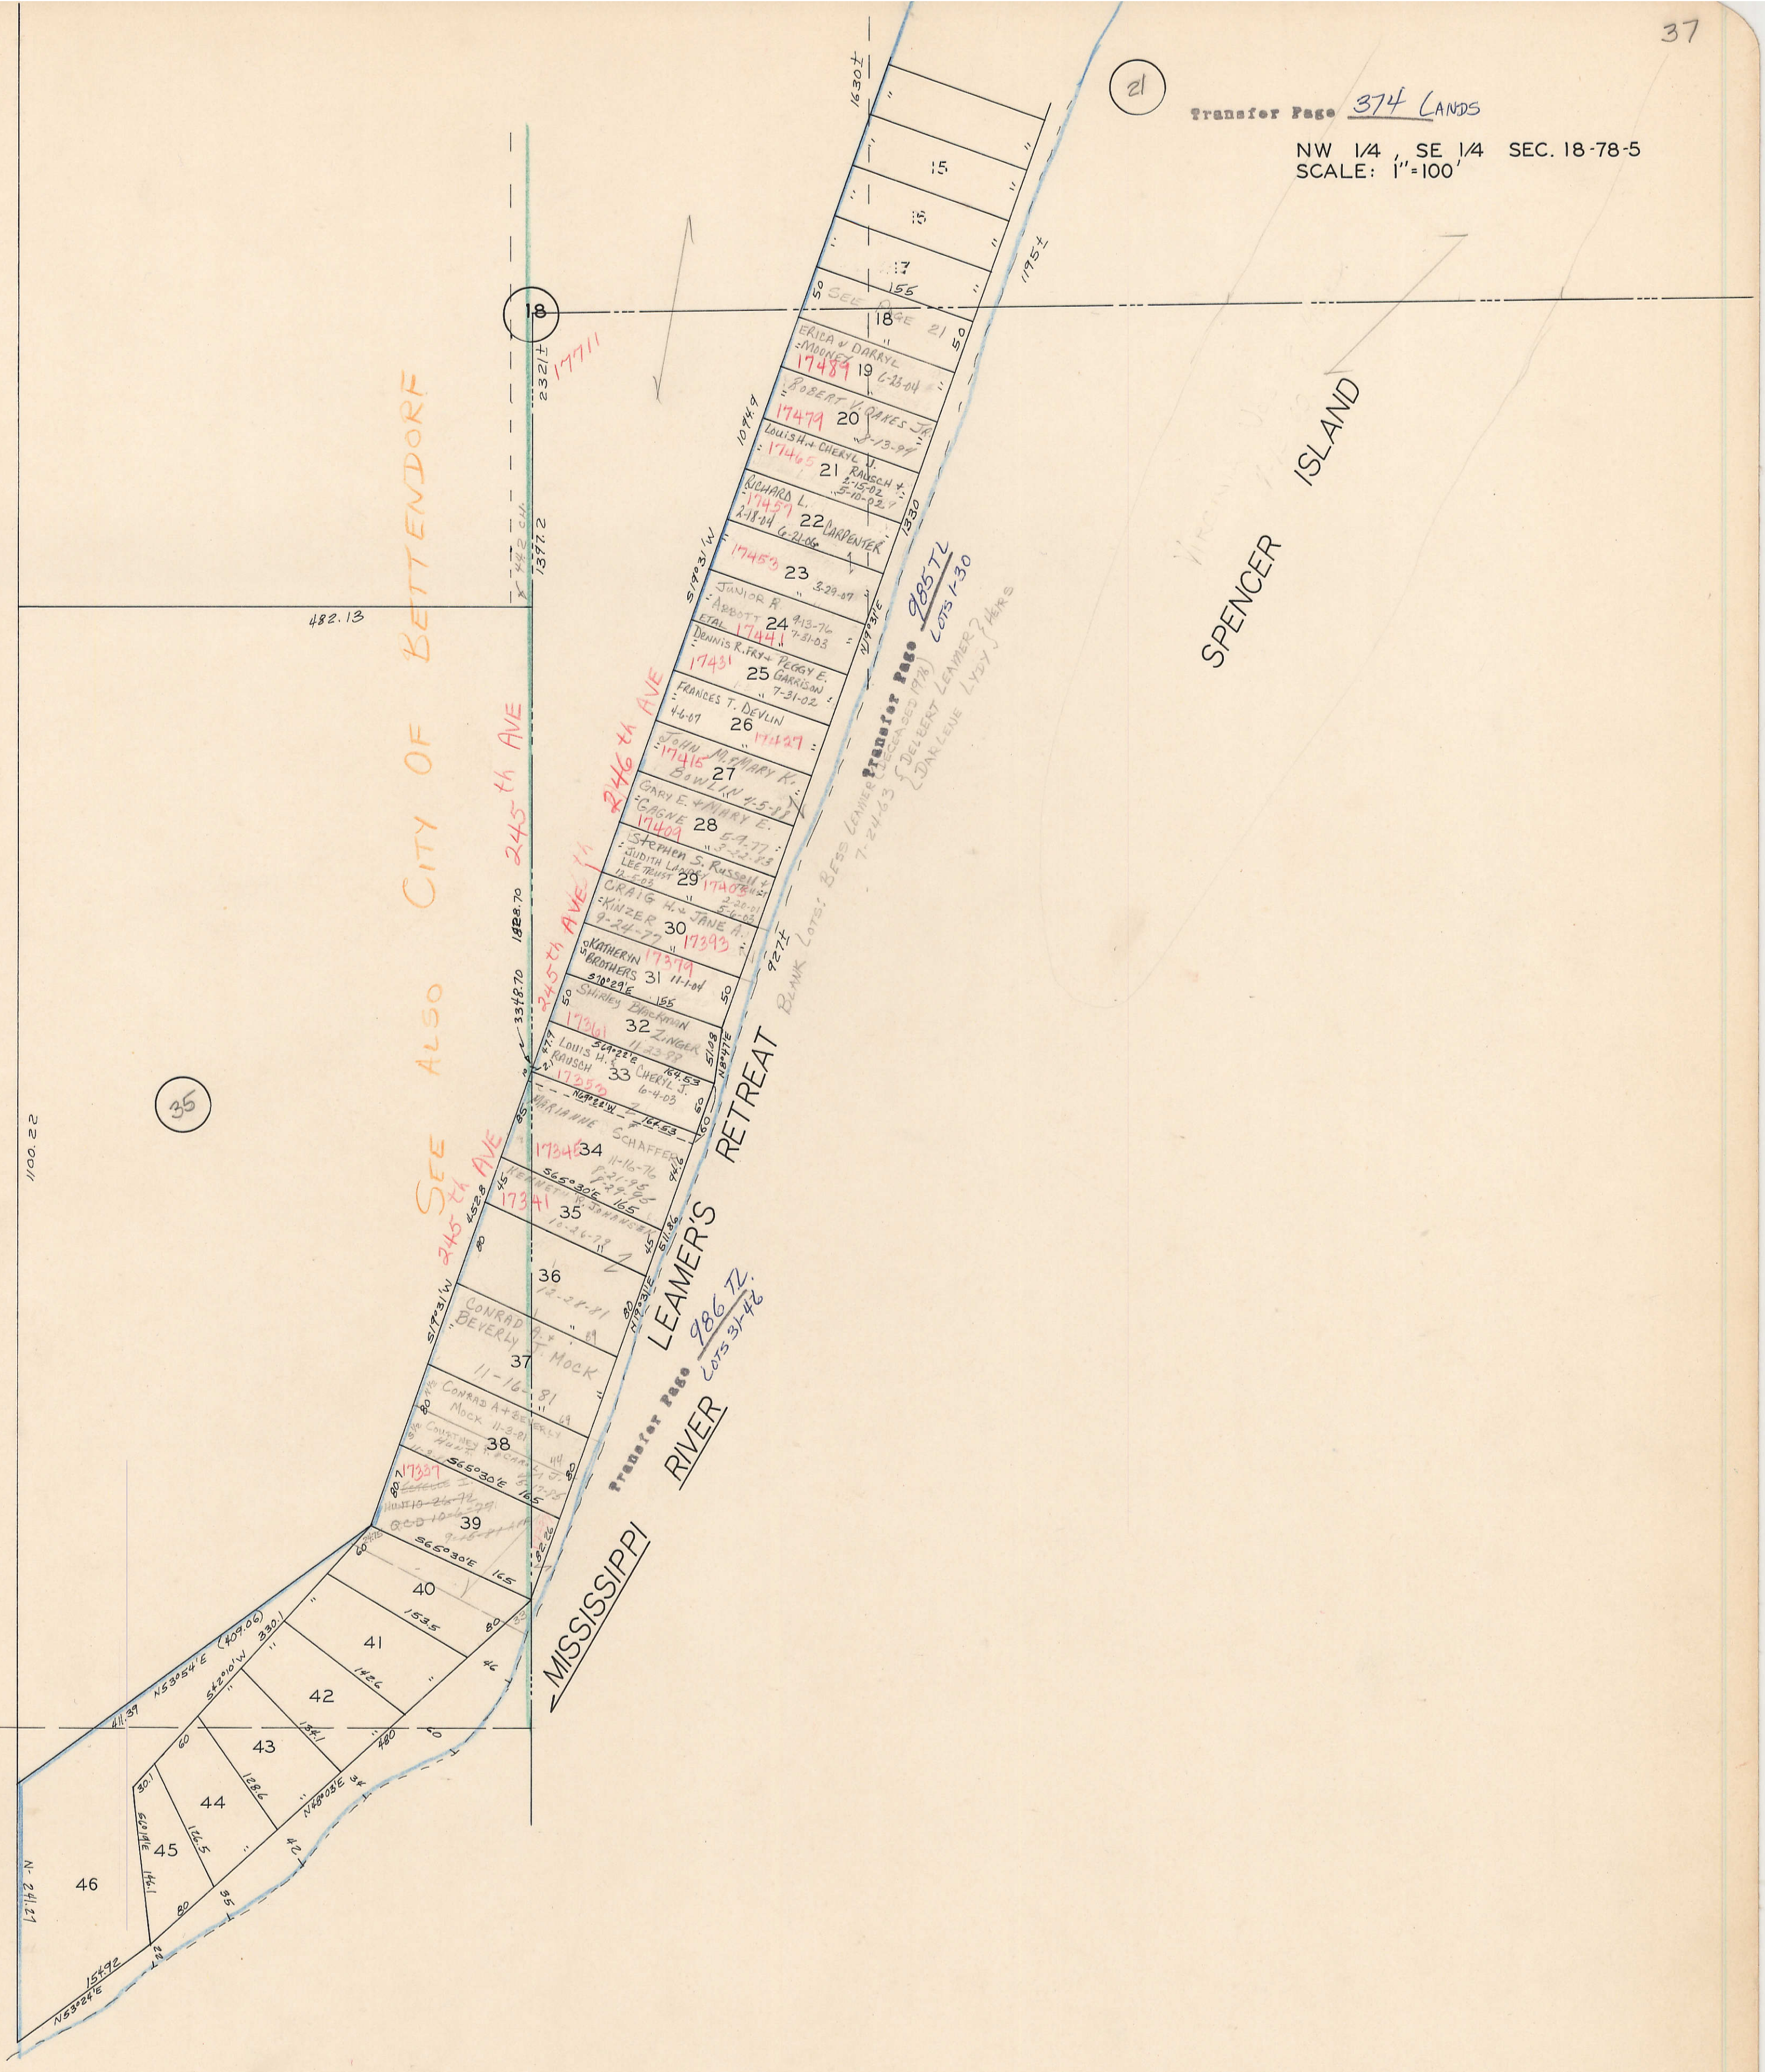

35

21

8