

SECTION 8


TOWNSHIP 78 NORTH, RANGE 5 EAST,

5TH PRINCIPAL MERIDIAN

PLEASANT VALLEY TWP.

SCOTT COUNTY, IOWA

TRANSFER PAGE 373

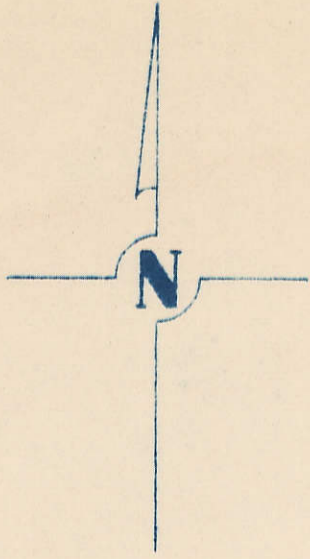


SCALE: 1" = 200'

SECTION 5

PAGE 10

01 03
17 19

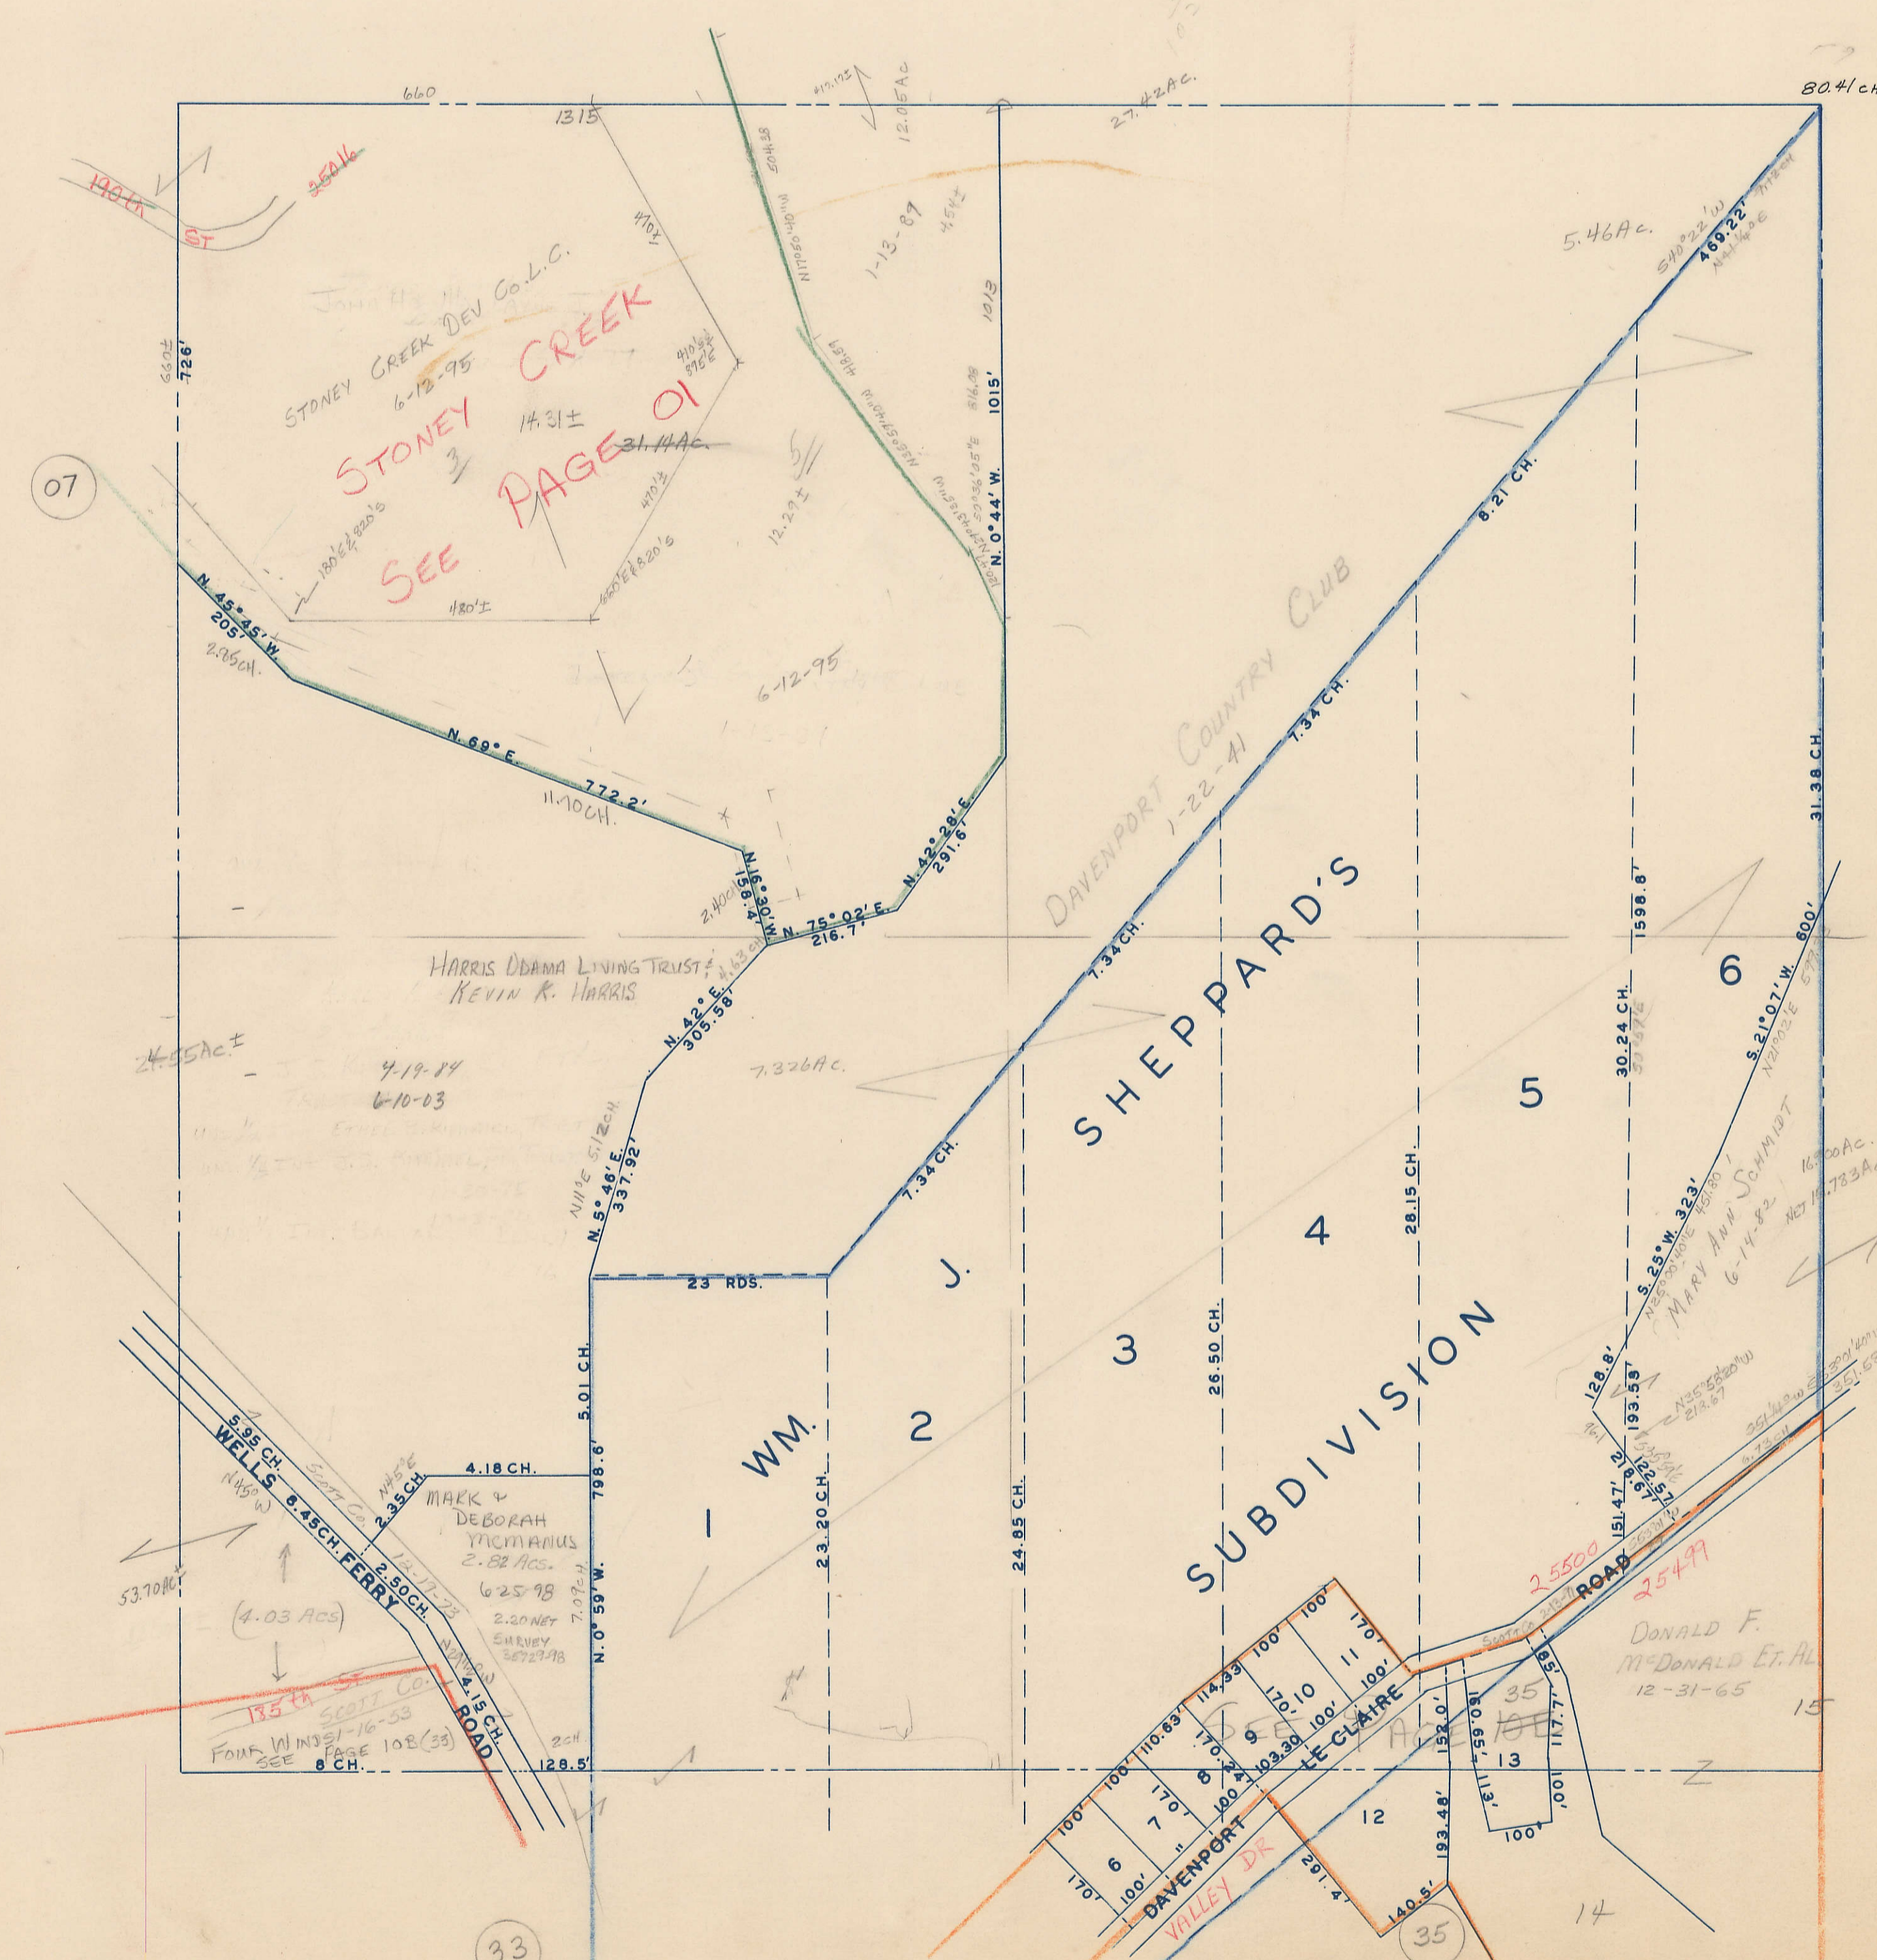

SEC. 8

SECTION 7 PAGE 9

SECTION 8 PAGE LE CLAIRE TWP.

DAVENPORT COUNTRY CLUB LIQUIDATION TRUST

SECTION 10 8

PAGE 10-B