



SECTION 12
TOWNSHIP 78 NORTH, RANGE 4 EAST,
5TH PRINCIPAL MERIDIAN
~~PLEASANT VALLEY TOWNSHIP~~
CITY OF BETTENDORF
SCOTT COUNTY, IOWA

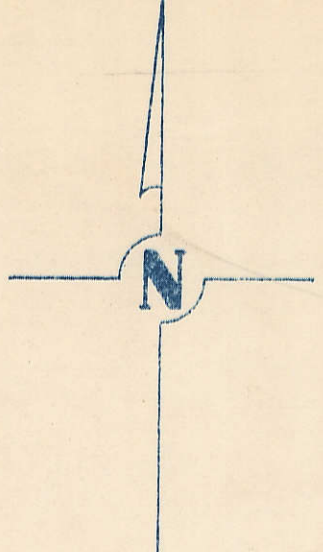

SCALE: 1 INCH = 330 FEET

TRANSFER PAGE 357

SECTION 1 PAGE 3

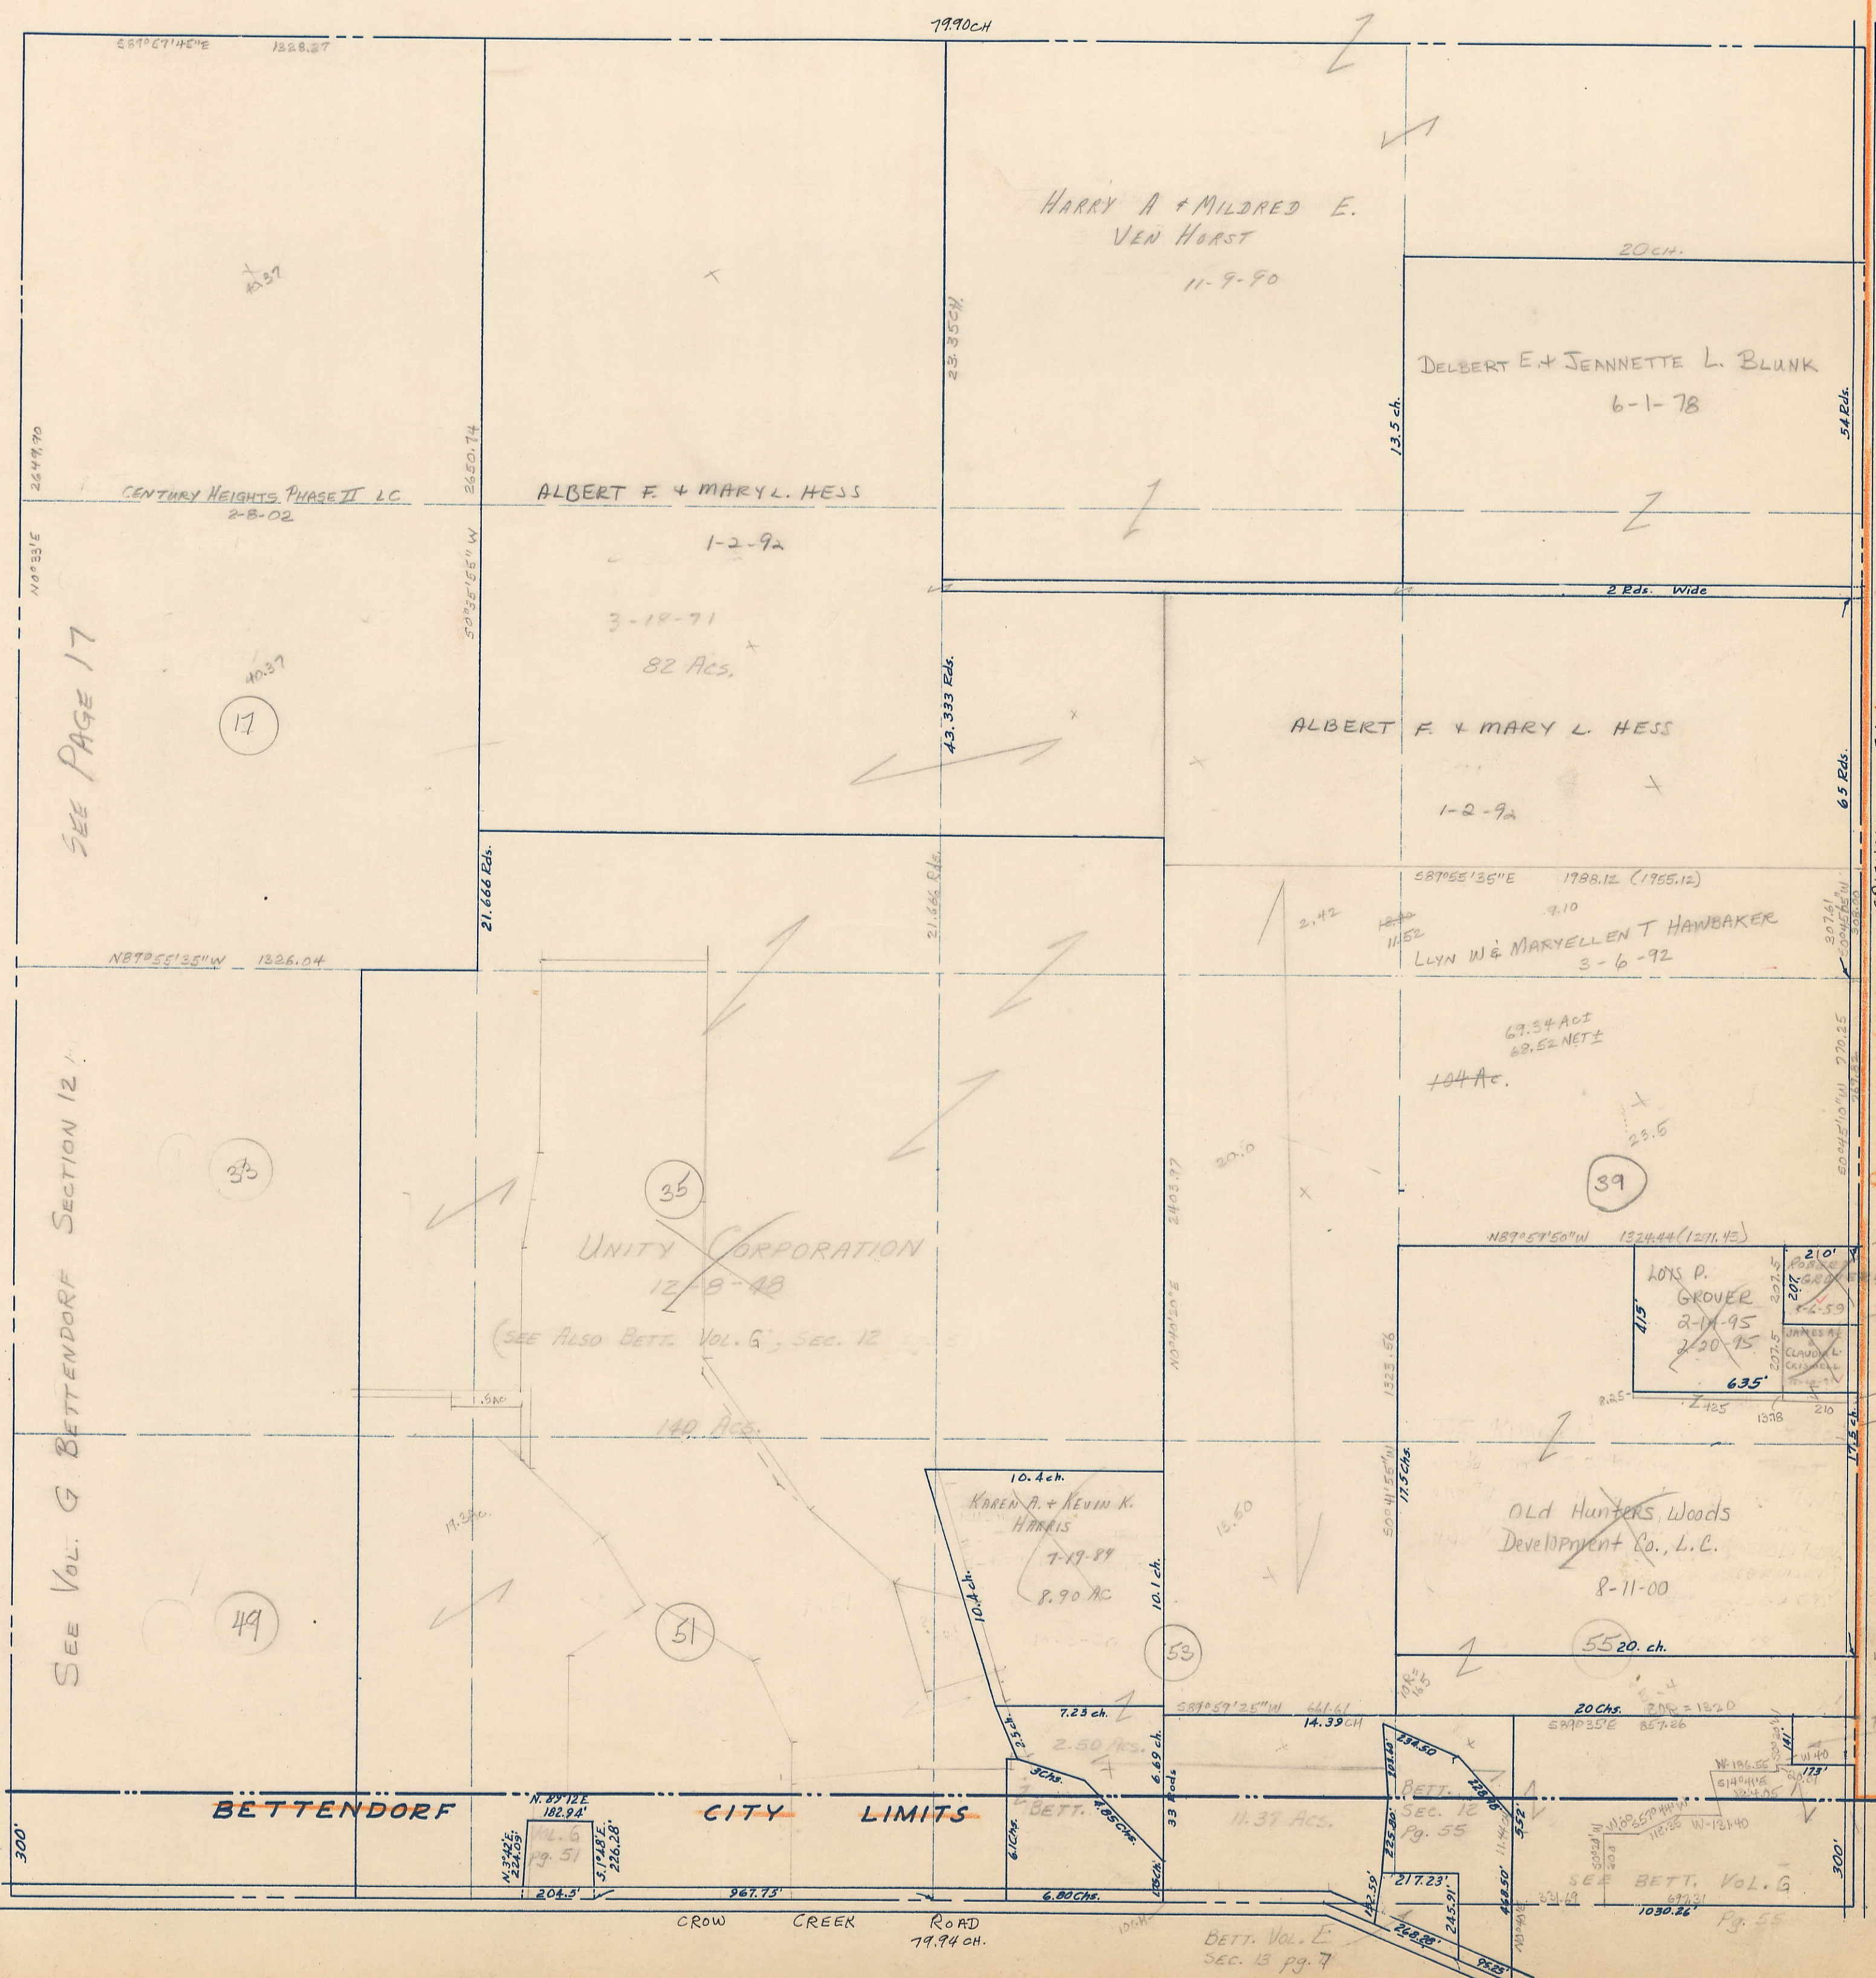

SEE PAGE 17

SEE VOL. G BETTENDORF SECTION 12

LIMITS

5560
ST. CORP.
CRISWELL

BETTENDORF
SECTION 7

5060
5-23-66
3-11-68

5010
16.5
124.25

107.50 ch. N.
5709.5

19-10-64

SEE BETT. VOL. G
Pg. 55

BETT. VOL. E
SEC. 13 pg. 7

12

PAGE 9

SECTION 7

PAGE 7

SECTION 12