


SECTION 3  
TOWNSHIP 79 NORTH, RANGE 5 EAST,  
5<sup>TH</sup> PRINCIPAL MERIDIAN  
PRINCETON TOWNSHIP  
SCOTT COUNTY, IOWA

TRANSFER PAGE 379

SCALE: 1 INCH = 330 FEET

SECTION 34

PAGE 36

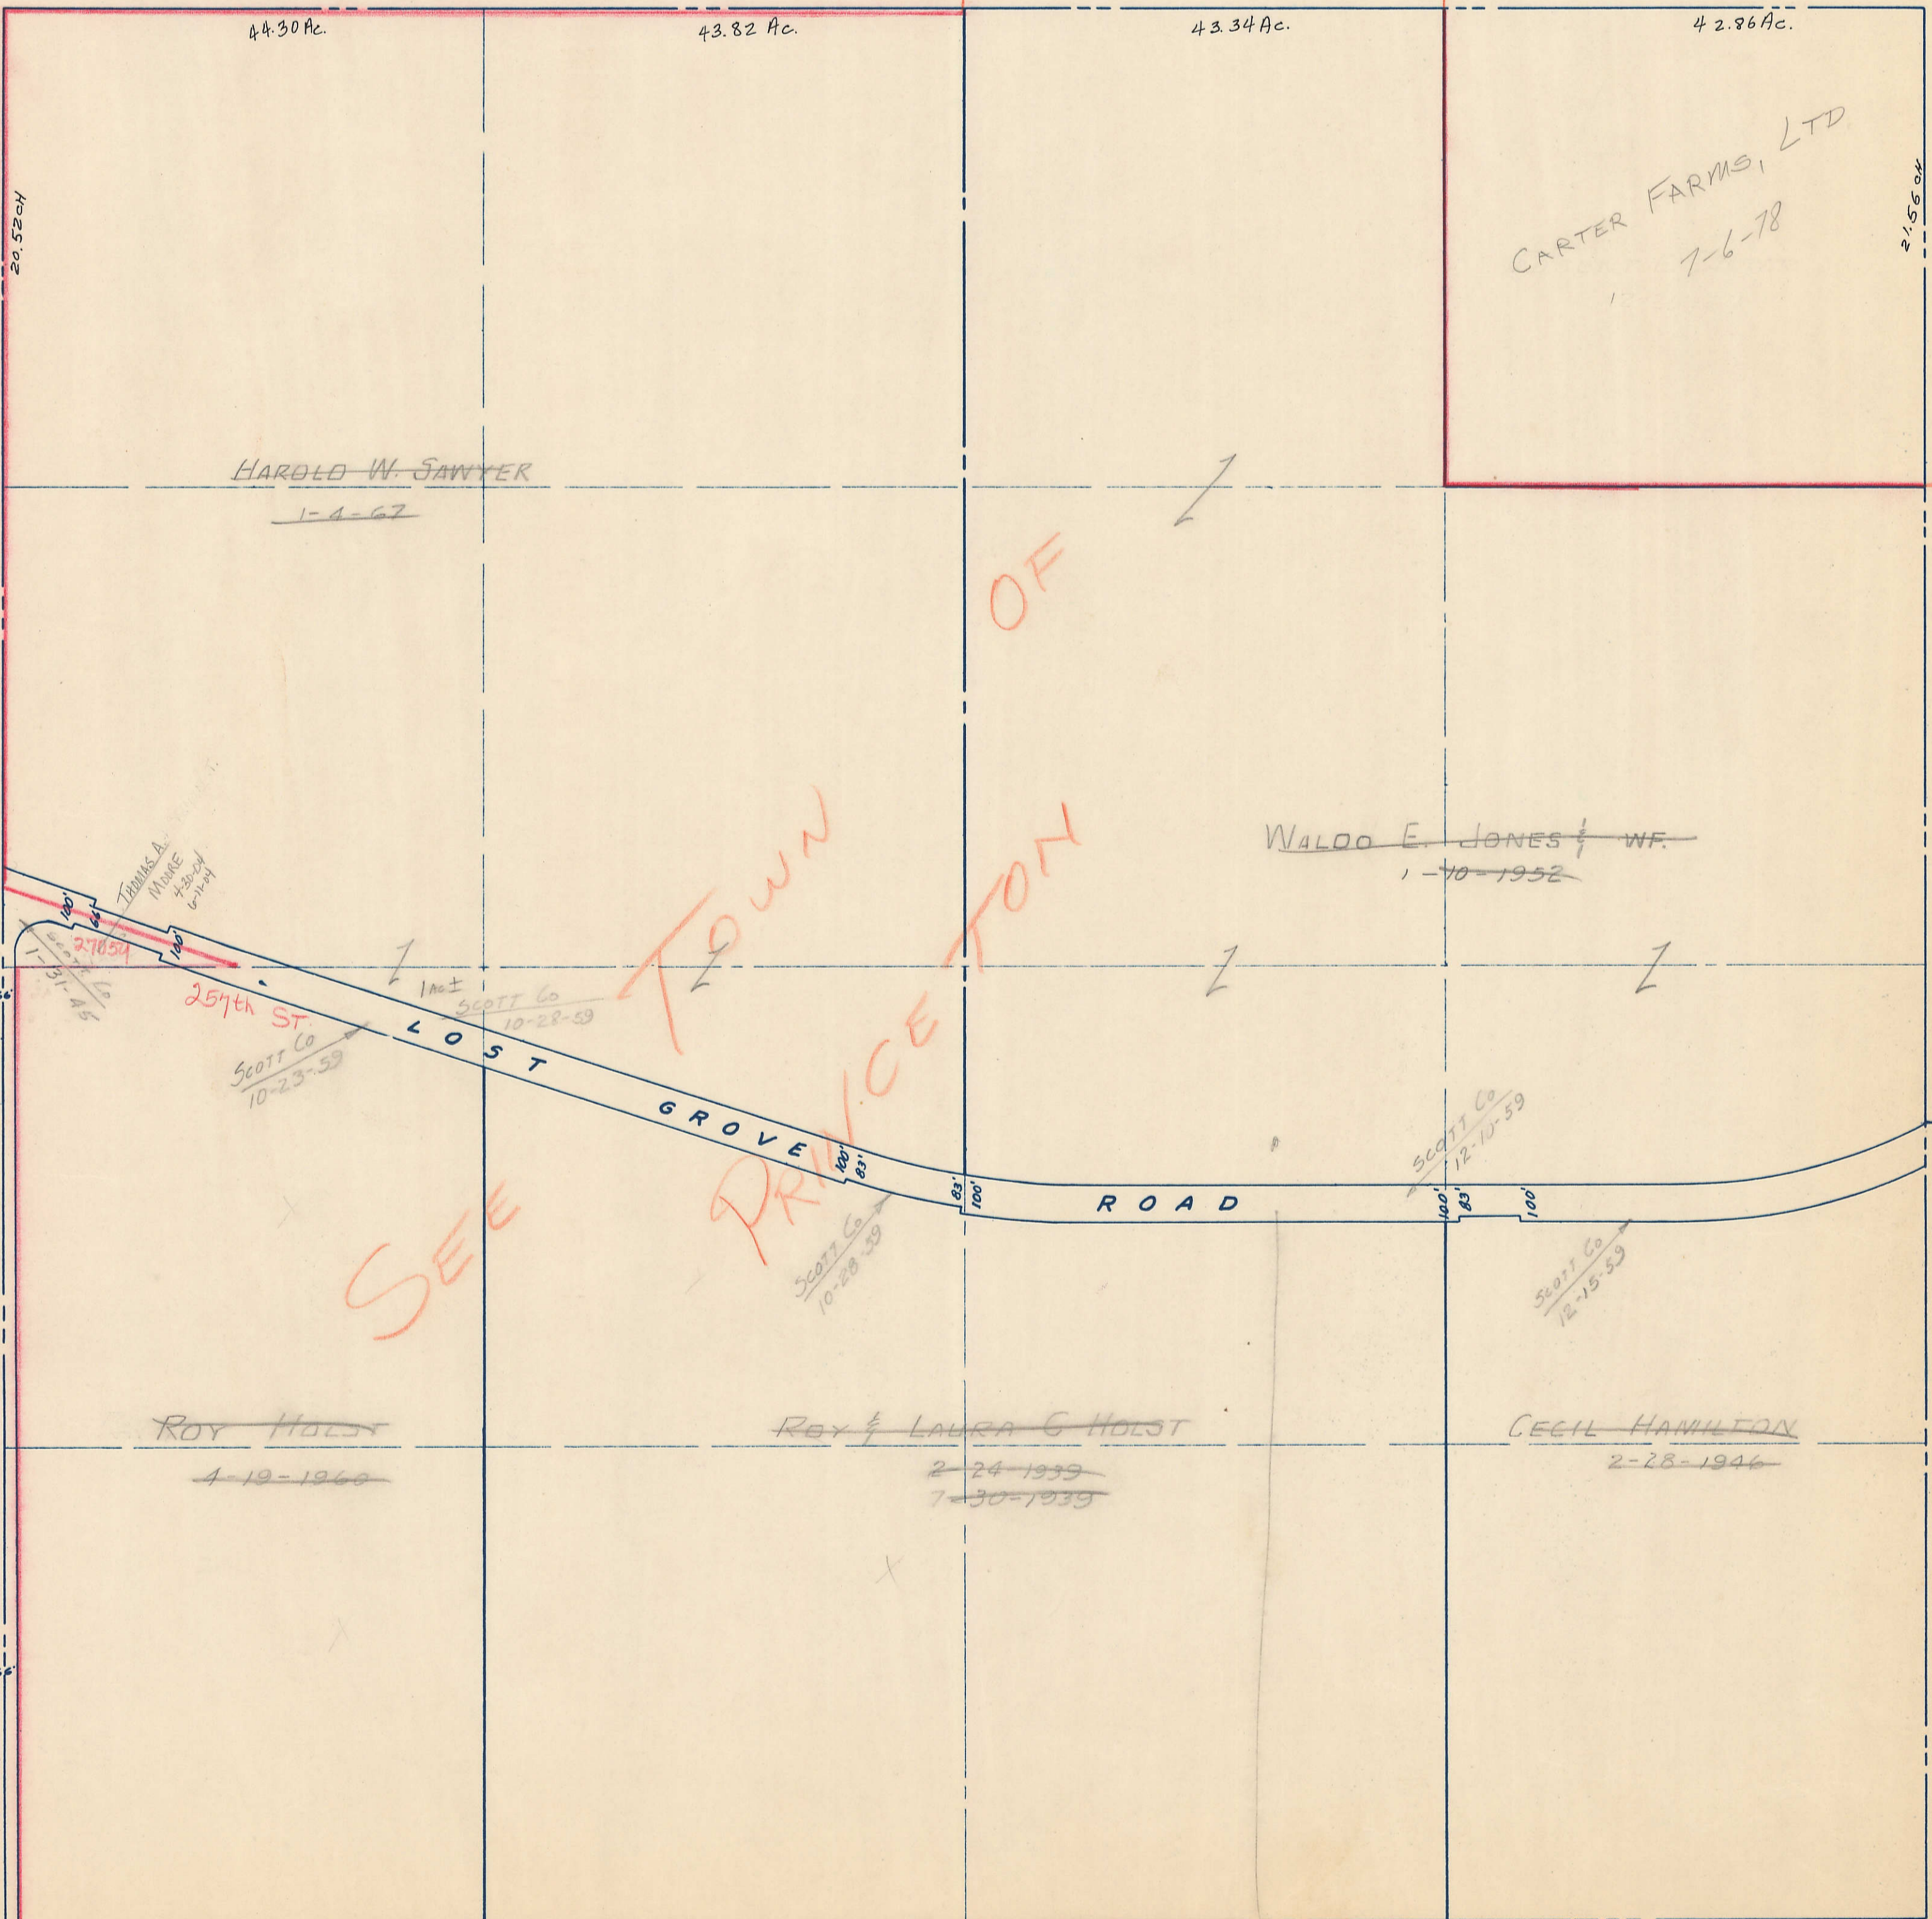

PAGE 6

SECTION 4

PAGE 4

SECTION 2

79.86CH

SECTION 10

PAGE 12