

62 SEC 23


61 SEC. 23

TOWN OF RIVERDALE

SCALE: 1" = 100'

MARY FRANCES WELCH LIFE ESTATE
ALBERT J. WELCH L.F. TENANT

9-8-60
8-15-77

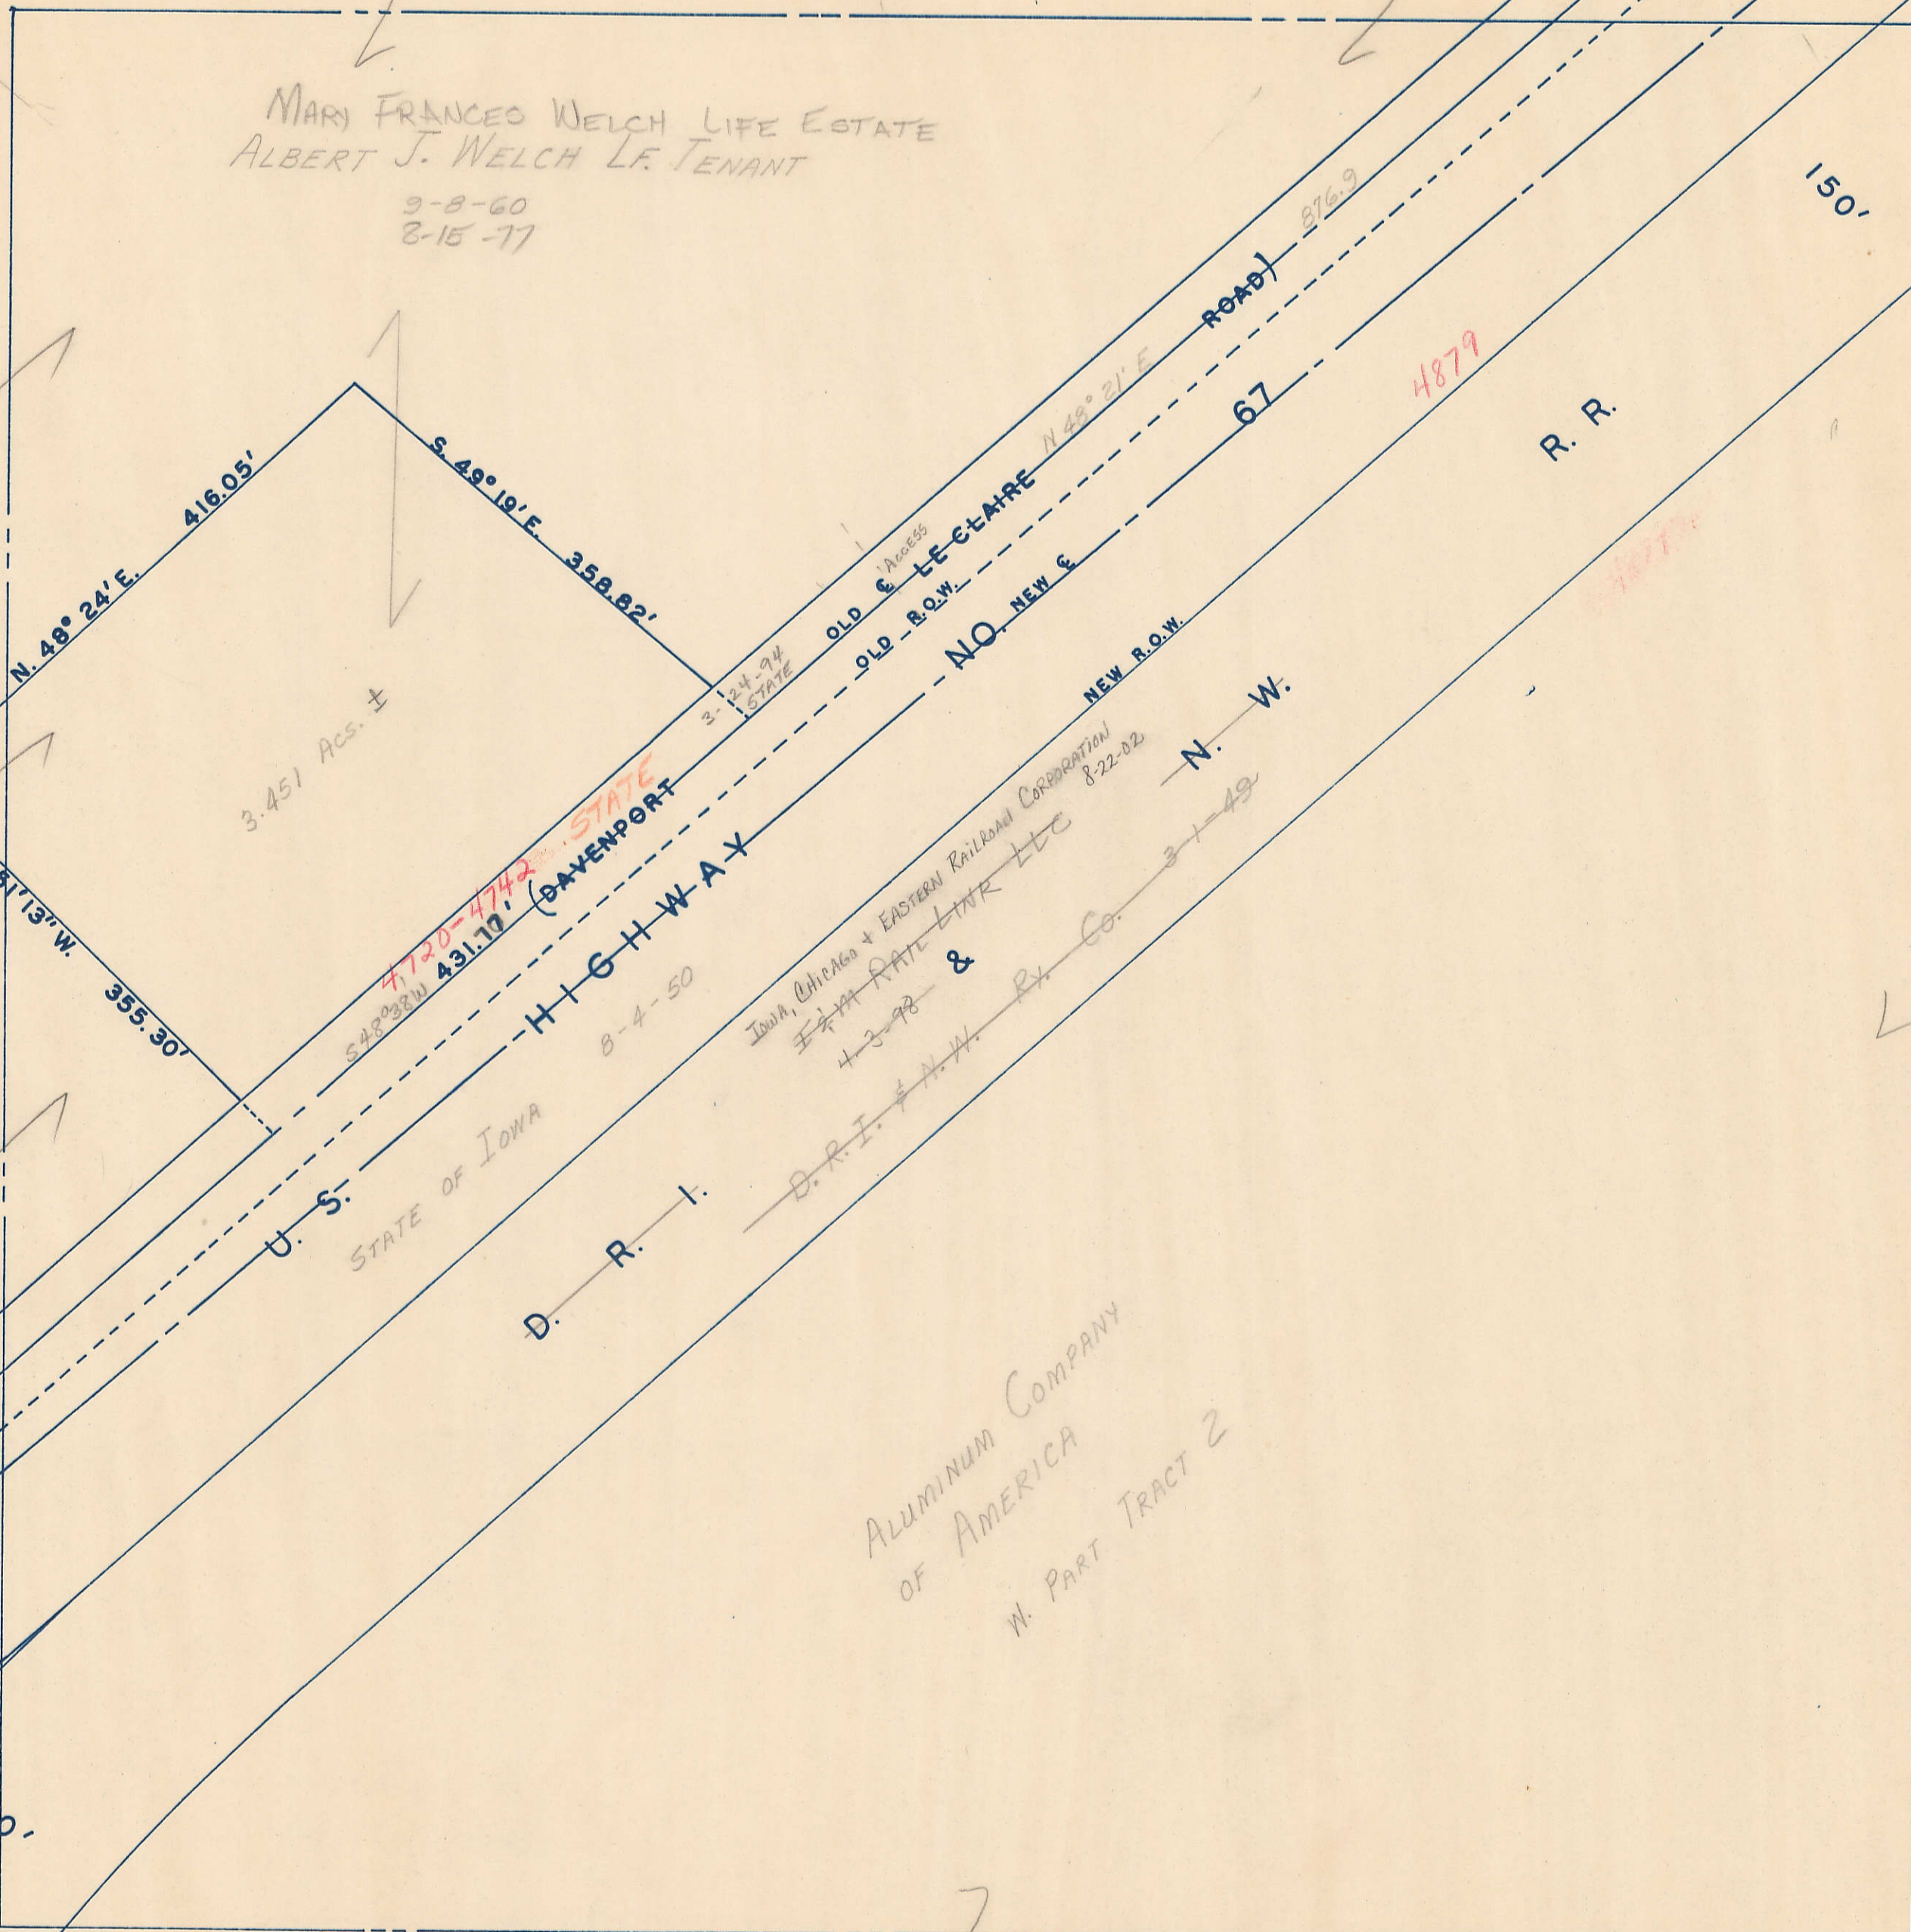

ALUMINUM Co.
OF AMERICA
3-7-67

ALUMINUM COMPANY
OF AMERICA
W. PART TRACT 2