


Sec 27-78-4

CITY OF BETTENDORF

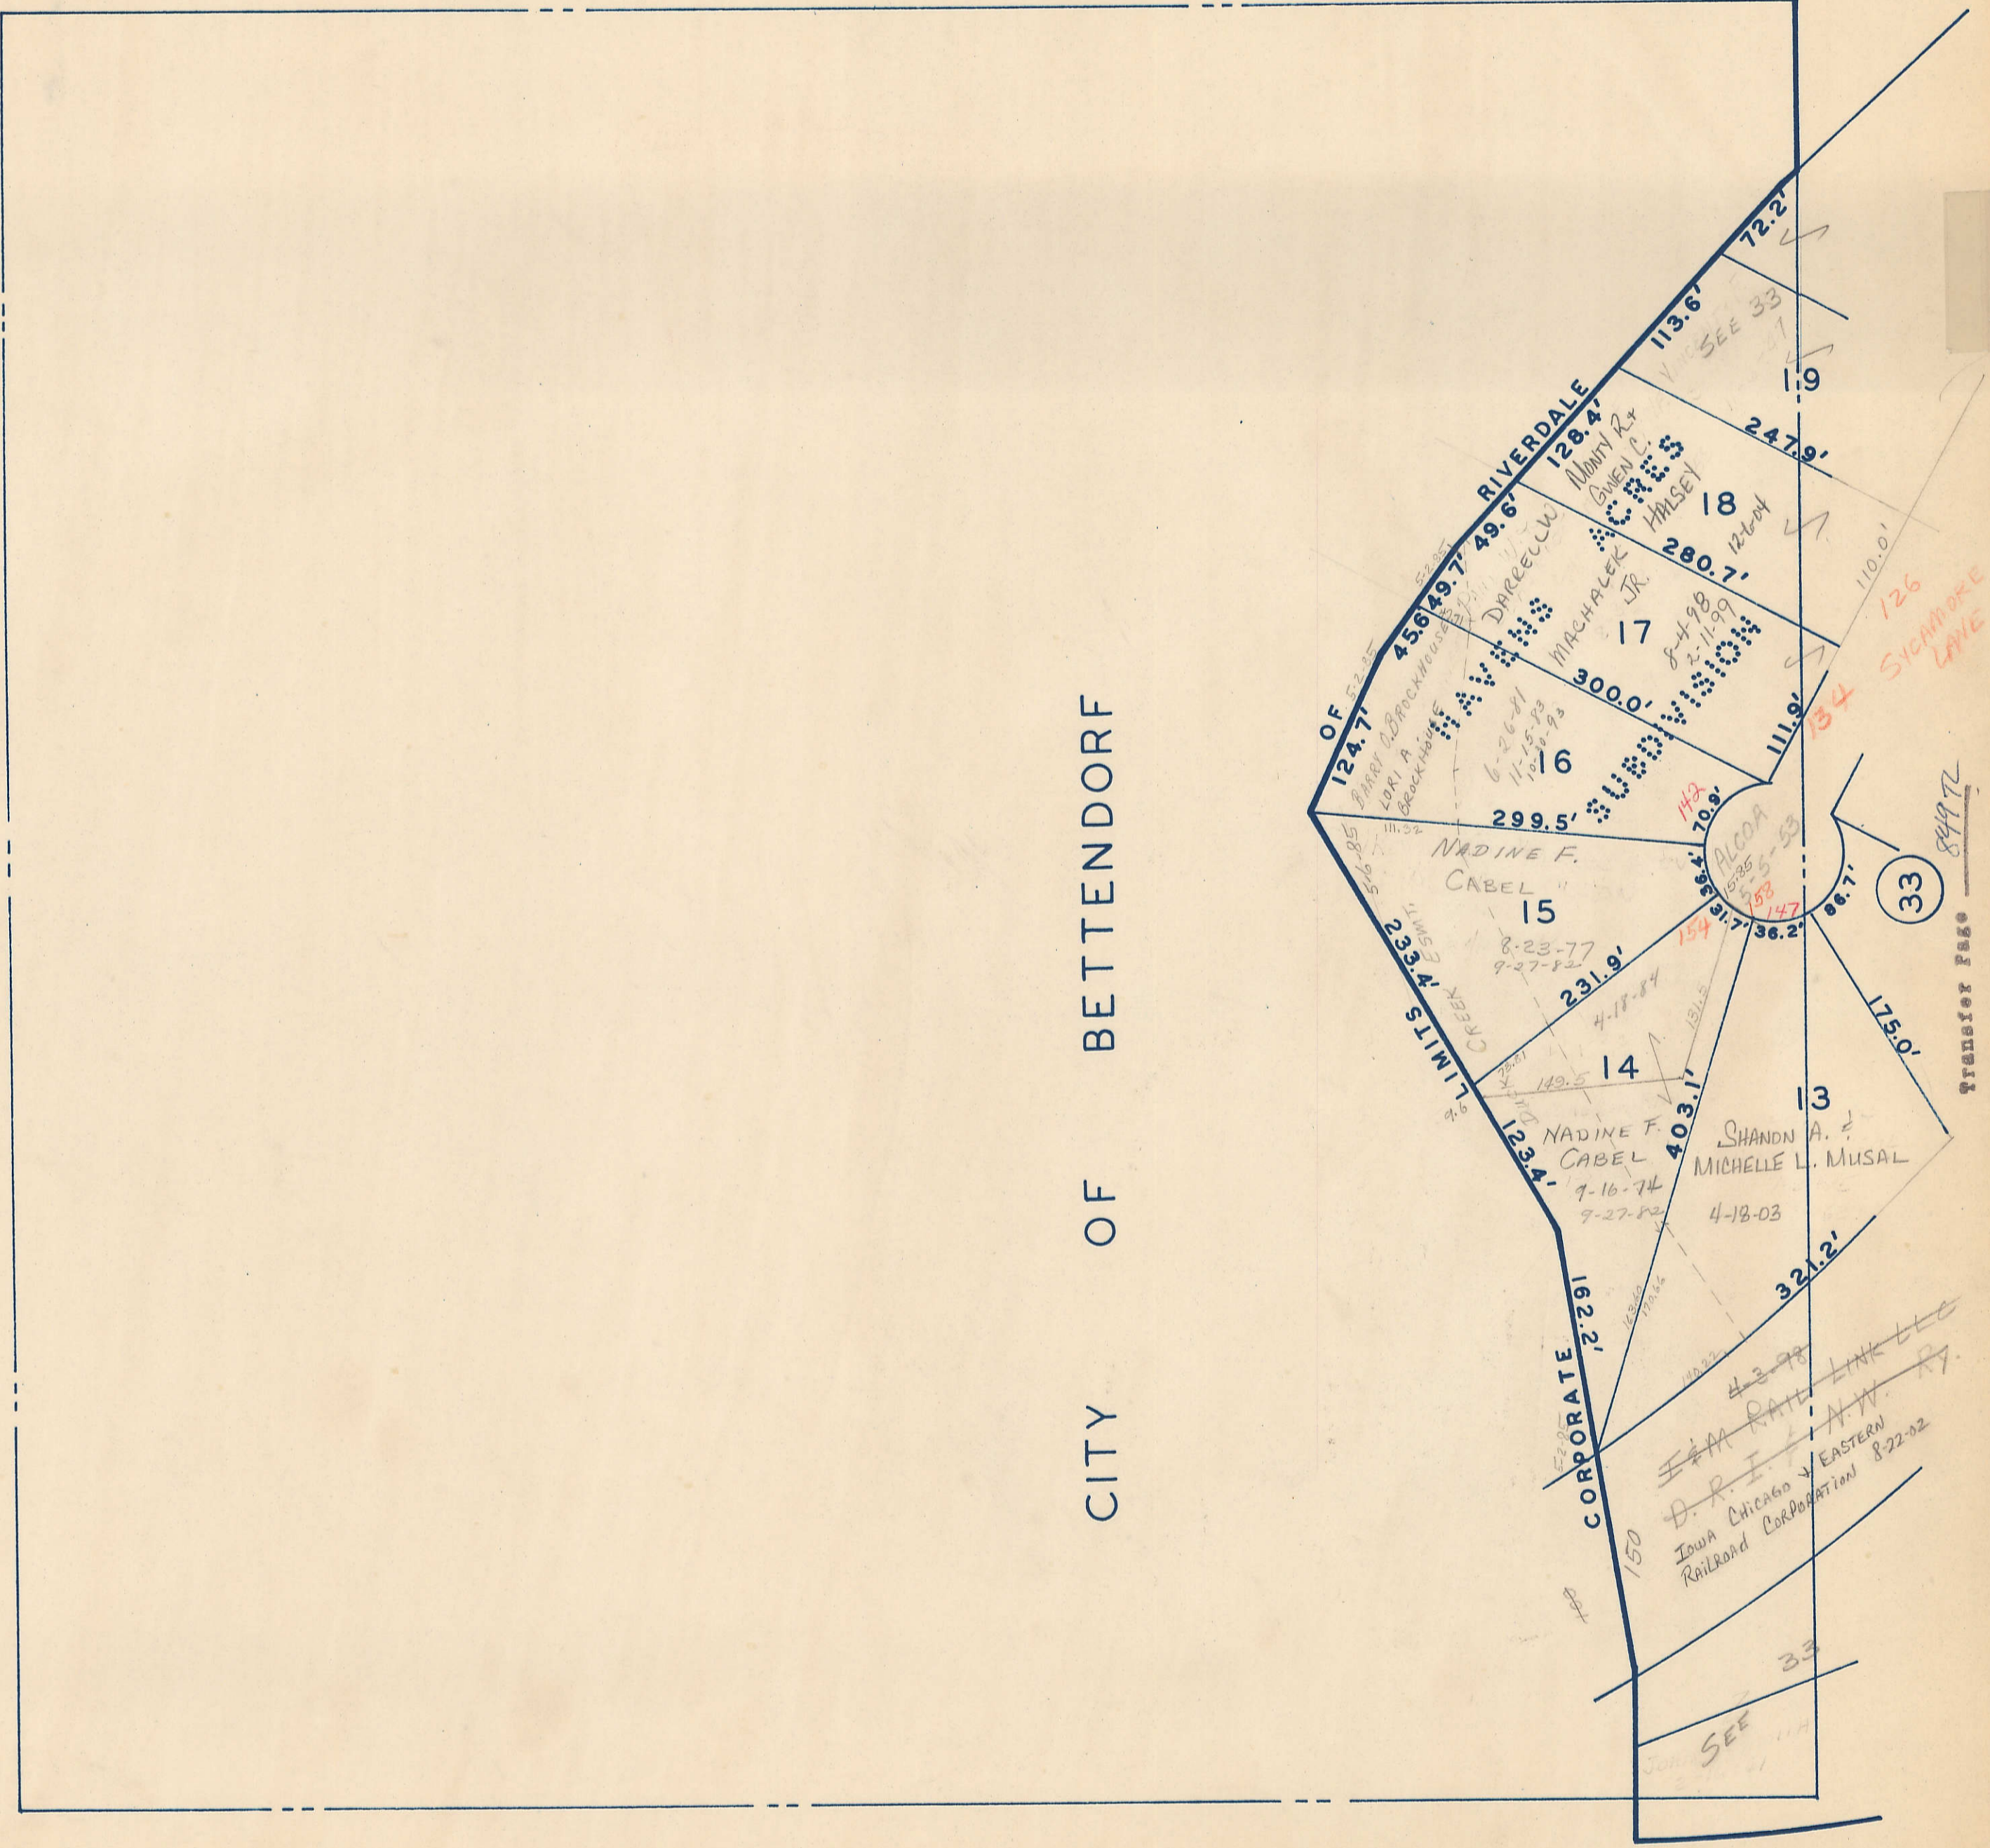

~~Iowa Chicago & Eastern Railroad Corporation~~
~~D.R.I. & N.W. Ry.~~
~~F&M RAIL LINK L.L.C.~~
4-3-98

SEE
33

Transfer Page 84972