


53 SEC. 23

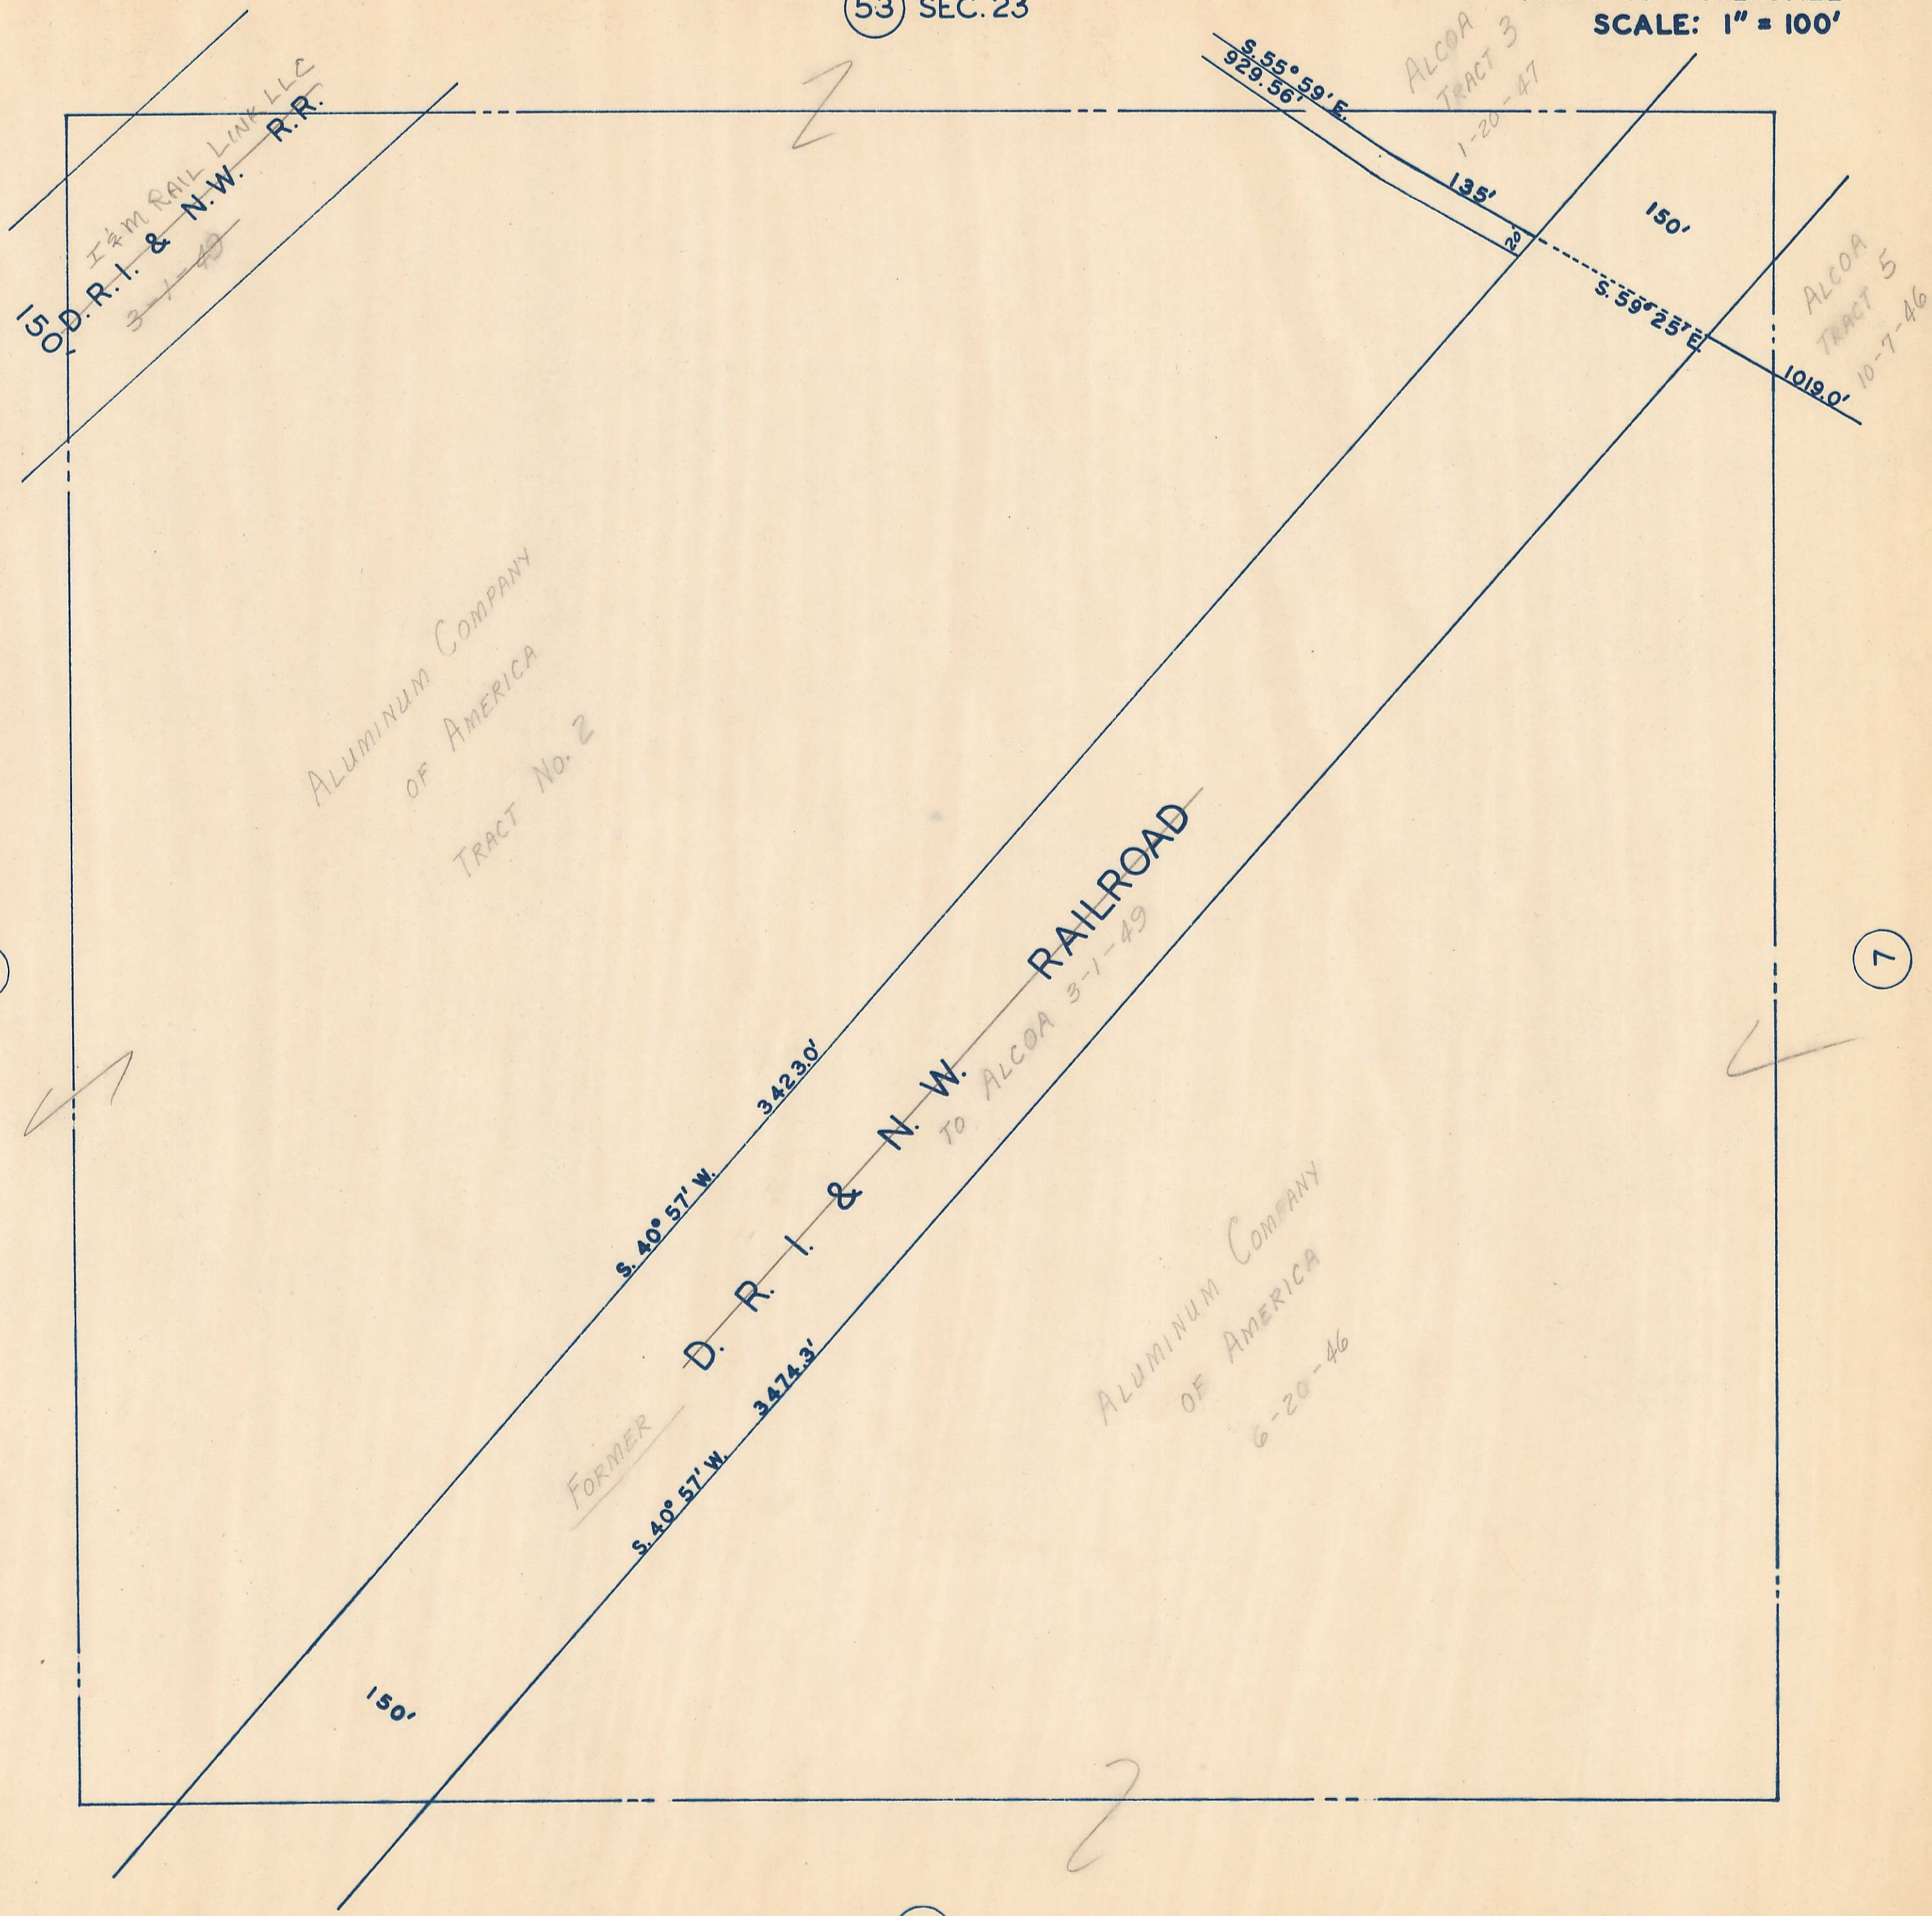

3

7

21