


TOWN OF PANORAMA PARK, IOWA

PART OF SECTIONS 13, 14, 24

T-78 N., R-4 E., 5TH P.M.

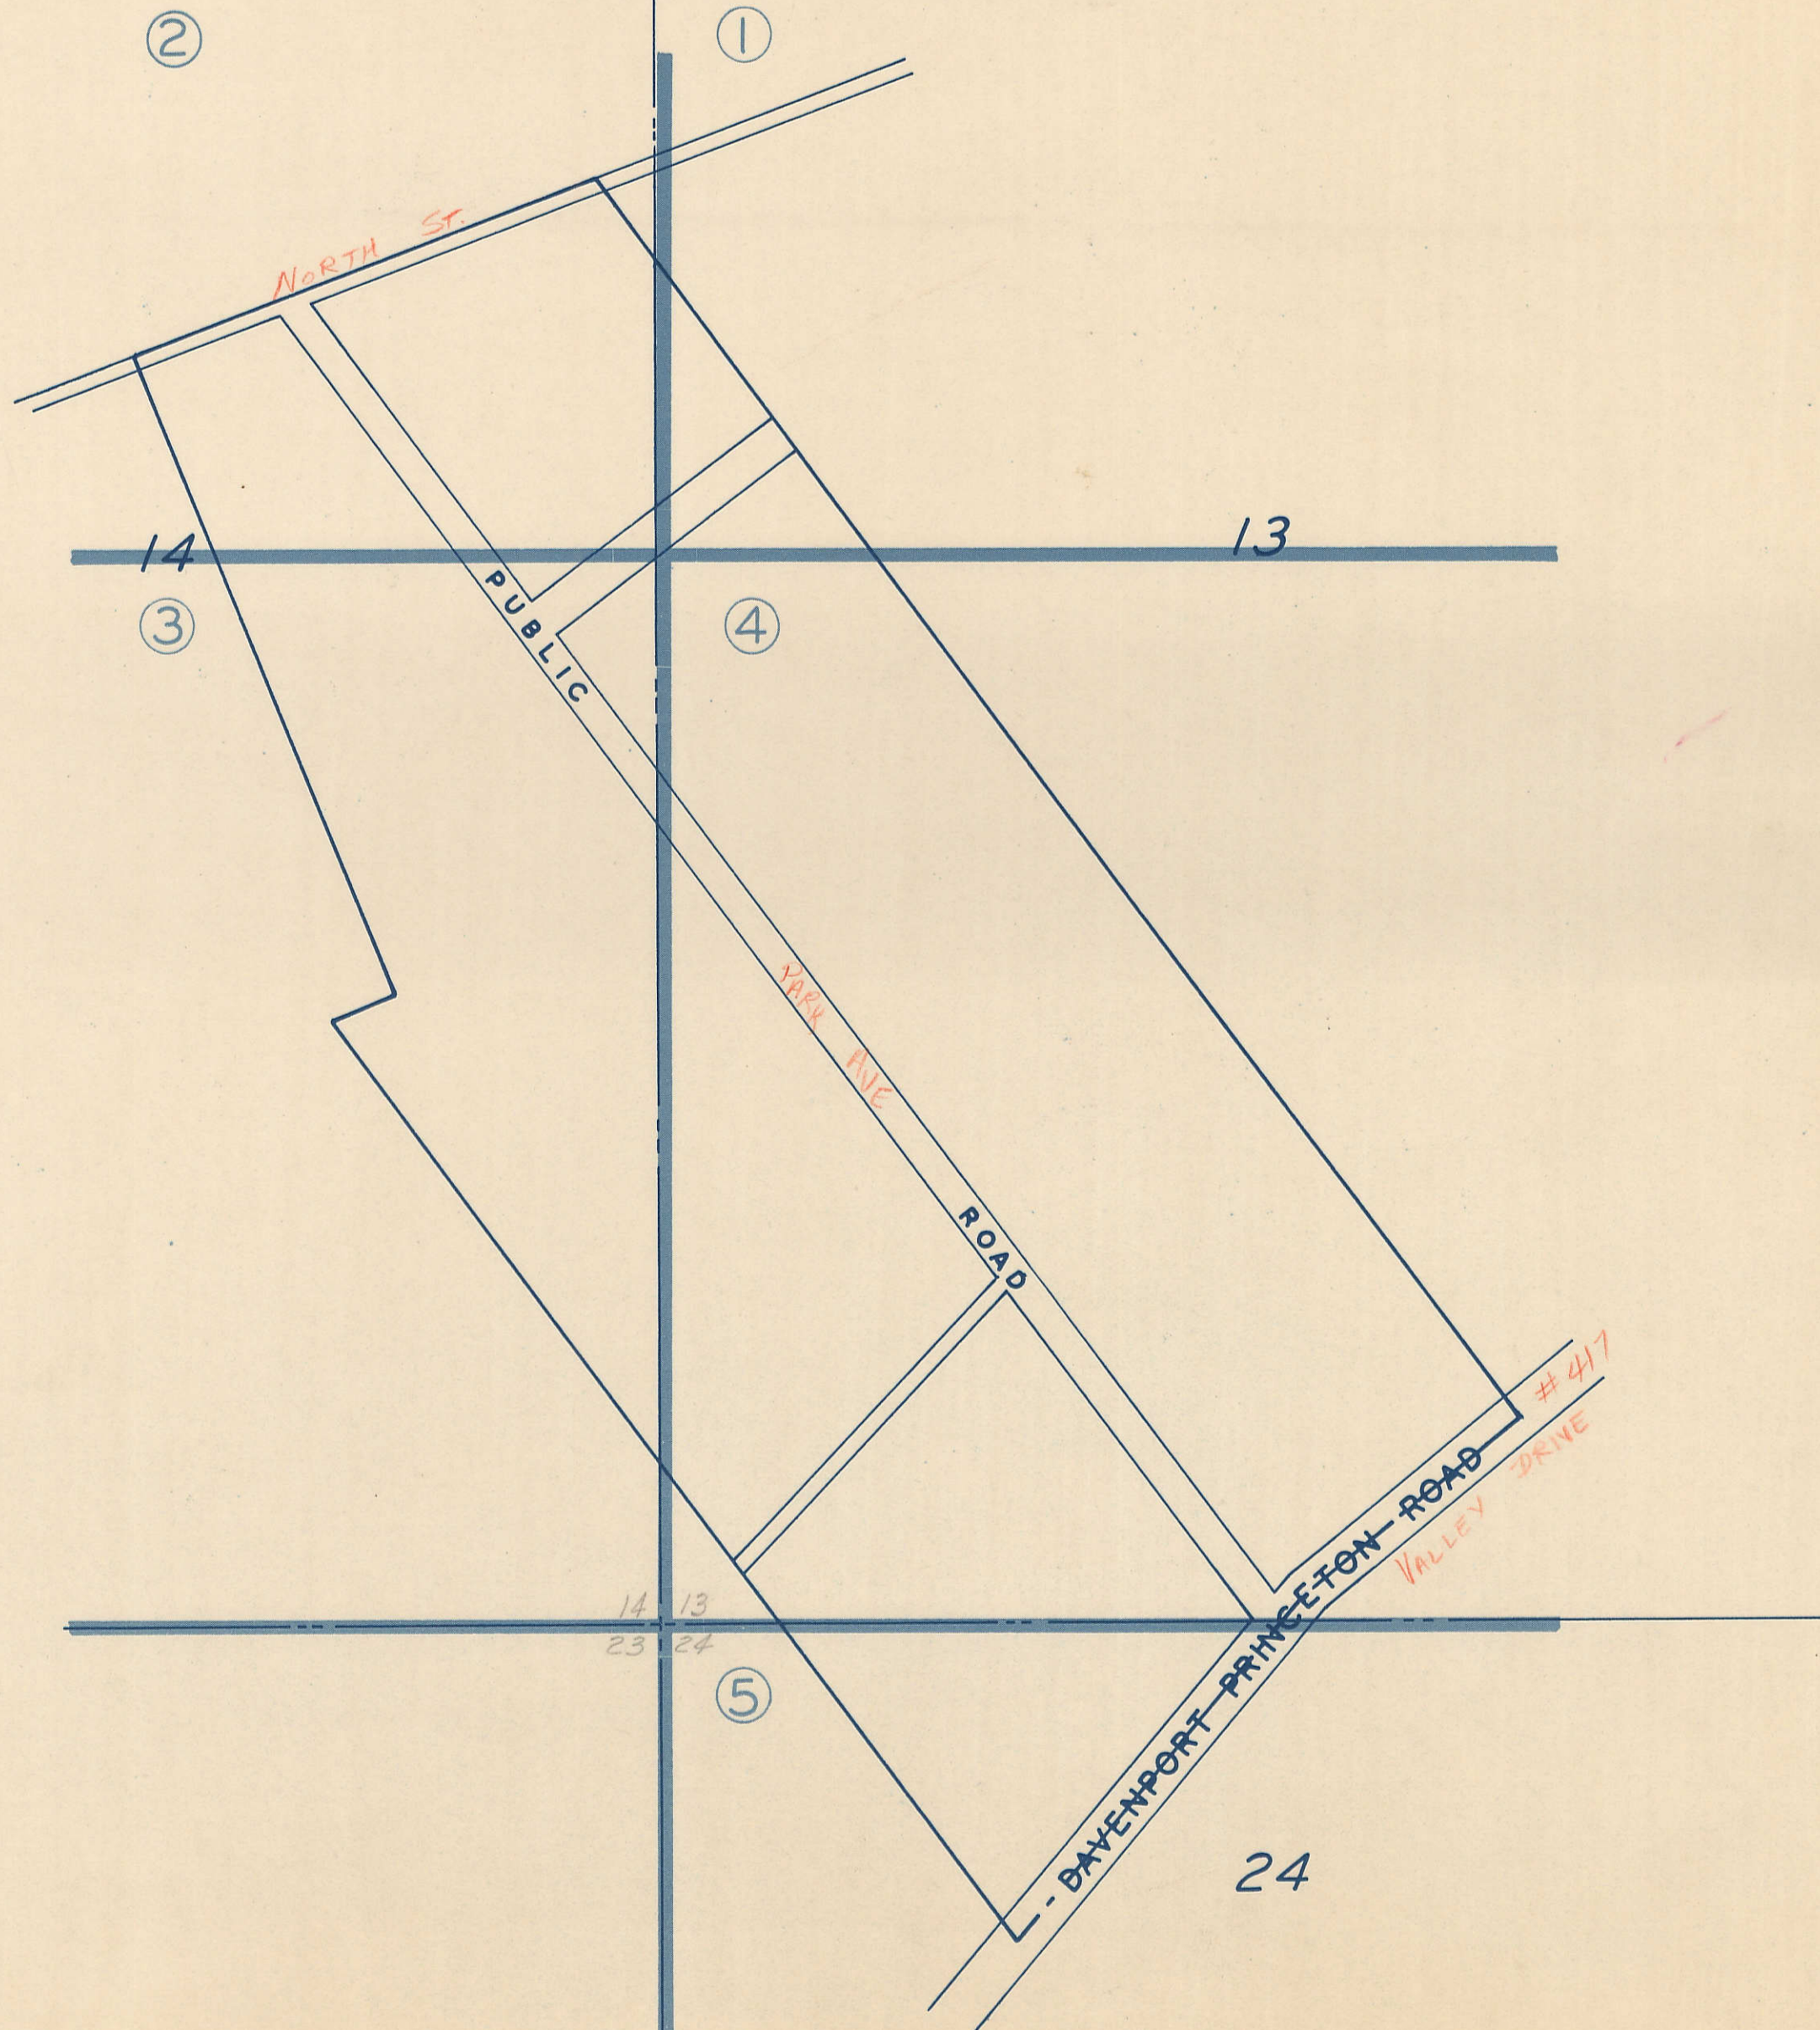

NOTE: PAGE NUMBERS ARE CIRCLED.

Panorama Park