Transfer Page 430 LANDS

S 1/2, E 1/2, NW 1/4 FRACTIONAL SECTION 6-79-3
SCALE: 1" = 100'

6

E 1/2 FRAC. NW 1/4

DOROTHY E. MARTEN
3-9-89

6

6

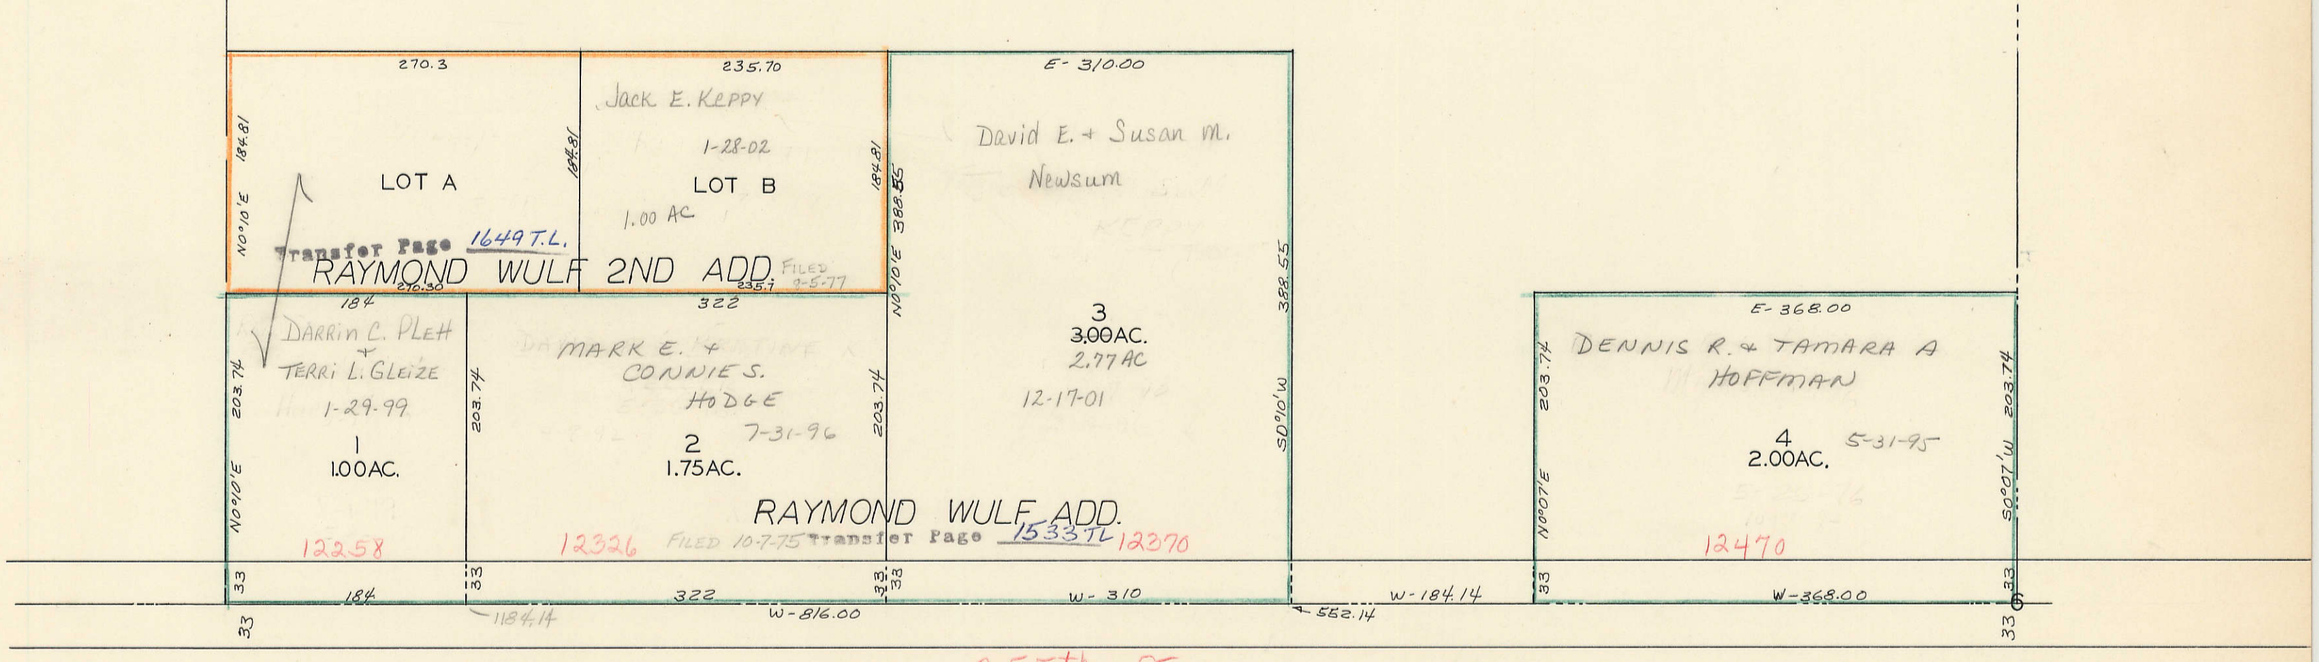

6